
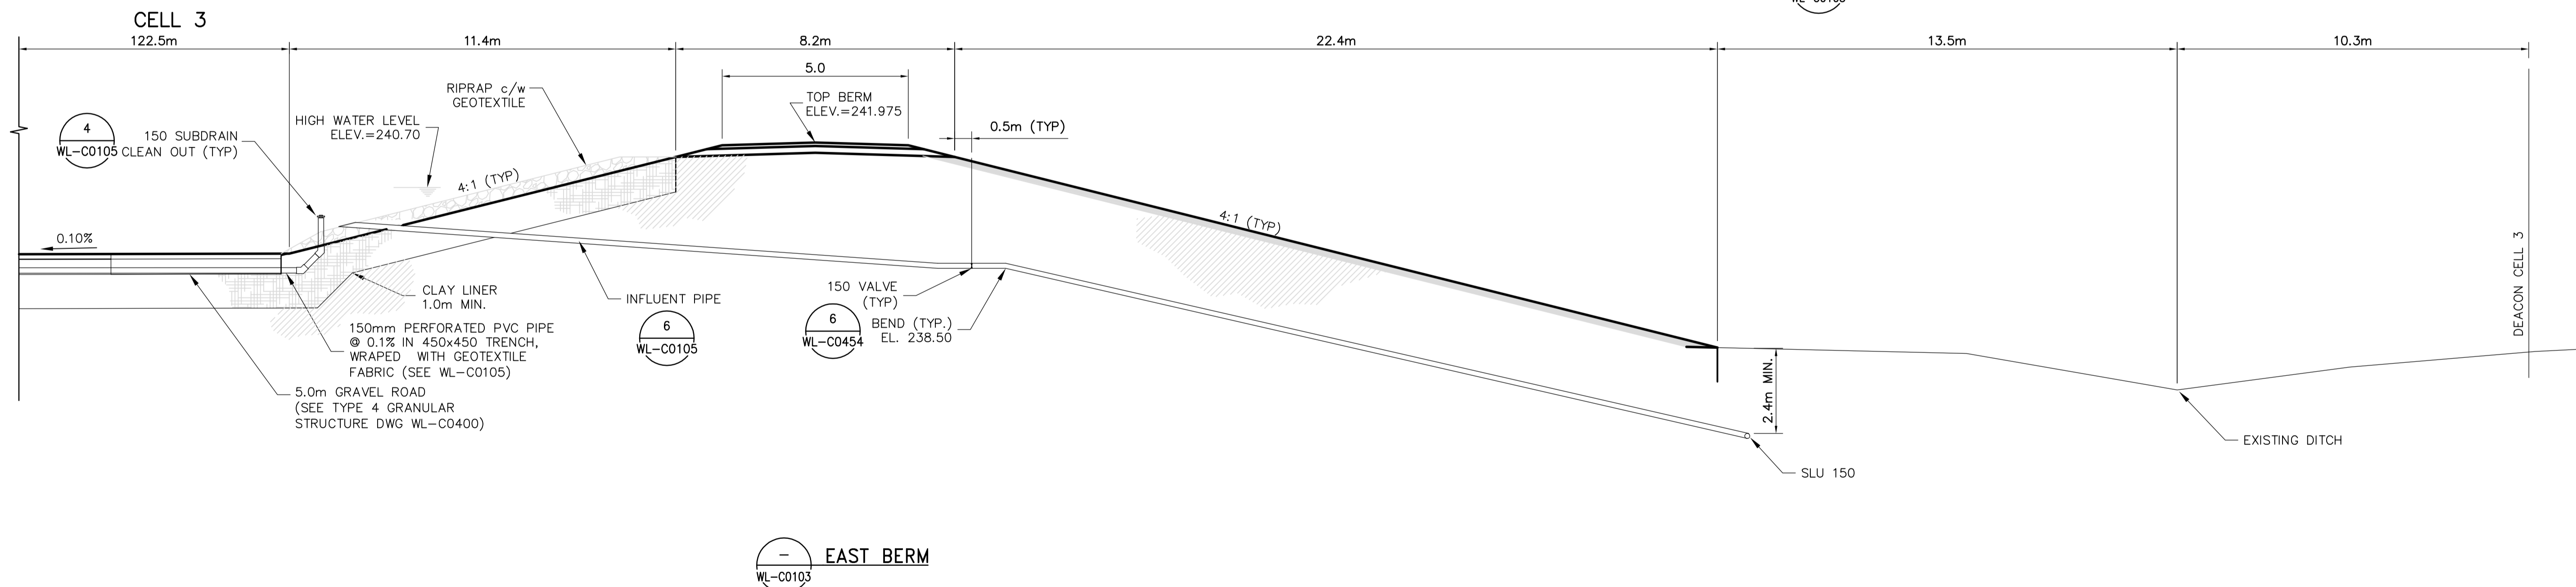


- LEGEND**
- TOPSOIL MIN. 75mm THICK
 - EXCAVATED AND COMPACTED TO 95% OF MAX. DRY DENSITY HIGH PLASTIC CLAY LINER
 - EXCAVATED AND COMPACTED TO 95% OF MAX. DRY DENSITY HIGH PLASTIC CLAY AS PER CITY OF WINNIPEG STANDARD CONSTRUCTION SPECIFICATION CW 3170-93
 - RIPRAP

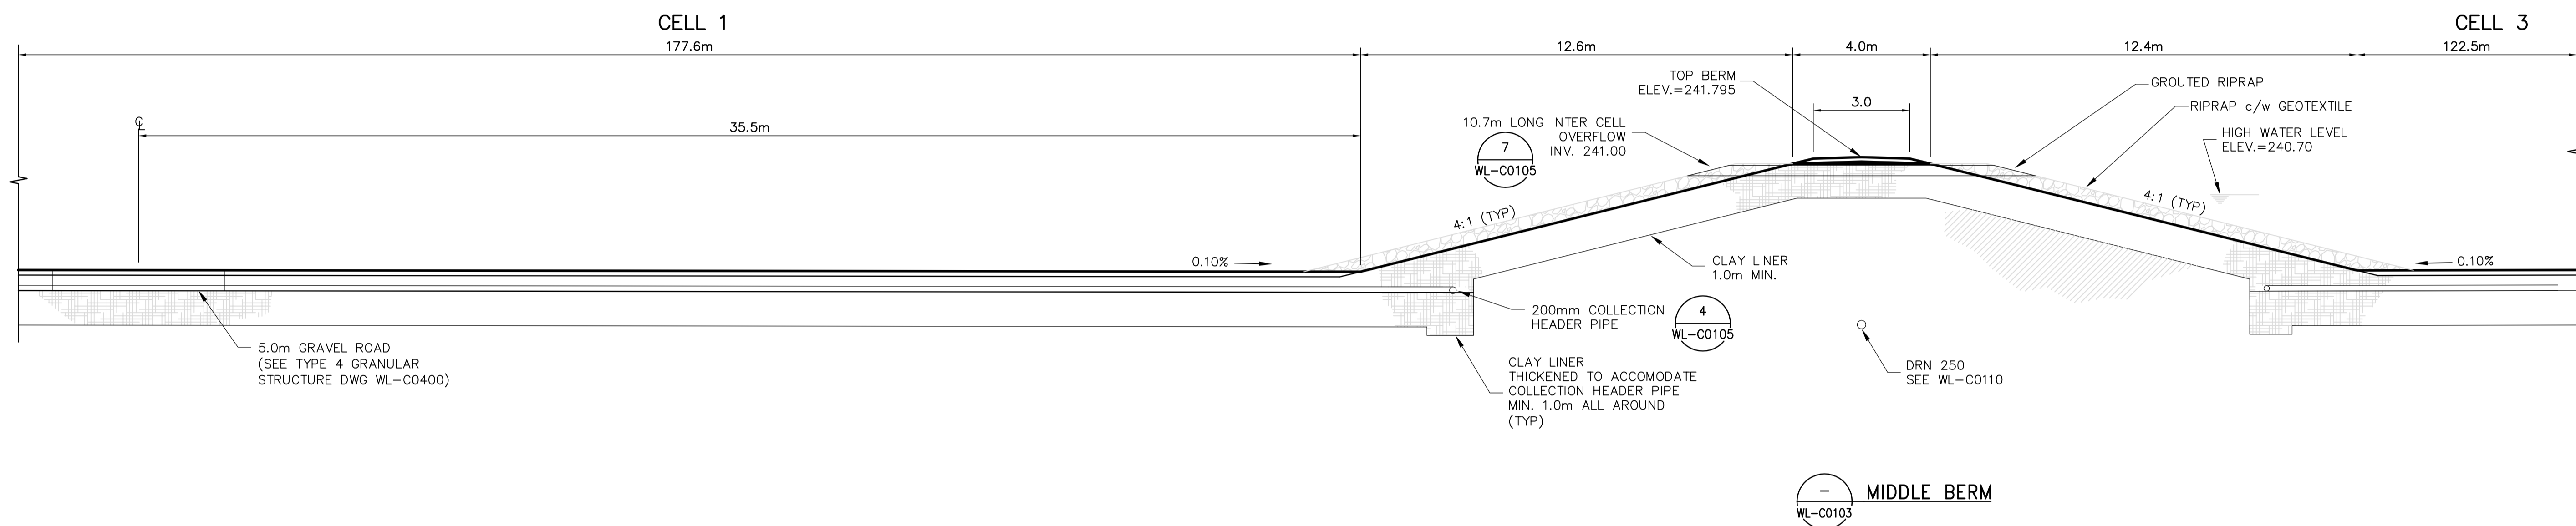

B SECTION
N.T.S.

AECOM

As of January 3, 2009, EarthTech became AECOM Canada Ltd.

AECOM AS-CONSTRUCTED

SIG..... DATE.....

 Certificate of Authorization AECOM Canada Ltd. Original dated on: No. 4671 Date: 2006/03/07	 Frederickson Cooper ARCHITECTS				ENGINEER'S SEAL ORIGINAL SIGNED BY S.R. BILEVICIUS 2006/03/07		 THE CITY OF WINNIPEG WATER AND WASTE DEPARTMENT ENGINEERING DIVISION	
	DESIGNED BY: SM		CHECKED BY: SRB		CITY FILE NUMBER		SHEET OF	
	DRAWN BY: JBC		APPROVED BY: DJT					
	SCALE: N.T.S.		RELEASED FOR CONSTRUCTION BY: R. SOROKOWSKI		CONSULTANT DRAWING NO. WL-C0202		CITY DRAWING NUMBER 1-0601L-C0013-002-03	
NO. REVISIONS		DATE BY		CIVIL SECTIONS SHEET 2				