


| REVISIONS |        |         |          |
|-----------|--------|---------|----------|
| NO.       | BY     | DATE    | REF.     |
| 1.        | R.D.M. | 31-7-92 | see note |
|           |        |         |          |
|           |        |         |          |
|           |        |         |          |

Note - Revision #1  
Pipe size changed from 72" to 84" Corridor to Grant

**REVISED AS CONSTRUCTED**  
 BY S.M. DATE 02-08-98  
 CHECKED BY J.K. DATE 02-2-98

**REVISED AS CONSTRUCTED**  
 BY J.B. DATE 04-15-98  
 CHECKED BY J.K. DATE 02-1-97


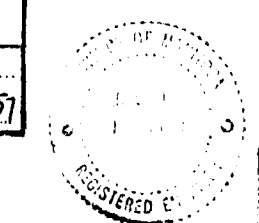


**CITY OF WINNIPEG**  
 ENGINEERING DEPARTMENT  
 W. D. HURST, CITY ENGINEER  
 J. S. TAUNTON, DEPUTY CITY ENGINEER

TITLE: PLAN & PROFILE OF TRUNK SEWER IN DONCASTER ST FROM ASSINIBOINE RIVER TO THE WESTERLY PROJECTION OF THE SOUTH LINE OF GRANT 1 VE. ALTERNATE B-72" & B-84" SEWER

DESIGNED BY: R.R. MUNN DATE: 1-2-52  
 CHECKED BY: J.K. DATE: 12-1-57  
 APPROVED: [Signature]

606 p.55, 648 p.58, 646 p.24  
 1" = 40' Hor. 1" = 8' Ver. 4639

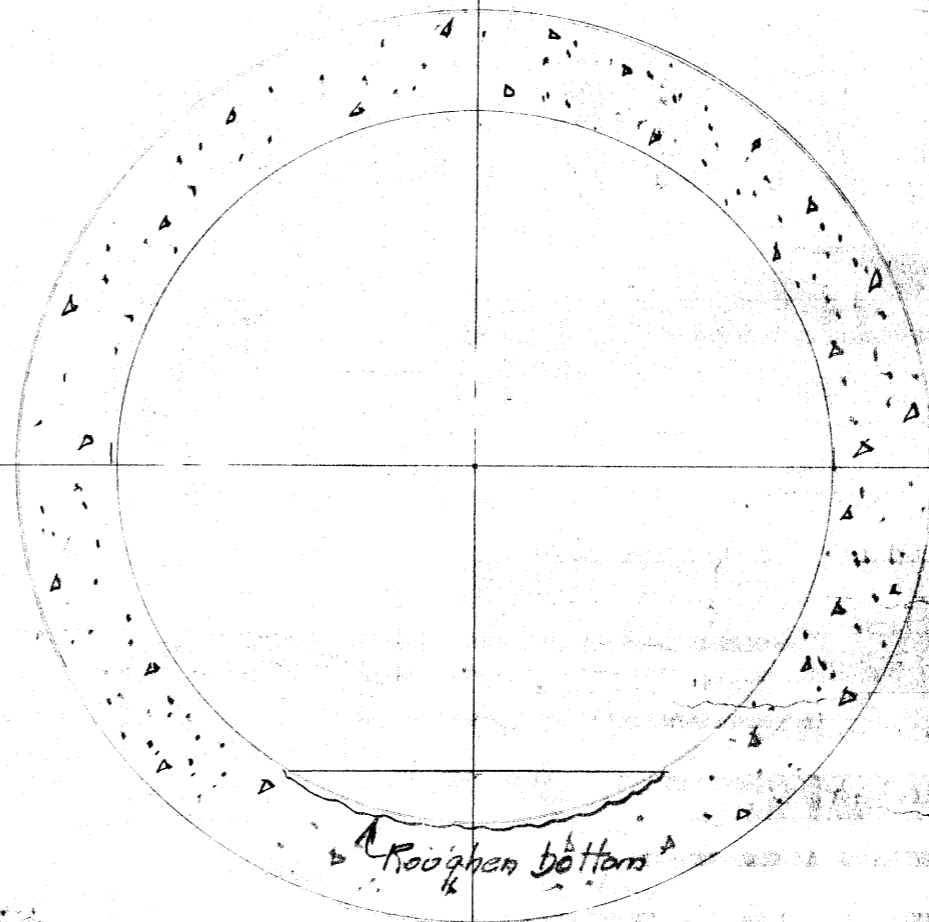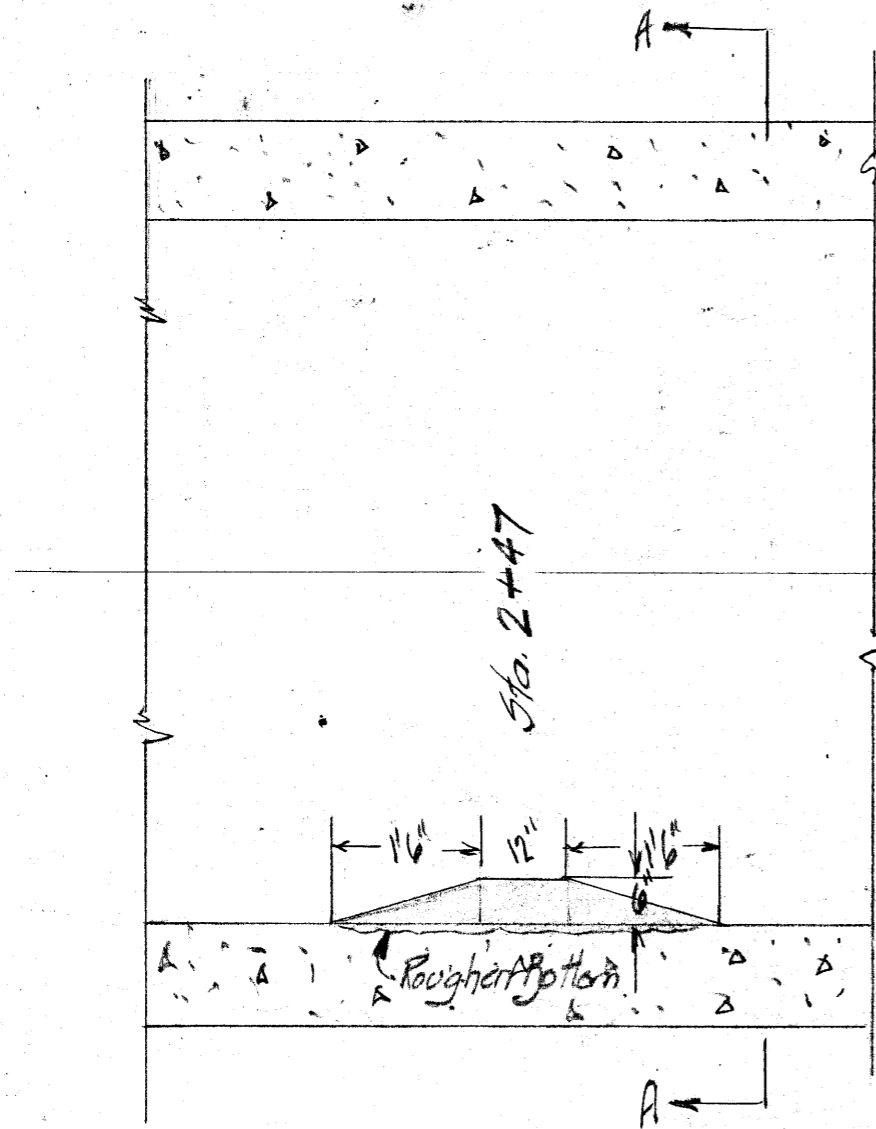

Section A-A

14693

Weir in  
Dorchester Sewer.

CITY OF WINNIPEG  
ENGINEERING DEPARTMENT  
C. B. HURST CITY ENGINEER  
S. S. TAYLOR

DRAWN BY *W.B.* DATE *Mar. 9. 53*  
TRACED BY  
CHECKED BY *J.M.*  
APPROVED *W.A.H.*

SCALE  
*1/2" = 1 foot*  
DRAWING NO.  
14693

14693