

DETAIL "A"
LIFTING LUG

COATED WITH BLACK ZINC CHROMATE PRIMER AS PER M.S.10.1


(3/8" x 114")
10mm x 2896mm

LIFTING LUG
(3/4" φ)
19mm

51 (2") φ COUPLING & PLUG


STIFFENERS
13 x 203
(1/2" x 8")

(1") Typical
25mm
WITH WIRE MESH REINFORCING
51 x 102^{2.7} @ 9.5 (2 x 4¹² / 12 @ 3/8")

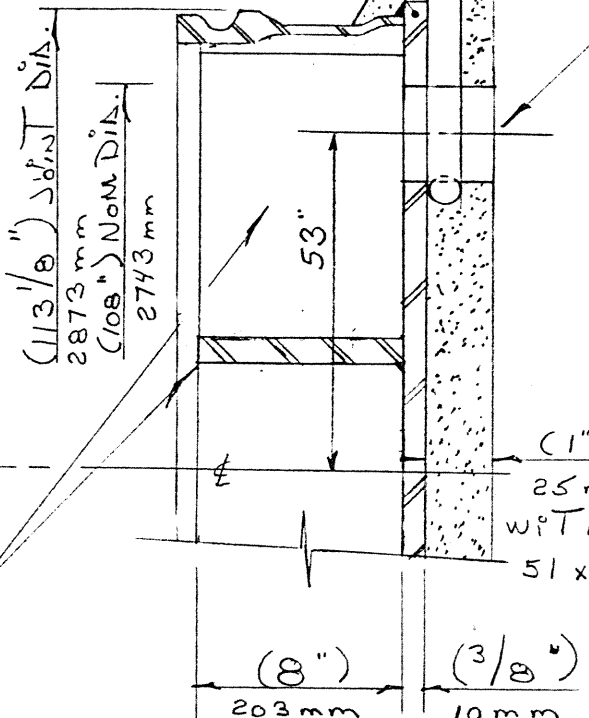

DETAIL "B"

AS BUILT

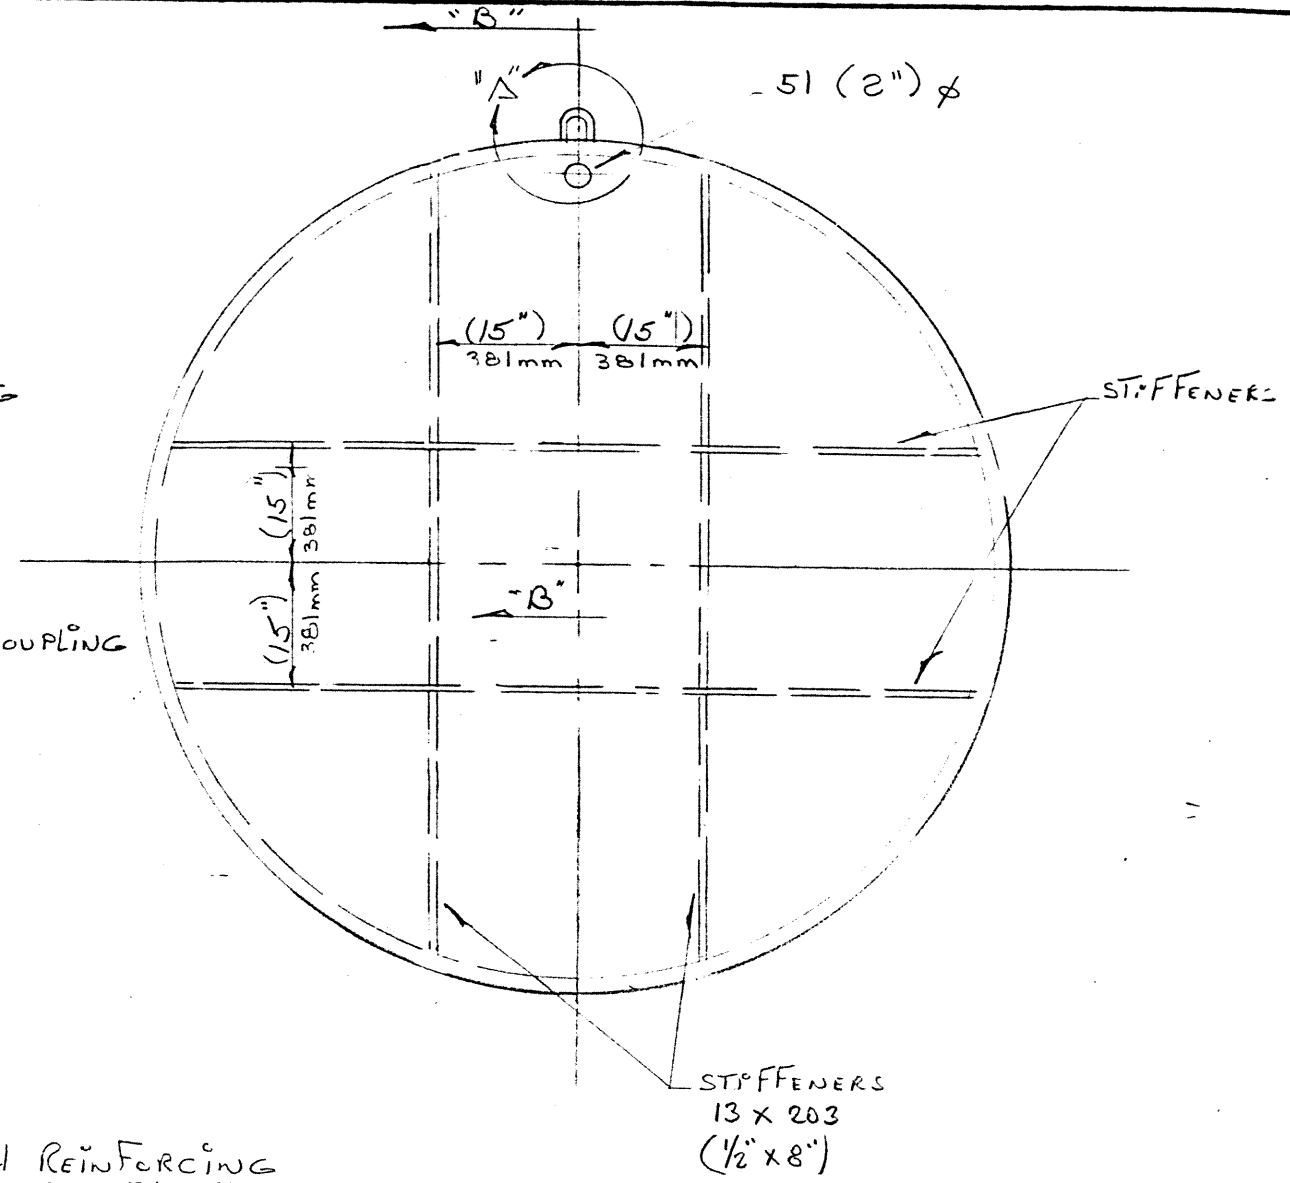

NOTE: USE TYPE V CEMENT OUTSIDE & COVER ALL EXPOSED INSIDE STEEL WITH BLACK ZINC CHROMATE PRIMER AS PER M.S.10.1.

DATE	NO	REVISION	BY
<p>This drawing and all technical information appearing hereon are the property of CANRON INC. and must be kept in confidence by the recipient. The same may not be used or reproduced either in whole or in part without the express consent of CANRON INC., which reserves all rights of copyright.</p>			
<p>CANRON INC.</p>		<p>MICROFILMED NOV -- 1981 PIPE DIVISION</p>	
<p>CITY OF WINNIPEG</p>			<p>10819-2D-45</p>
<p>DETAIL OF MK:10</p>			<p>F-1575 45 OF 62</p>
<p>SCALE: _____</p>		<p>DATE: MARCH 8, 1979</p>	
<p>DRAWN m.D.G.</p>	<p>CHECKED C.V.</p>	<p>APPROVED [Signature]</p>	<p>PROJECT 46-S-8005</p>
			<p>DWG. REV. 45</p>