


- NOTES:
1. COORDINATE LUMINAIRE LOCATIONS WITH PIPING AND MECH. DUCTING, WHERE REQUIRED SUSPEND UNITS BELOW SUCH EQUIPMENT.
  2. UTILIZE PVC JACKETED TECK CABLE FOR ALL POWER WIRING. WIRING FOR LIGHTING, RECEPTACLES AND COMMUNICATIONS TO BE IN RIGID ALUMINUM CONDUIT.
  3. ALL CONDUIT TO BE MINIMUM 19mm# CONDUIT UNLESS OTHERWISE NOTED.

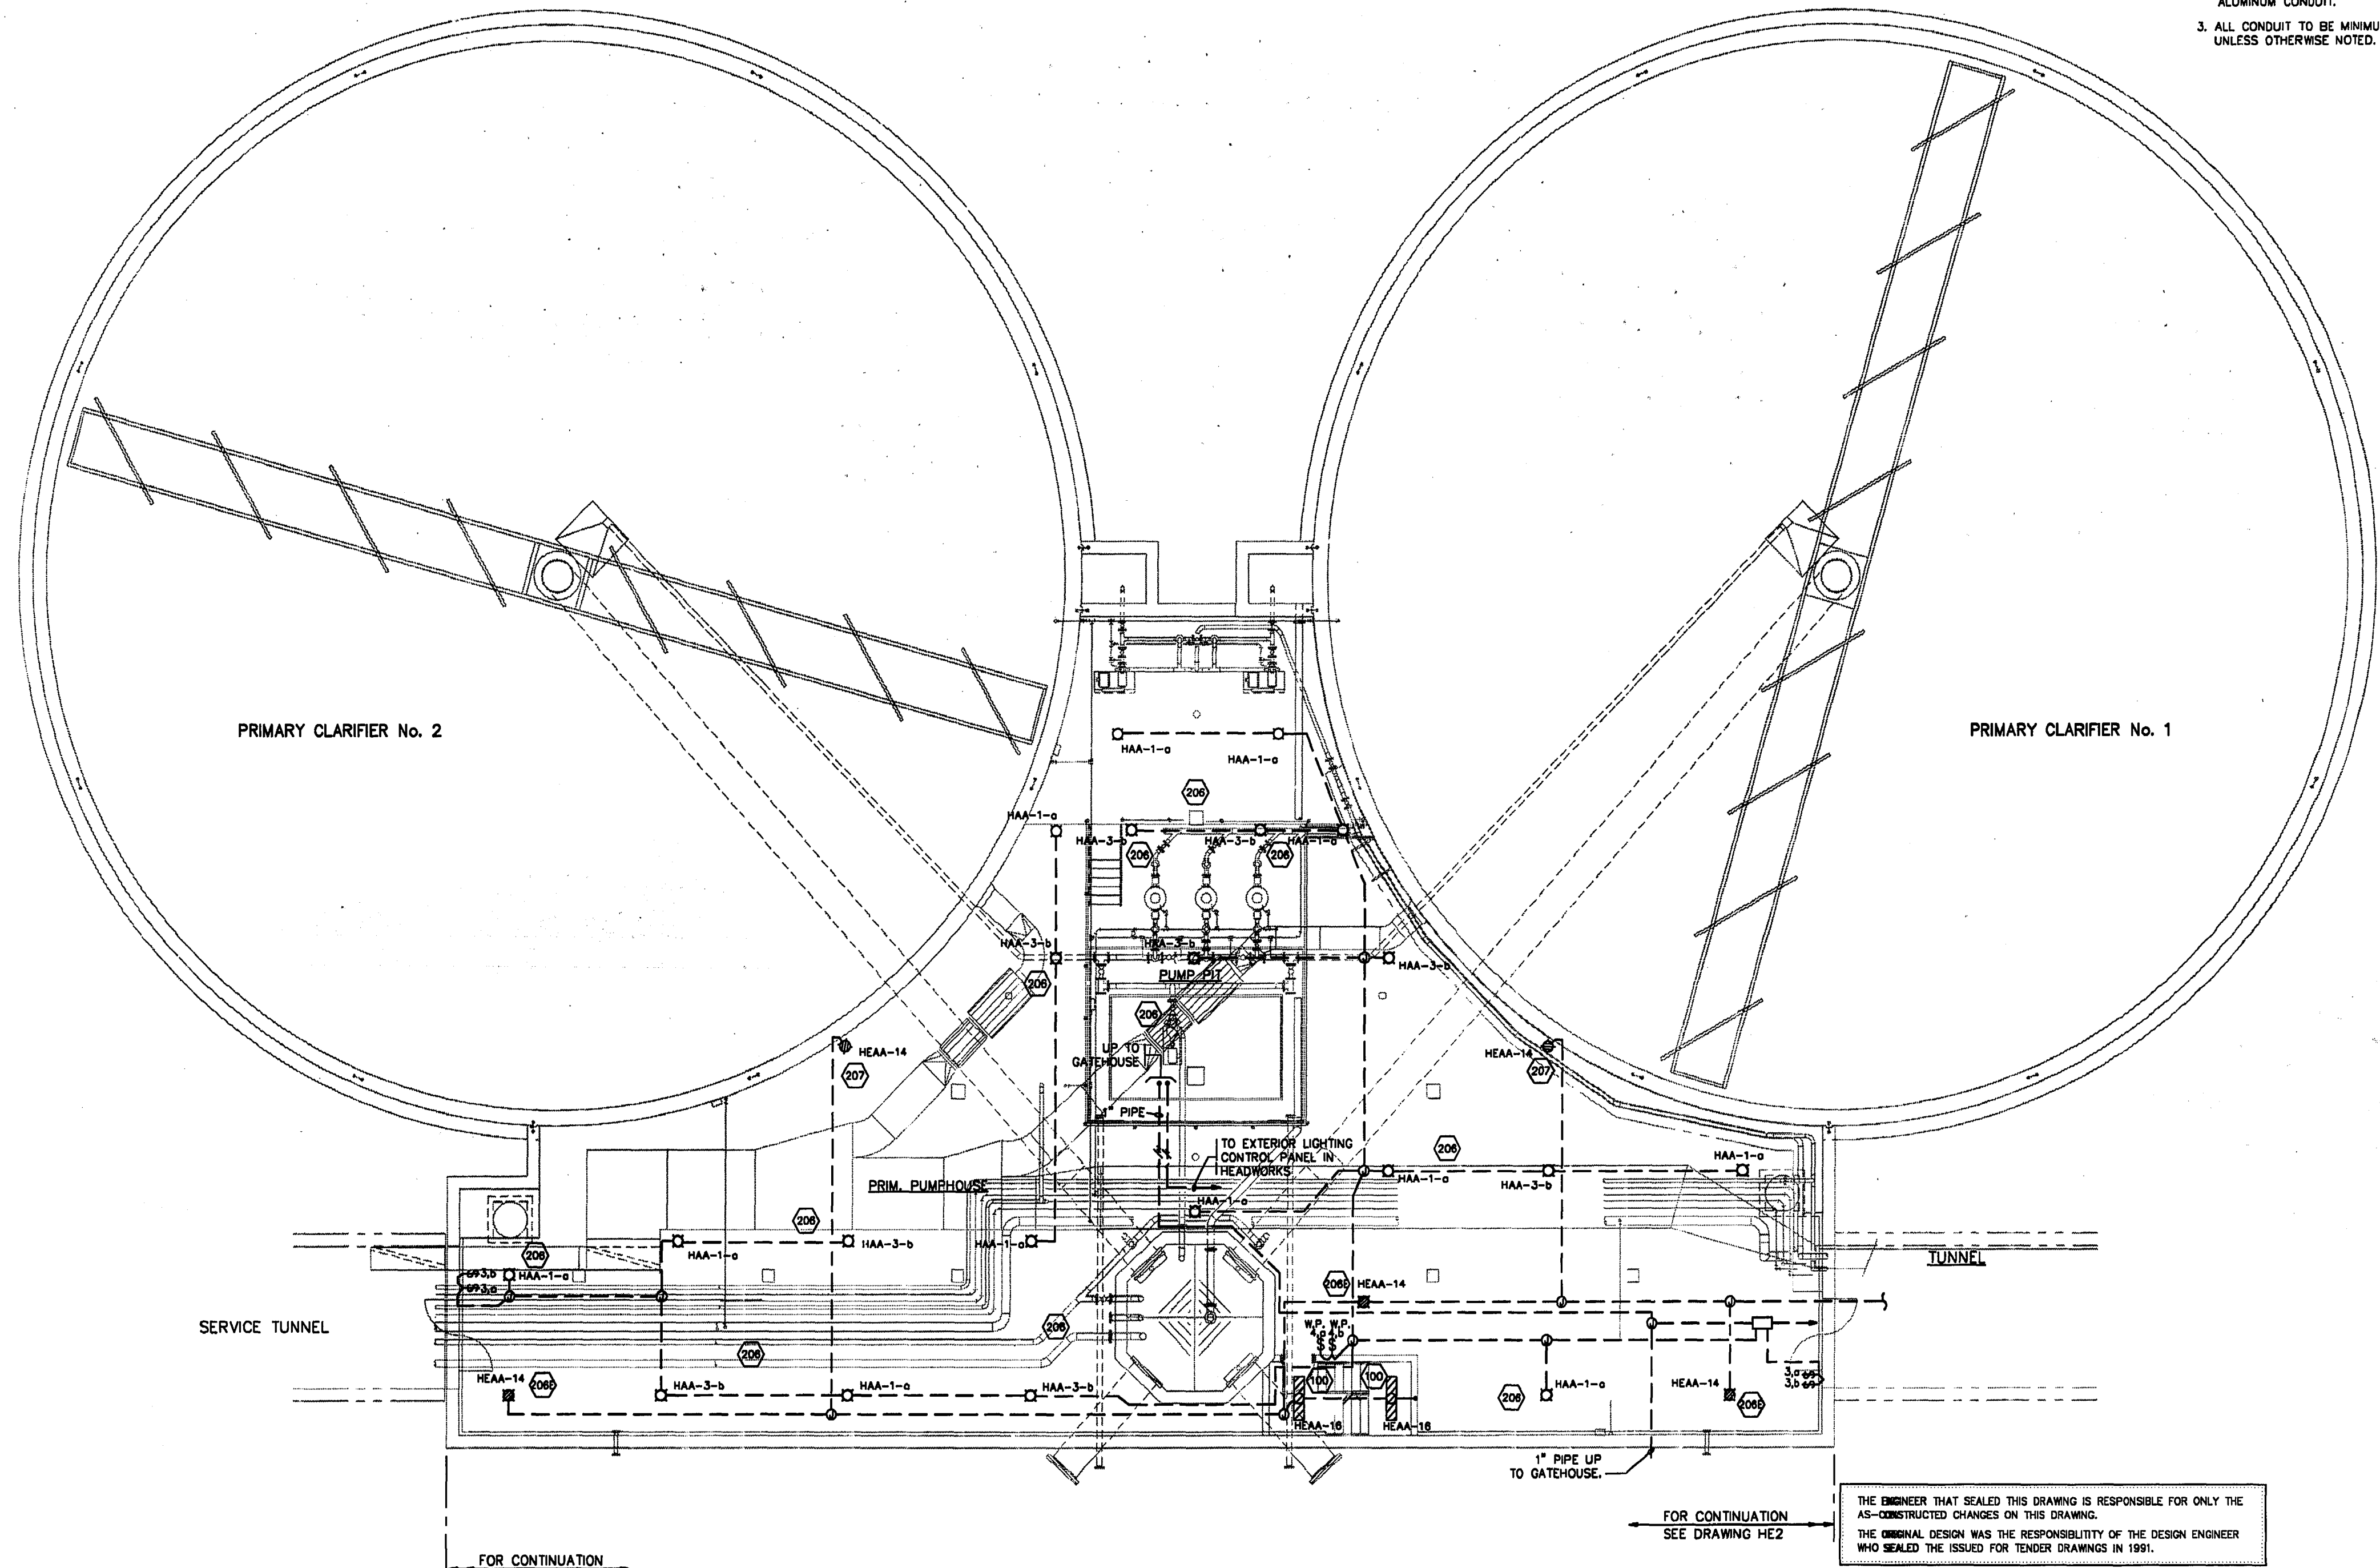

THE ENGINEER THAT SEALED THIS DRAWING IS RESPONSIBLE FOR ONLY THE AS-CONSTRUCTED CHANGES ON THIS DRAWING.  
THE ORIGINAL DESIGN WAS THE RESPONSIBILITY OF THE DESIGN ENGINEER WHO SEALED THE ISSUED FOR TENDER DRAWINGS IN 1991.

FOR CONTINUATION  
SEE DRAWING SE6


FOR CONTINUATION  
SEE DRAWING HE2

- detail symbol
- A detail number
  - B drawing where detail shown
  - C cross reference to drawing where detail taken



B.M.	69-006		
ELEV.	237.636 m		
1	AS BUILT	93/11	DE
0	ISSUED FOR TENDER		
NO. REVISIONS		DATE	BY

<b>Reid Crowther</b>		ENGINEER'S SEAL	
DESIGNED BY	LT	CHECKED BY	DJS
DRAWN BY	EJS	APPROVED BY	
HOR. SCALE:	1:100	RELEASED FOR CONSTRUCTION:	
VERTICAL:		DATE	91-06-06

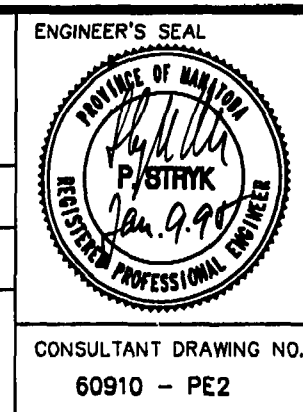

**THE CITY OF WINNIPEG**  
WORKS AND OPERATIONS DIVISION  
WATERWORKS WASTE AND DISPOSAL DEPT.

WEST END WATER POLLUTION CONTROL CENTRE  
AREA P - PRIMARY CLARIFIERS

PRIMARY PUMPHOUSE LOWER LEVEL ELECTRICAL LIGHTING LAYOUT

CITY DRAWING NUMBER  
SHEET OF  
WEP-196

CONSULTANT DRAWING NO. 60910 - PE2

REID, CROWTHER & PARTNERS LIMITED  
WINNIPEG

**AS CONSTRUCTED**

SIG. *[Signature]* DATE: *APR 23 1994*

WEPC-1  
PEL-PL1  
31-03-06

File # WS10248