


- NOTES:
1. UTILIZE PVC JACKETED TECK CABLE FOR ALL POWER WIRING. WIRING FOR LIGHTING, RECEPTACLES AND COMMUNICATIONS TO BE IN RIGID ALUMINUM CONDUIT. ALL CONDUIT TO BE 19mm MINIMUM.
 2. PROVIDE CONTACTOR & ENCLOSURE IN HEADWORKS CONTROL ROOM TO DISCONNECT POWER ON GAS DETECTION. PROVIDE WIRE AND CONDUIT TO GAS DETECTION SYSTEM.

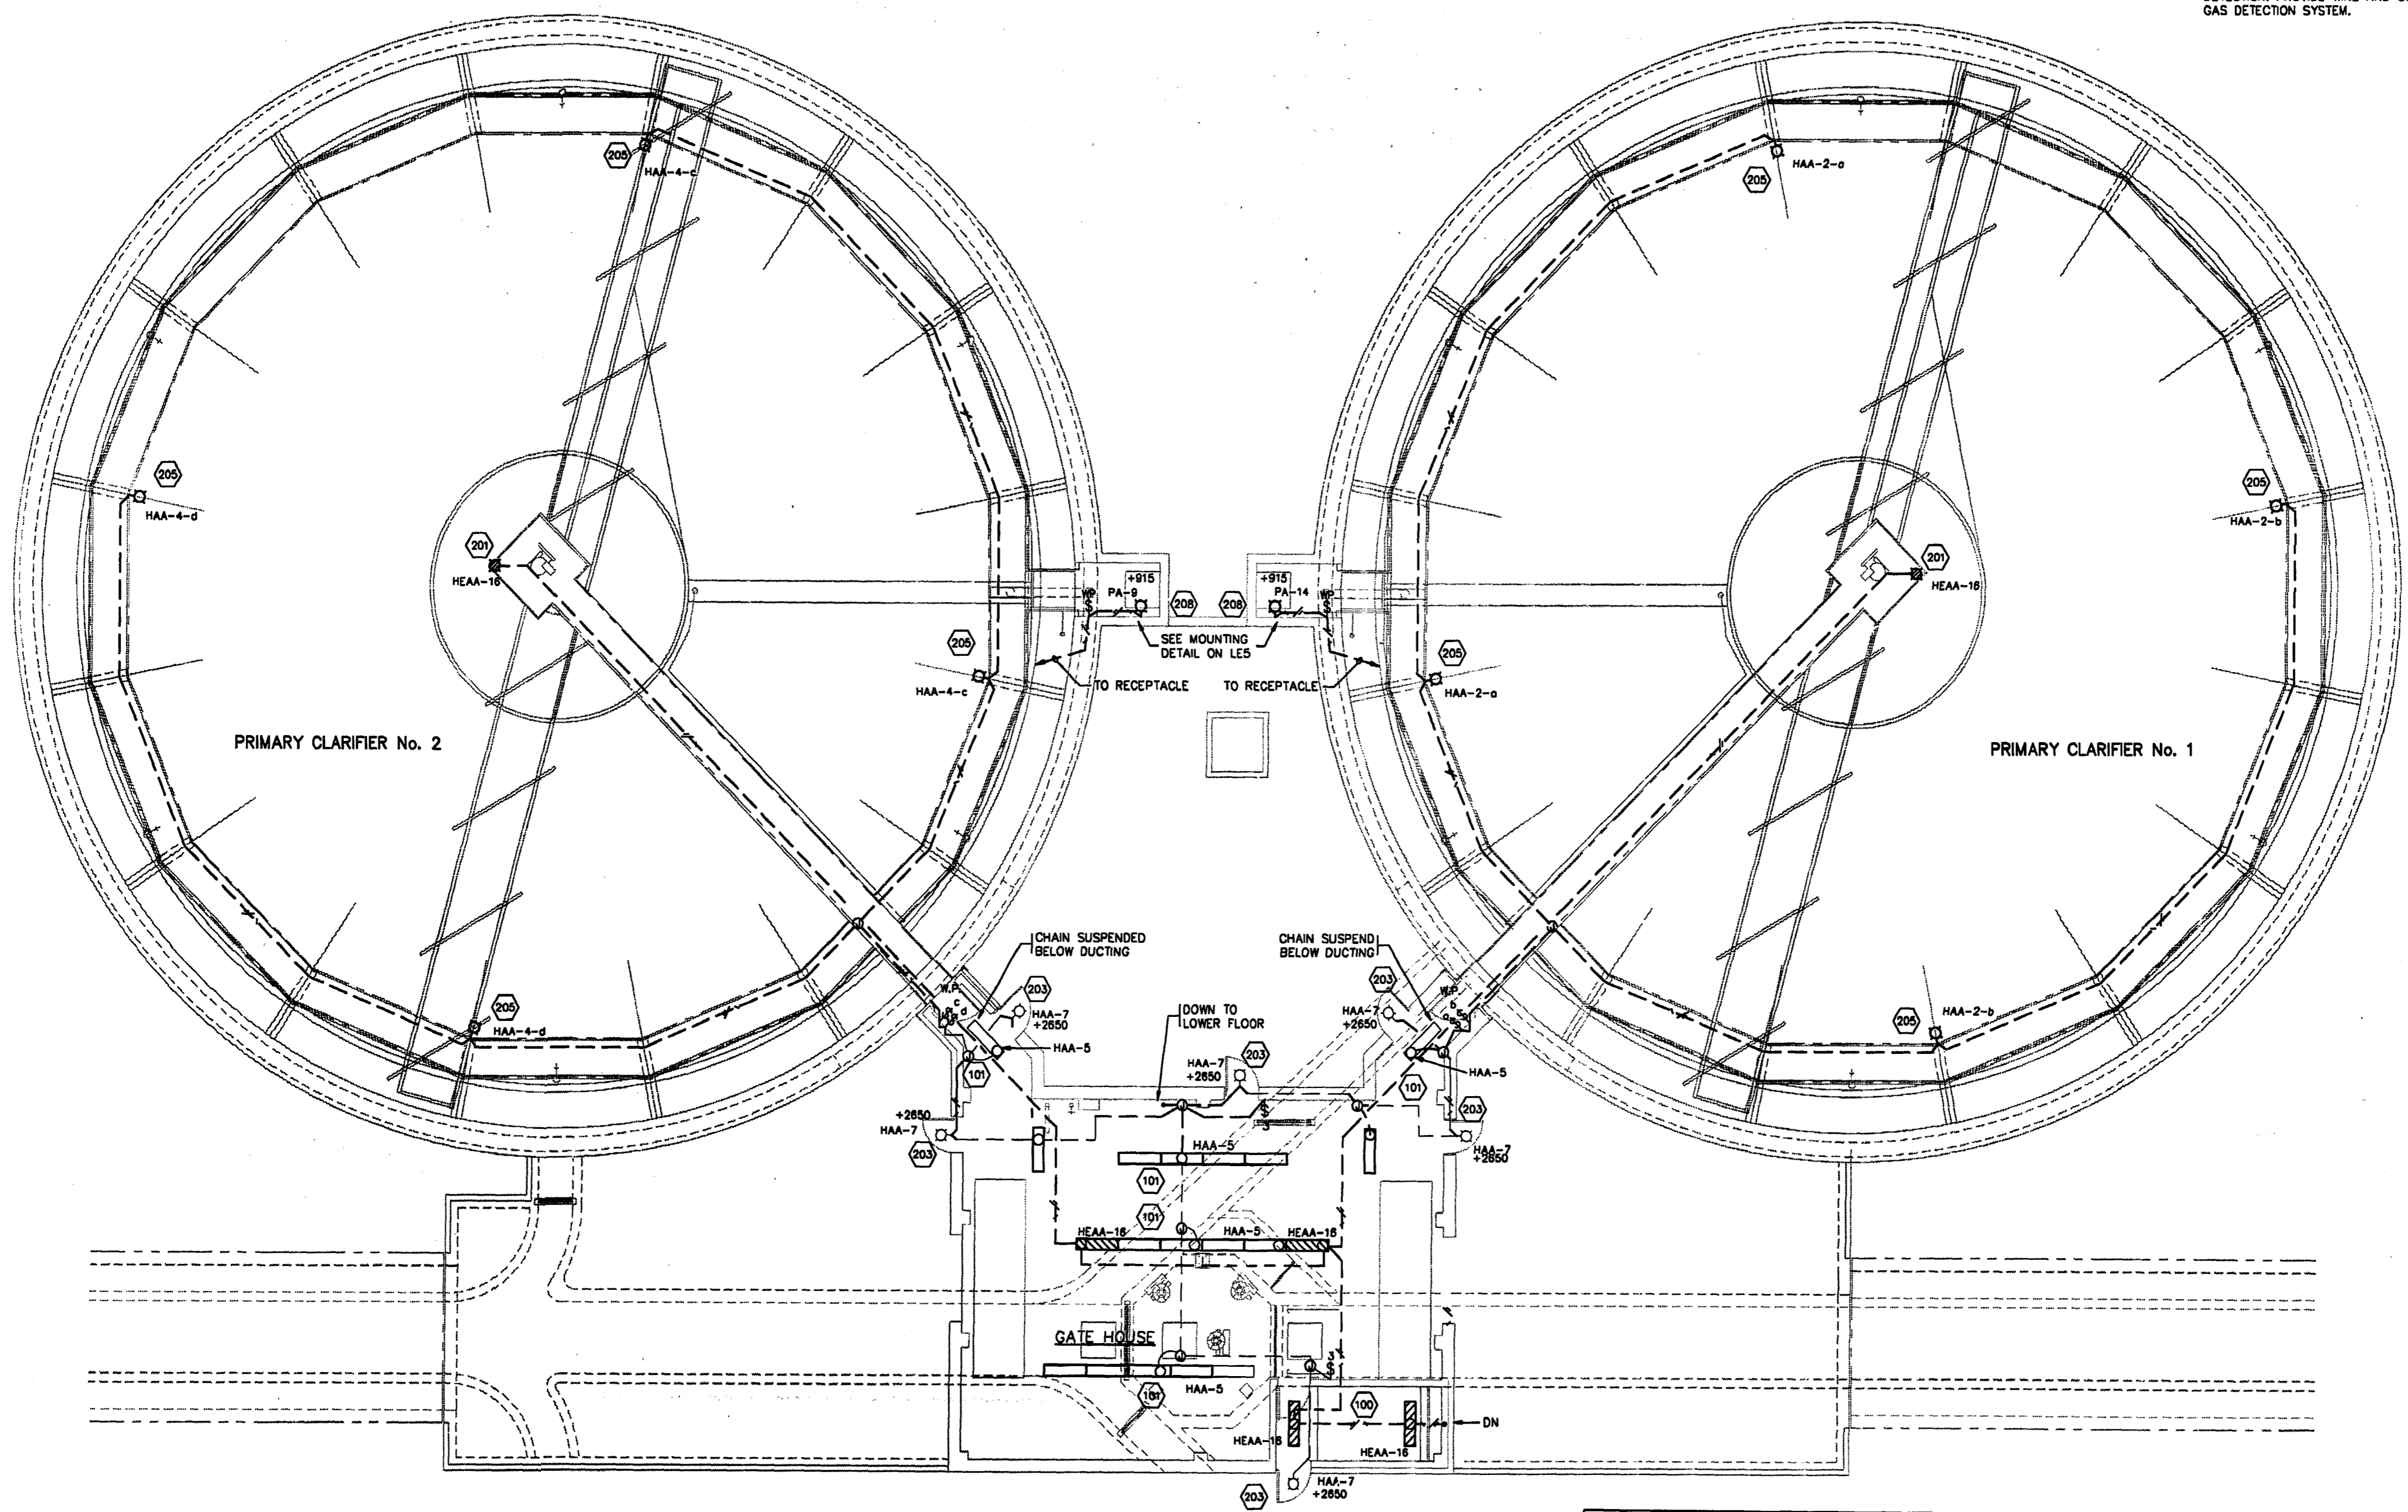

THE ENGINEER THAT SEALED THIS DRAWING IS RESPONSIBLE FOR ONLY THE AS-CONSTRUCTED CHANGES ON THIS DRAWING.
 THE ORIGINAL DESIGN WAS THE RESPONSIBILITY OF THE DESIGN ENGINEER WHO SEALED THE ISSUED FOR TENDER DRAWINGS IN 1991.

REID, CROWTHER & PARTNERS LIMITED
 WINNIPEG
AS CONSTRUCTED
 SIG. *[Signature]* DATE *Nov. 29/94*

detail symbol

A detail number
 B drawing where detail shown
 C cross reference to drawing where detail taken



B.M.	69-006
ELEV.	237.636 m
NO.	REVISIONS
1	AS BUILT 93/11 DE
0	ISSUED FOR TENDER
DATE	91-06-06

Reid Crowther

DESIGNED BY LT
 DRAWN BY EJS
 HOR. SCALE: 1:100
 VERTICAL:

CHECKED BY DJS
 APPROVED BY
 RELEASED FOR CONSTRUCTION:
 DATE

ENGINEER'S SEAL

 CONSULTANT DRAWING NO.
 60910 - PE4

THE CITY OF WINNIPEG
 WORKS AND OPERATIONS DIVISION
 WATERWORKS WASTE AND DISPOSAL DEPT.

WEST END WATER POLLUTION CONTROL CENTRE
 AREA P - PRIMARY CLARIFIERS

PRIMARY PUMPHOUSE UPPER LEVEL ELECTRICAL LIGHTING LAYOUT

CITY DRAWING NUMBER
 SHEET OF
WEP-198

File # WS 10249