


- NOTES:
1. UTILIZE PVC JACKETED TECK CABLE FOR ALL POWER WIRING. WIRING FOR LIGHTING, RECEPTACLES AND COMMUNICATIONS TO BE IN RIGID ALUMINUM CONDUIT.
 2. ALL CONDUIT TO BE MINIMUM 19mm CONDUIT UNLESS OTHERWISE NOTED.

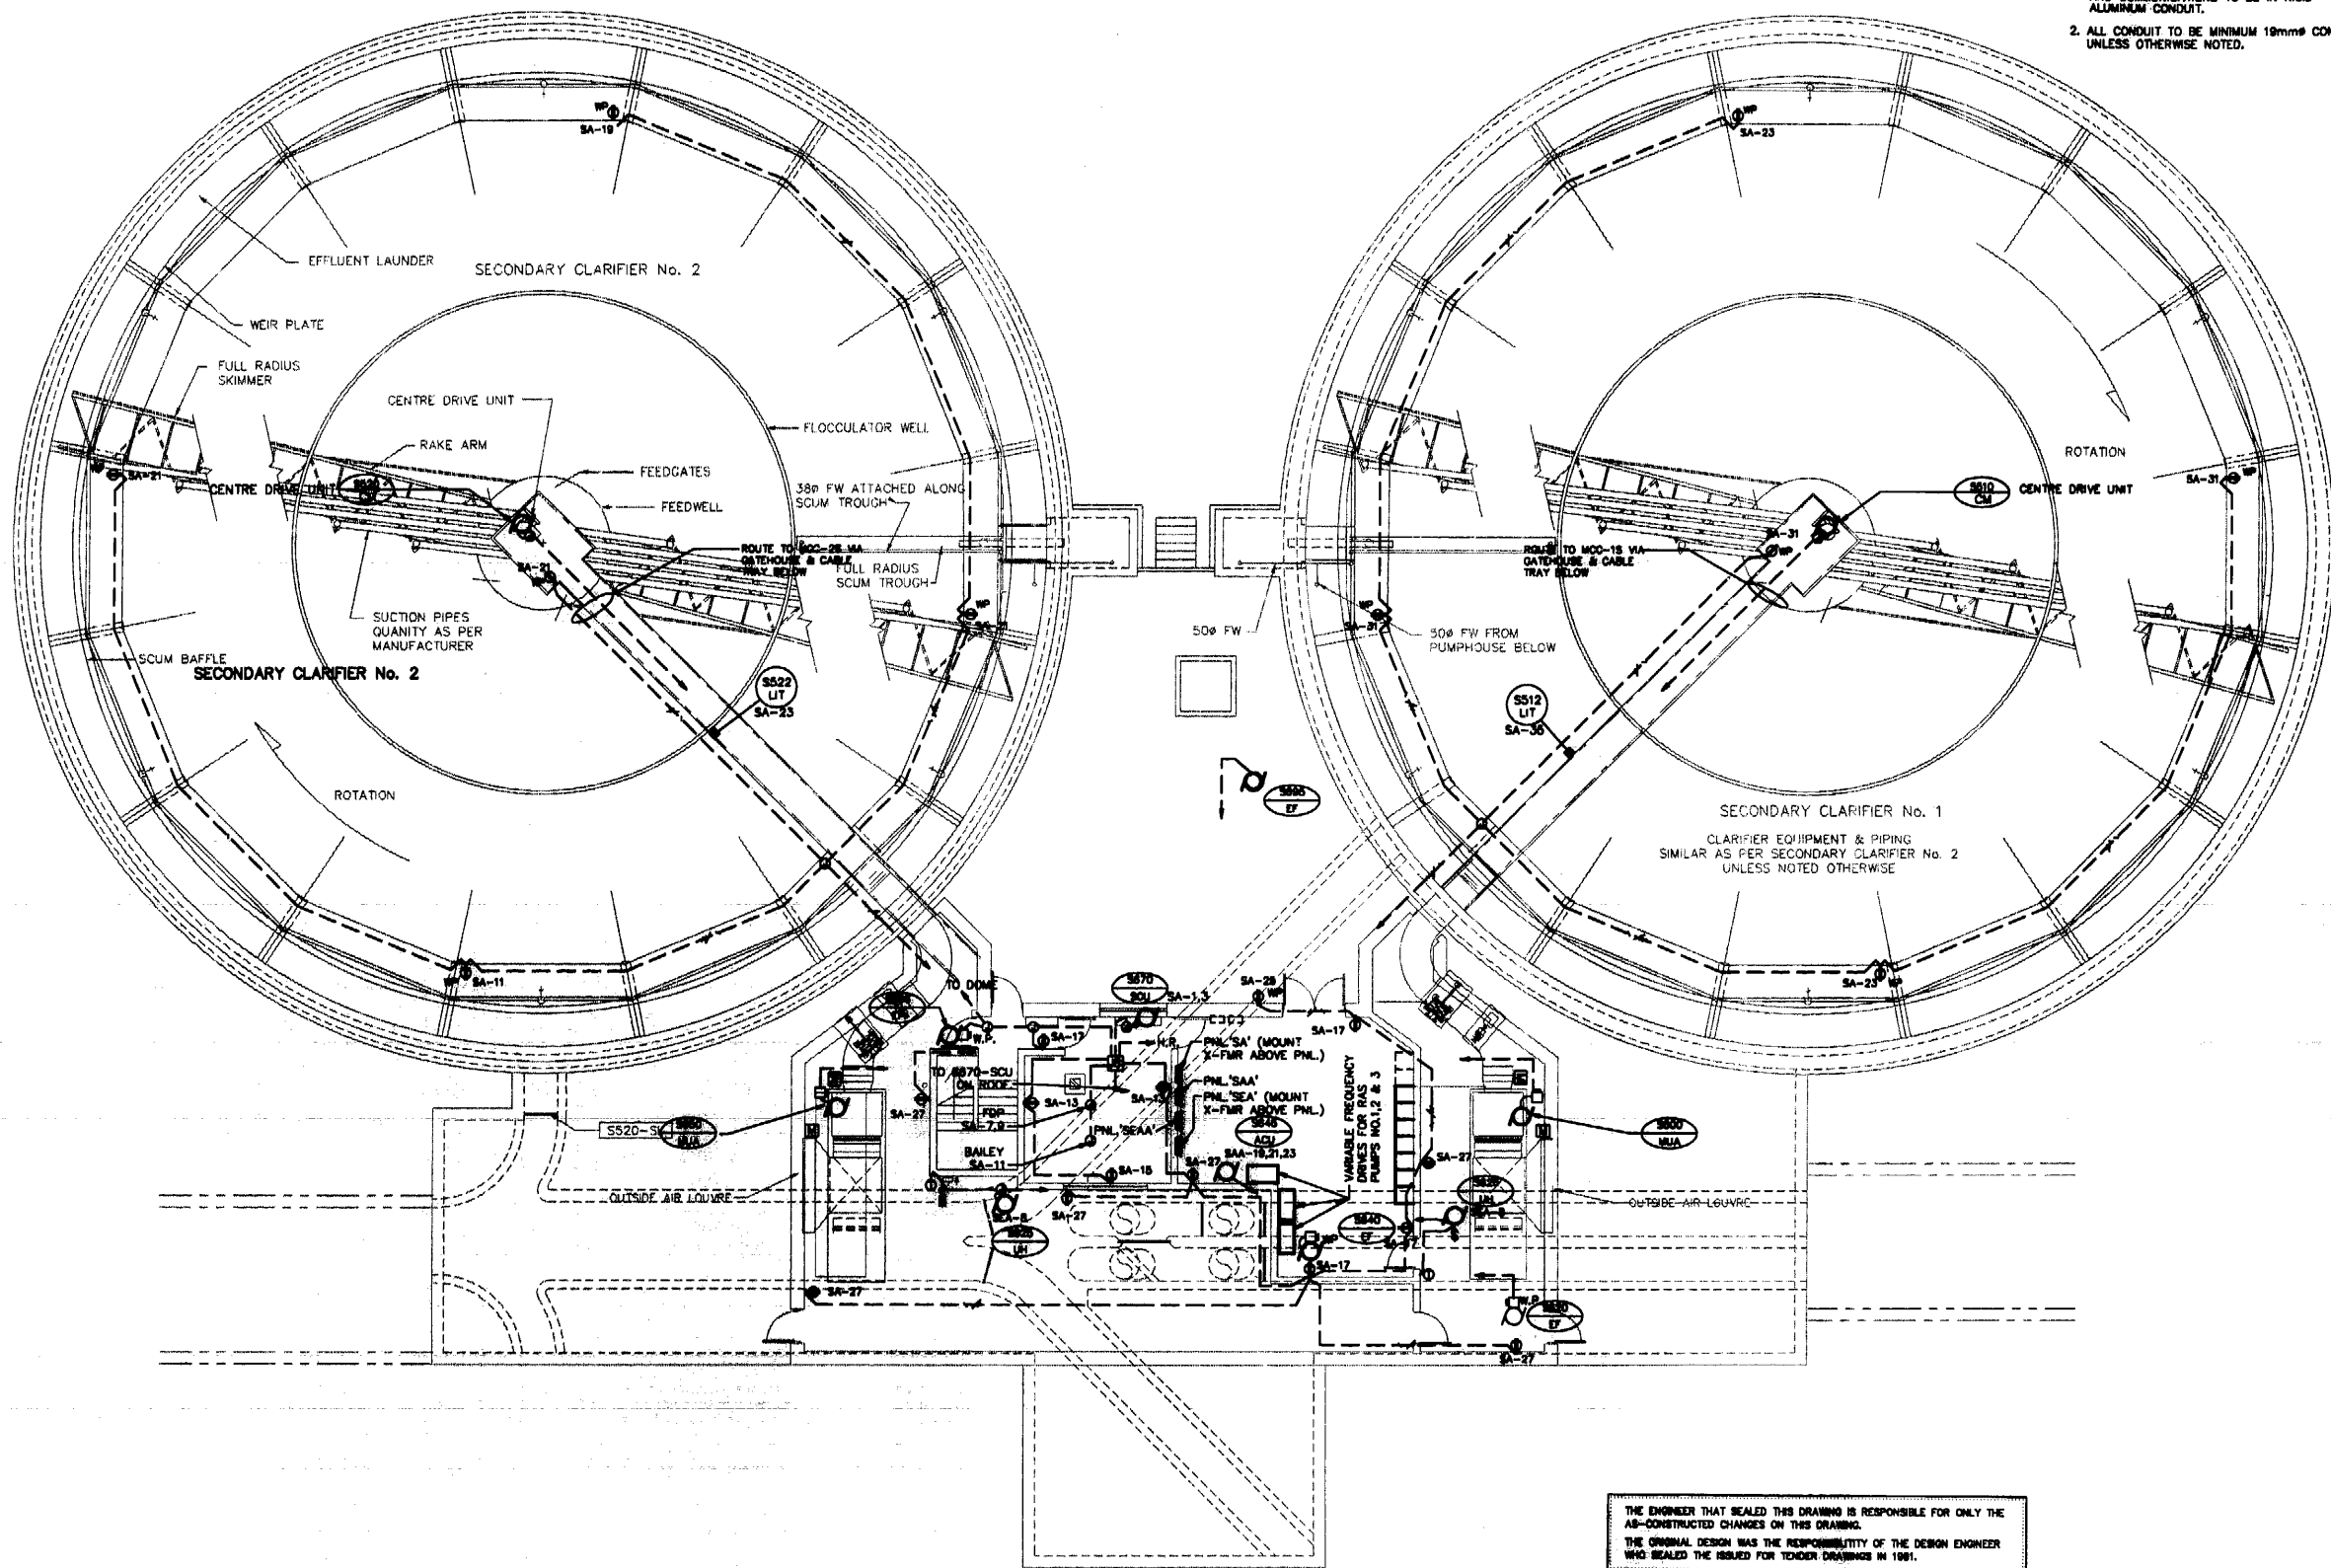

THE ENGINEER THAT SEALED THIS DRAWING IS RESPONSIBLE FOR ONLY THE AS-CONSTRUCTED CHANGES ON THIS DRAWING.
 THE ORIGINAL DESIGN WAS THE RESPONSIBILITY OF THE DESIGN ENGINEER WHO SEALED THE ISSUED FOR TENDER DRAWINGS IN 1981.

REF: 1-100 A1
 91-08-06

REID, CROWTHER & PARTNERS LIMITED
 WINNIPEG
AS CONSTRUCTED
 DATE: *July 20/91*

detail symbol

A detail number
 B drawing where detail shown
 C cross reference to drawing where detail taken

S.M. 88-008 ELEV. 237.638 m	Reid Crowther	ENGINEER'S SEAL 	THE CITY OF WINNIPEG WORKS AND OPERATIONS DIVISION WATERWORKS WASTE AND DISPOSAL DEPT.
DESIGNED BY LT	CHECKED BY DJS		CITY DRAWING NUMBER
DRAWN BY EJS	APPROVED BY		SHEET OF
HOR. SCALE: 1:100	RELEASED FOR CONSTRUCTION:	CONSULTANT DRAWING NO. 80910 - SE3	WEST END WATER POLLUTION CONTROL CENTRE AREA S - SECONDARY CLARIFIERS
NO. 1 AS B.M.T. 93/11 DE	DATE BY DATE 91-06-08		SECONDARY PUMPHOUSE UPPER LEVEL ELECTRICAL POWER LAYOUT
NO. 0 ISSUED FOR TENDER			WEP-269

File # WS 10324