


- CONSTRUCTION NOTES:**
1. ALL DIMENSIONS ARE TO BACK OF CURB.
 2. ISOLATE MISCELLANEOUS ITEMS IN NEW CONCRETE WORKS AS PER SD-228C.
 3. LEGAL PLAN AND UNDERGROUND INFORMATION FROM CITY OF WINNIPEG LBIS. CONTRACTOR TO VERIFY ALL UNDERGROUNDS IN THE FIELD.
 4. CONTRACTOR TO TAKE PRECAUTIONARY STEPS TO AVOID DAMAGE FROM CONSTRUCTION ACTIVITIES TO TREES WITHIN THE LIMITS OF CONSTRUCTION.
 5. LOCATION OF EXISTING SERVICES TO BE CONFIRMED IN THE FIELD BY THE CONTRACTOR.
 6. CB LEADS TO BE INSTALLED AT MIN. 1.0% SLOPE OR AS DIRECTED BY CONTRACT ADMINISTRATOR.
 7. LIMITS OF SIDEWALK RENEWAL TO BE FINALIZED IN THE FIELD BY THE CONTRACT ADMINISTRATOR.
 8. LIMITS OF BOULEVARD GRADING TO BE FINALIZED IN THE FIELD BY THE CONTRACT ADMINISTRATOR.



METRIC
WHOLE NUMBERS INDICATE MILLIMETRES
DECIMAL NUMBERS INDICATE METRES

- WARNING**
- IF POWER EQUIPMENT OR EXPLOSIVES ARE TO BE USED FOR EXCAVATION ON THIS PROJECT THE CONTRACTOR MUST:
1. NOTIFY THE GAS COMPANY OF THE PROPOSED LOCATION OF EXCAVATION.
 2. TAKE PRECAUTION TO AVOID DAMAGE TO GAS COMPANY INSTALLATIONS SEE PROVINCIAL REGULATION 210/72 FOR DETAILS.
 3. OBTAIN EXCAVATION PERMITS PRIOR TO CONSTRUCTION.

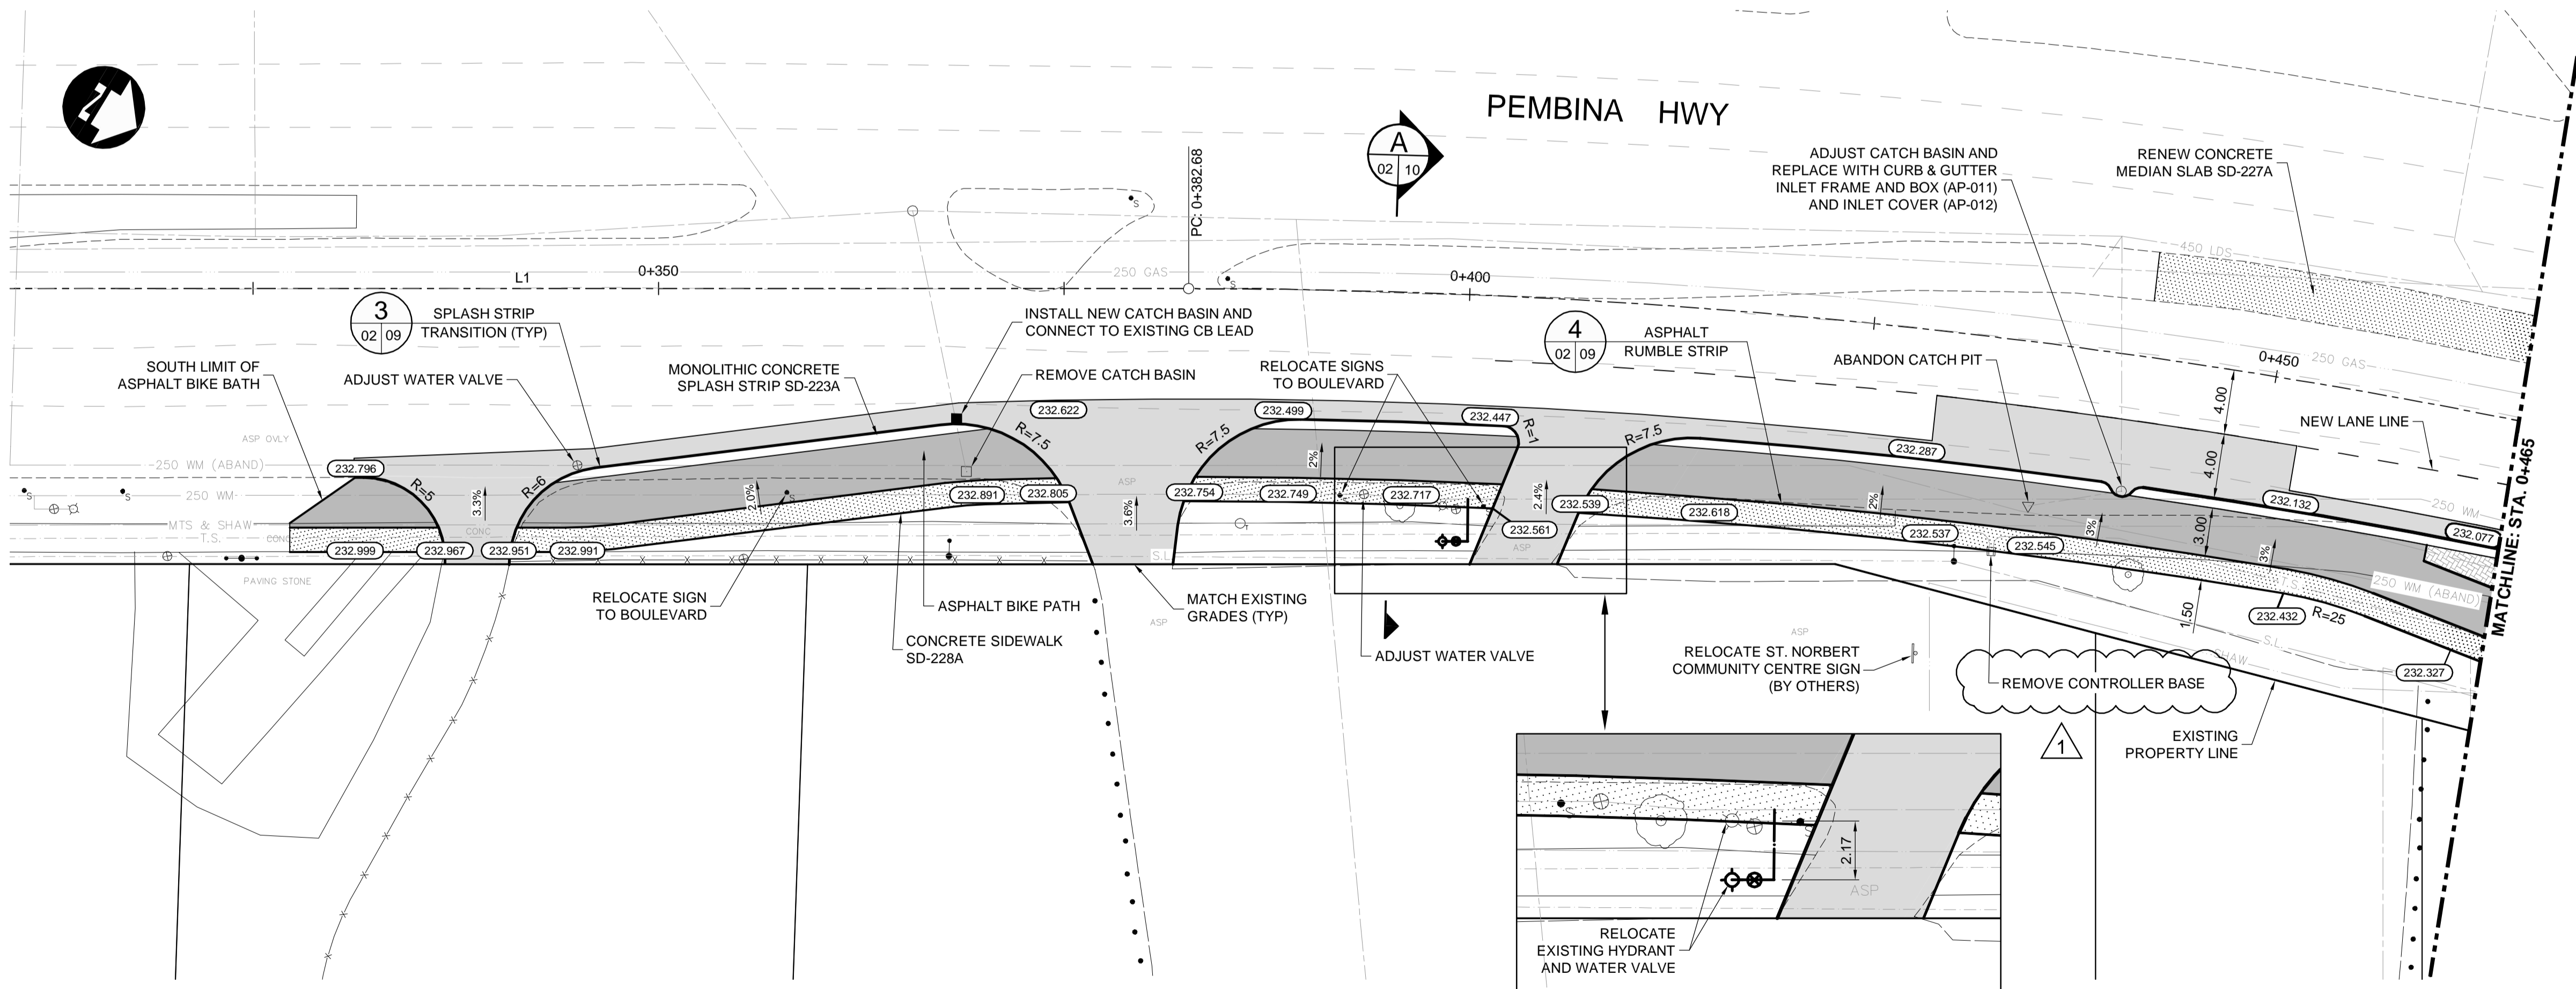

G:\CAD\176149\Drawings\Roadworks\Contract\176149-CON-CT-PLAN-PROFILE.dwg

<table border="1"> <tr> <td>150 WM</td> <td>WATERMAIN</td> <td>150 WM</td> <td>CONCRETE</td> <td>150 WM</td> <td>WATERMAIN</td> <td>150 WM</td> <td>WATERMAIN</td> </tr> <tr> <td>Hydrant</td> <td>HYDRANT</td> <td>Hydrant</td> <td>ASPHALT</td> <td>300 LDS</td> <td>LAND DRAINAGE SEWER</td> <td>300 LDS</td> <td>LAND DRAINAGE SEWER</td> </tr> <tr> <td>Valve</td> <td>VALVE</td> <td>Valve</td> <td>PLANING</td> <td>250 WWS</td> <td>WASTE WATER SEWER</td> <td>250 WWS</td> <td>WASTE WATER SEWER</td> </tr> <tr> <td>Manhole</td> <td>MANHOLE</td> <td>Manhole</td> <td>SIDEWALK</td> <td>Hydrant</td> <td>HYDRANT</td> <td>Hydrant</td> <td>HYDRANT</td> </tr> <tr> <td>Catch Basin</td> <td>CATCH BASIN</td> <td>Catch Basin</td> <td>PAVING STONES</td> <td>Valve</td> <td>VALVE</td> <td>Valve</td> <td>VALVE</td> </tr> <tr> <td>Curb Inlet</td> <td>CURB INLET</td> <td>Curb Inlet</td> <td>PARTIAL DEPTH REPAIR</td> <td>Profile</td> <td>PROFILE</td> <td>Profile</td> <td>PROFILE</td> </tr> <tr> <td>300 LDS</td> <td>LAND DRAINAGE SEWER</td> <td>300 LDS</td> <td>PROPERTY LINE</td> <td>North/West Gutter</td> <td>NORTH/WEST GUTTER</td> <td>North/West Gutter</td> <td>NORTH/WEST GUTTER</td> </tr> <tr> <td>250 WWS</td> <td>WASTE WATER SEWER</td> <td>250 WWS</td> <td>DRAINAGE ARROW</td> <td>South/East Gutter</td> <td>SOUTH/EAST GUTTER</td> <td>South/East Gutter</td> <td>SOUTH/EAST GUTTER</td> </tr> <tr> <td>Hydro</td> <td>HYDRO</td> <td>Hydro</td> <td></td> <td>North/West Ditch</td> <td>NORTH/WEST DITCH</td> <td>North/West Ditch</td> <td>NORTH/WEST DITCH</td> </tr> <tr> <td>M.T.S.</td> <td>M.T.S.</td> <td>M.T.S.</td> <td></td> <td>South/East Ditch</td> <td>SOUTH/EAST DITCH</td> <td>South/East Ditch</td> <td>SOUTH/EAST DITCH</td> </tr> <tr> <td>100 GAS</td> <td>GAS</td> <td>100 GAS</td> <td></td> <td></td> <td></td> <td></td> <td></td> </tr> <tr> <td>EXISTING</td> <td>LEGEND-PLAN</td> <td>PROPOSED</td> <td>EXISTING</td> <td>LEGEND-PLAN</td> <td>PROPOSED</td> <td>EXISTING</td> <td>LEGEND-PROFILE</td> </tr> </table>	150 WM	WATERMAIN	150 WM	CONCRETE	150 WM	WATERMAIN	150 WM	WATERMAIN	Hydrant	HYDRANT	Hydrant	ASPHALT	300 LDS	LAND DRAINAGE SEWER	300 LDS	LAND DRAINAGE SEWER	Valve	VALVE	Valve	PLANING	250 WWS	WASTE WATER SEWER	250 WWS	WASTE WATER SEWER	Manhole	MANHOLE	Manhole	SIDEWALK	Hydrant	HYDRANT	Hydrant	HYDRANT	Catch Basin	CATCH BASIN	Catch Basin	PAVING STONES	Valve	VALVE	Valve	VALVE	Curb Inlet	CURB INLET	Curb Inlet	PARTIAL DEPTH REPAIR	Profile	PROFILE	Profile	PROFILE	300 LDS	LAND DRAINAGE SEWER	300 LDS	PROPERTY LINE	North/West Gutter	NORTH/WEST GUTTER	North/West Gutter	NORTH/WEST GUTTER	250 WWS	WASTE WATER SEWER	250 WWS	DRAINAGE ARROW	South/East Gutter	SOUTH/EAST GUTTER	South/East Gutter	SOUTH/EAST GUTTER	Hydro	HYDRO	Hydro		North/West Ditch	NORTH/WEST DITCH	North/West Ditch	NORTH/WEST DITCH	M.T.S.	M.T.S.	M.T.S.		South/East Ditch	SOUTH/EAST DITCH	South/East Ditch	SOUTH/EAST DITCH	100 GAS	GAS	100 GAS						EXISTING	LEGEND-PLAN	PROPOSED	EXISTING	LEGEND-PLAN	PROPOSED	EXISTING	LEGEND-PROFILE	<p>UNDERGROUND STRUCTURES</p> <p>SUPPLY, U/G STRUCTURES DATE</p> <p>LOCATION OF UNDERGROUND STRUCTURES AS SHOWN ARE BASED ON THE BEST INFORMATION AVAILABLE, BUT NO GUARANTEE IS GIVEN THAT ALL EXISTING UTILITIES ARE SHOWN OR THAT THE GIVEN LOCATIONS ARE EXACT. CONFIRMATION OF EXISTENCE AND EXACT LOCATION OF ALL SERVICES MUST BE OBTAINED FROM THE INDIVIDUAL UTILITIES BEFORE PROCEEDING WITH CONSTRUCTION.</p>	<table border="1"> <tr> <td>B.M. ELEV.</td> <td></td> <td></td> <td></td> <td></td> </tr> <tr> <td>NO.</td> <td>REVISIONS</td> <td>DATE</td> <td>BY</td> <td></td> </tr> </table>	B.M. ELEV.					NO.	REVISIONS	DATE	BY		<table border="1"> <tr> <td>DESIGNED BY</td> <td>TJH</td> </tr> <tr> <td>DRAWN BY</td> <td>TJH</td> </tr> <tr> <td>CHECKED BY</td> <td>TS</td> </tr> <tr> <td>APPROVED BY</td> <td>TJP</td> </tr> <tr> <td>HOR. SCALE</td> <td>1:250</td> </tr> <tr> <td>VERTICAL</td> <td>1:10</td> </tr> </table>	DESIGNED BY	TJH	DRAWN BY	TJH	CHECKED BY	TS	APPROVED BY	TJP	HOR. SCALE	1:250	VERTICAL	1:10		<p>ENGINEER'S SEAL</p>	<p>THE CITY OF WINNIPEG PUBLIC WORKS DEPARTMENT</p>	<p>PEMBINA HIGHWAY REHABILITATION AND ACTIVE TRANSPORTATION PATH</p> <p>CITY DRAWING NUMBER: P-3493-2018-02 SHEET 02 OF 10</p>	<p>CONSULTANT PROJECT NUMBER: 17-6149</p> <p>CONSULTANT DRAWING NUMBER</p>
150 WM	WATERMAIN	150 WM	CONCRETE	150 WM	WATERMAIN	150 WM	WATERMAIN																																																																																																																							
Hydrant	HYDRANT	Hydrant	ASPHALT	300 LDS	LAND DRAINAGE SEWER	300 LDS	LAND DRAINAGE SEWER																																																																																																																							
Valve	VALVE	Valve	PLANING	250 WWS	WASTE WATER SEWER	250 WWS	WASTE WATER SEWER																																																																																																																							
Manhole	MANHOLE	Manhole	SIDEWALK	Hydrant	HYDRANT	Hydrant	HYDRANT																																																																																																																							
Catch Basin	CATCH BASIN	Catch Basin	PAVING STONES	Valve	VALVE	Valve	VALVE																																																																																																																							
Curb Inlet	CURB INLET	Curb Inlet	PARTIAL DEPTH REPAIR	Profile	PROFILE	Profile	PROFILE																																																																																																																							
300 LDS	LAND DRAINAGE SEWER	300 LDS	PROPERTY LINE	North/West Gutter	NORTH/WEST GUTTER	North/West Gutter	NORTH/WEST GUTTER																																																																																																																							
250 WWS	WASTE WATER SEWER	250 WWS	DRAINAGE ARROW	South/East Gutter	SOUTH/EAST GUTTER	South/East Gutter	SOUTH/EAST GUTTER																																																																																																																							
Hydro	HYDRO	Hydro		North/West Ditch	NORTH/WEST DITCH	North/West Ditch	NORTH/WEST DITCH																																																																																																																							
M.T.S.	M.T.S.	M.T.S.		South/East Ditch	SOUTH/EAST DITCH	South/East Ditch	SOUTH/EAST DITCH																																																																																																																							
100 GAS	GAS	100 GAS																																																																																																																												
EXISTING	LEGEND-PLAN	PROPOSED	EXISTING	LEGEND-PLAN	PROPOSED	EXISTING	LEGEND-PROFILE																																																																																																																							
B.M. ELEV.																																																																																																																														
NO.	REVISIONS	DATE	BY																																																																																																																											
DESIGNED BY	TJH																																																																																																																													
DRAWN BY	TJH																																																																																																																													
CHECKED BY	TS																																																																																																																													
APPROVED BY	TJP																																																																																																																													
HOR. SCALE	1:250																																																																																																																													
VERTICAL	1:10																																																																																																																													