


1 BASEMENT – HEATING RENOVATION LAYOUT
M6.0 SCALE: 1:100

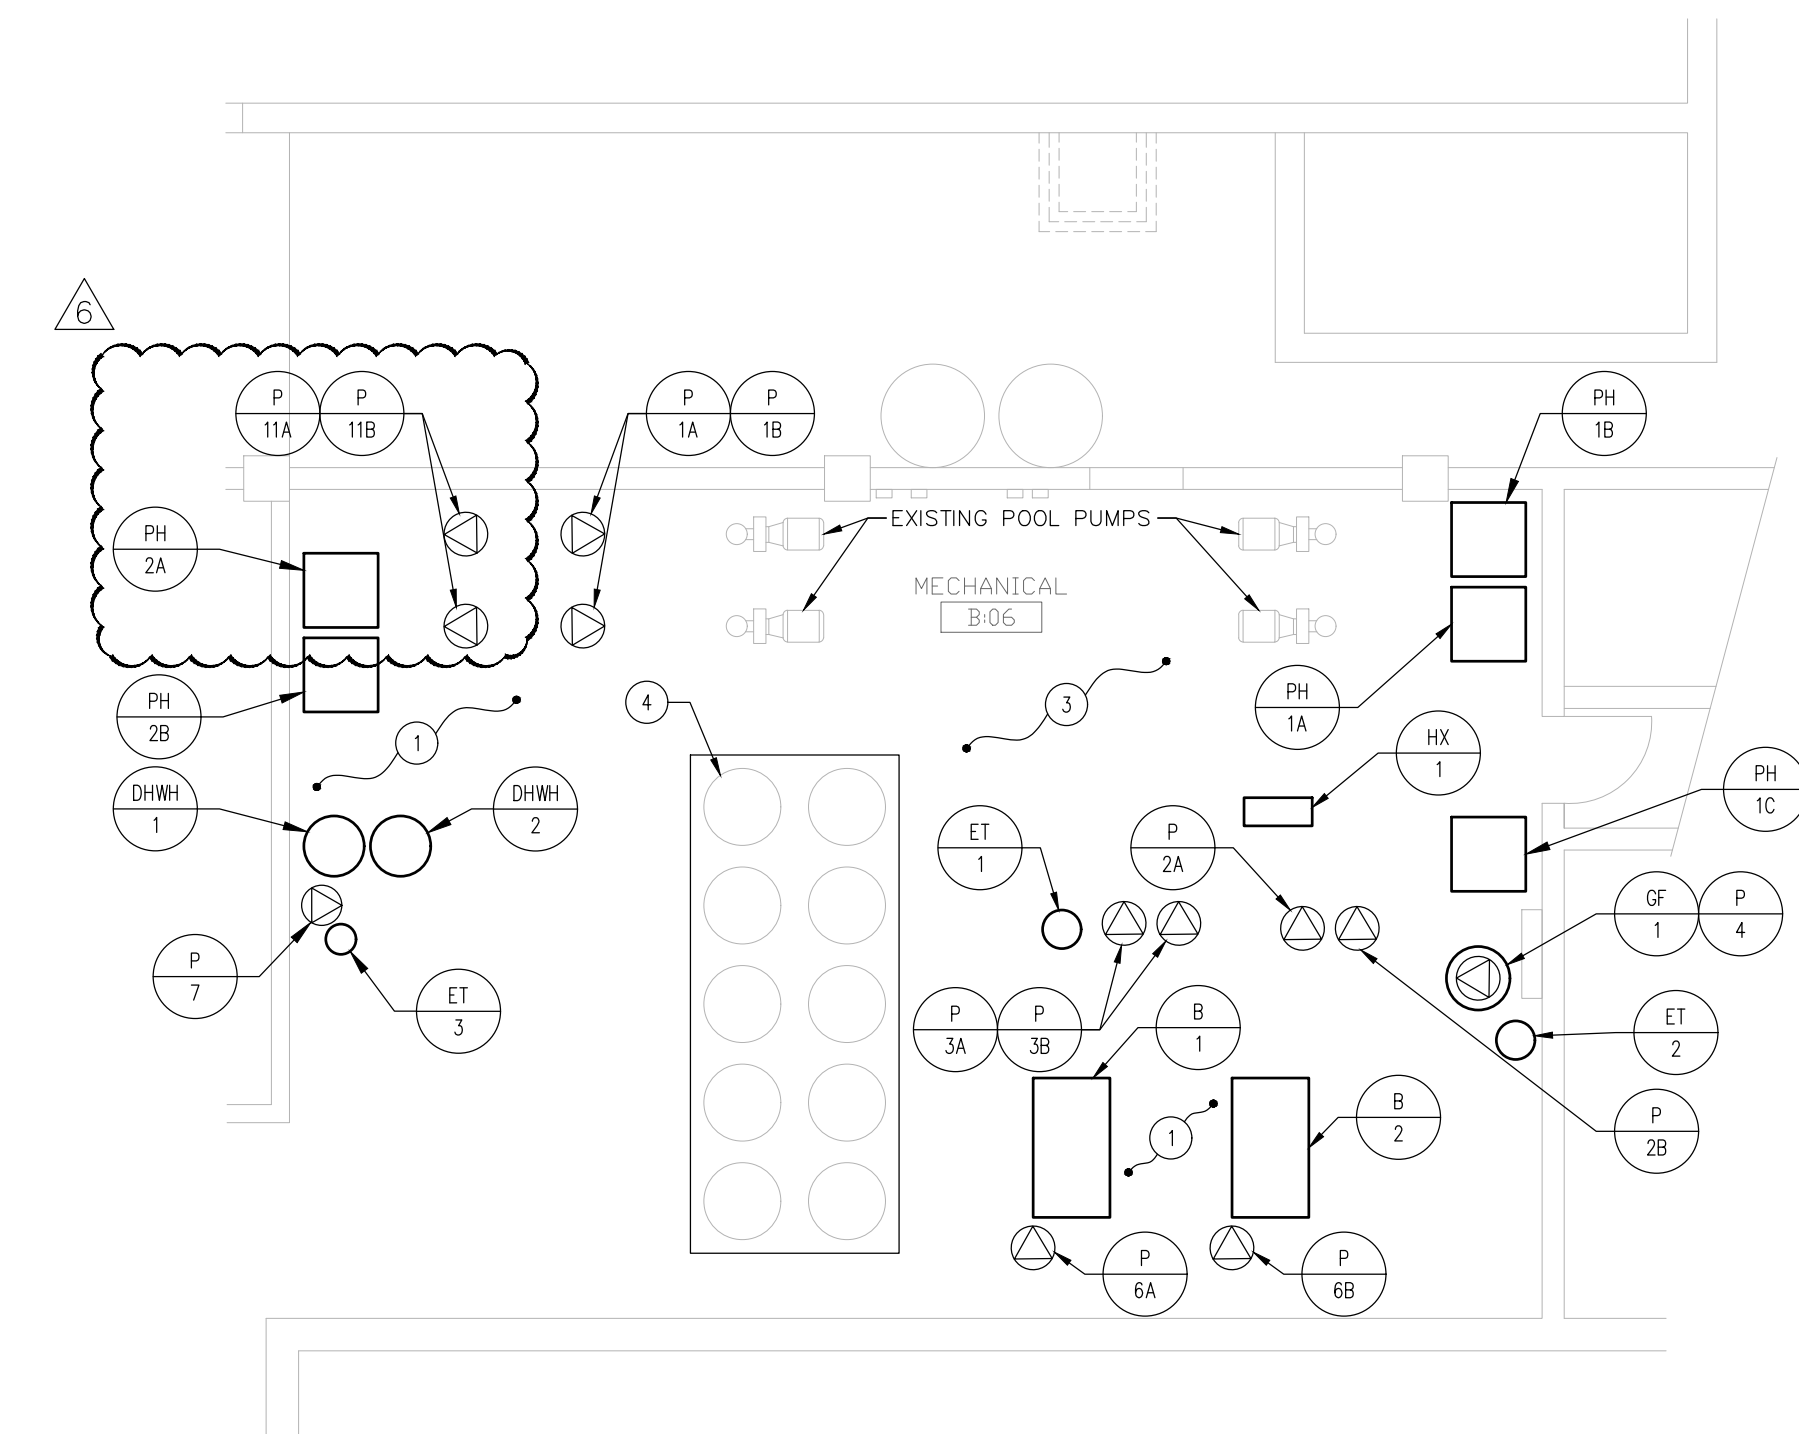

2 ENLARGED MECHANICAL ROOM – HVAC RENOVATION LAYOUT
M6.0 SCALE: 1:75

GENERAL NOTES:

1. THIS DRAWING IS DIAGRAMMATIC ONLY. DO NOT SCALE.
2. THE MECHANICAL SYSTEMS SHOWN ARE APPROXIMATE IN LOCATION ONLY. CONTRACTOR TO VERIFY EXACT LOCATION OF SYSTEMS BEING MODIFIED ON-SITE PRIOR TO COMMENCEMENT OF WORK.
3. ALL WORK SHALL COMPLY WITH THE MOST CURRENT VERSION OF ALL APPLICABLE CODES AND STANDARDS, WHICH SHALL BE CONSIDERED PART OF THESE CONTRACT DOCUMENTS. IN THE CASE OF CONFLICTING REQUIREMENTS, THE MOST STRINGENT REGULATION SHALL PREVAIL.
4. CONTRACTOR TO MAINTAIN CURRENT AND READILY REVIEWABLE AS-BUILT DRAWINGS ACCURATELY REFLECTING SITE INSTALLATIONS.
5. CONTRACTOR TO ENSURE ALL MATERIALS MODIFIED OR INSTALLED IN AN AIR PLENUM ARE RATED FOR SUCH USE.
6. CONTRACTOR TO MAINTAIN DIGITAL PHOTOGRAPHIC RECORDS OF ALL INSTALLATIONS PRIOR TO CONCEALMENT BY SUPPORTING TRADES.
7. REFER TO REQUIREMENTS IN SPECIFICATIONS FOR DEMOLISHING/REMOVAL OF ASBESTOS.

DRAWINGS NOTES:

- 1 REUSE EXISTING HOUSEKEEPING PAD.
- 2 HWS AND HWR PIPING RISE TO ABOVE TO SERVE HEATING COILS AND RADIANT PANELS.
- 3 REFER TO DRAWING M6.0 FOR PIPING AND VALVES ETC.
- 4 EXISTING POOL FILTERS (10) TO REMAIN.

ENGINEERS
GEOSCIENTISTS
MANITOBA
Certificate of Authorization
MCW Consultants Ltd.
No. 7183

215-821 Wellington Avenue
Winnipeg, Manitoba, R3B 0G4
Phone: (204) 779-7900
Fax: (204) 779-7901
www.mcw.com
13600
MCW
13600
MCW Consultants Ltd.

2	JULY 13, 2022	ISSUED FOR ADD#06	
1	JUNE 21, 2022	ISSUED FOR CONSTRUCTION	
No.	Date	Issue / Revision	By

Drawn By: EJ
Printing Date:

Drawings and specifications, as instruments of service are the property of the architects, the copyright in the same being reserved to them. No reproduction may be made without the permission of the architects, and when made, must bear their names. All prints to be returned.

The contractor is to verify dimensions and data noted herein with conditions on the site and is held responsible for reporting any discrepancy to the architects for adjustment.

LM LM Architectural Group
500-136 Market Ave
Winnipeg Manitoba Canada R3B 0P4
t: (204) 942.0681 f: (204) 943.8676
www.lm-architects.com

CITY OF WINNIPEG
BONIVITAL POOL RENEWAL

1215 Archibald St, Winnipeg, MB.

BASEMENT -
HEATING RENOVATION
LAYOUT