




Replace with:  
2x3C - #500MCM 5kV Teck two per phase plus 4/0 ground installed in trench.

2x3C-#500MCM-5kV-TECK  
THREE PER PHASE PLUS 4/0-GROUND  
INSTALLED IN TRENCH

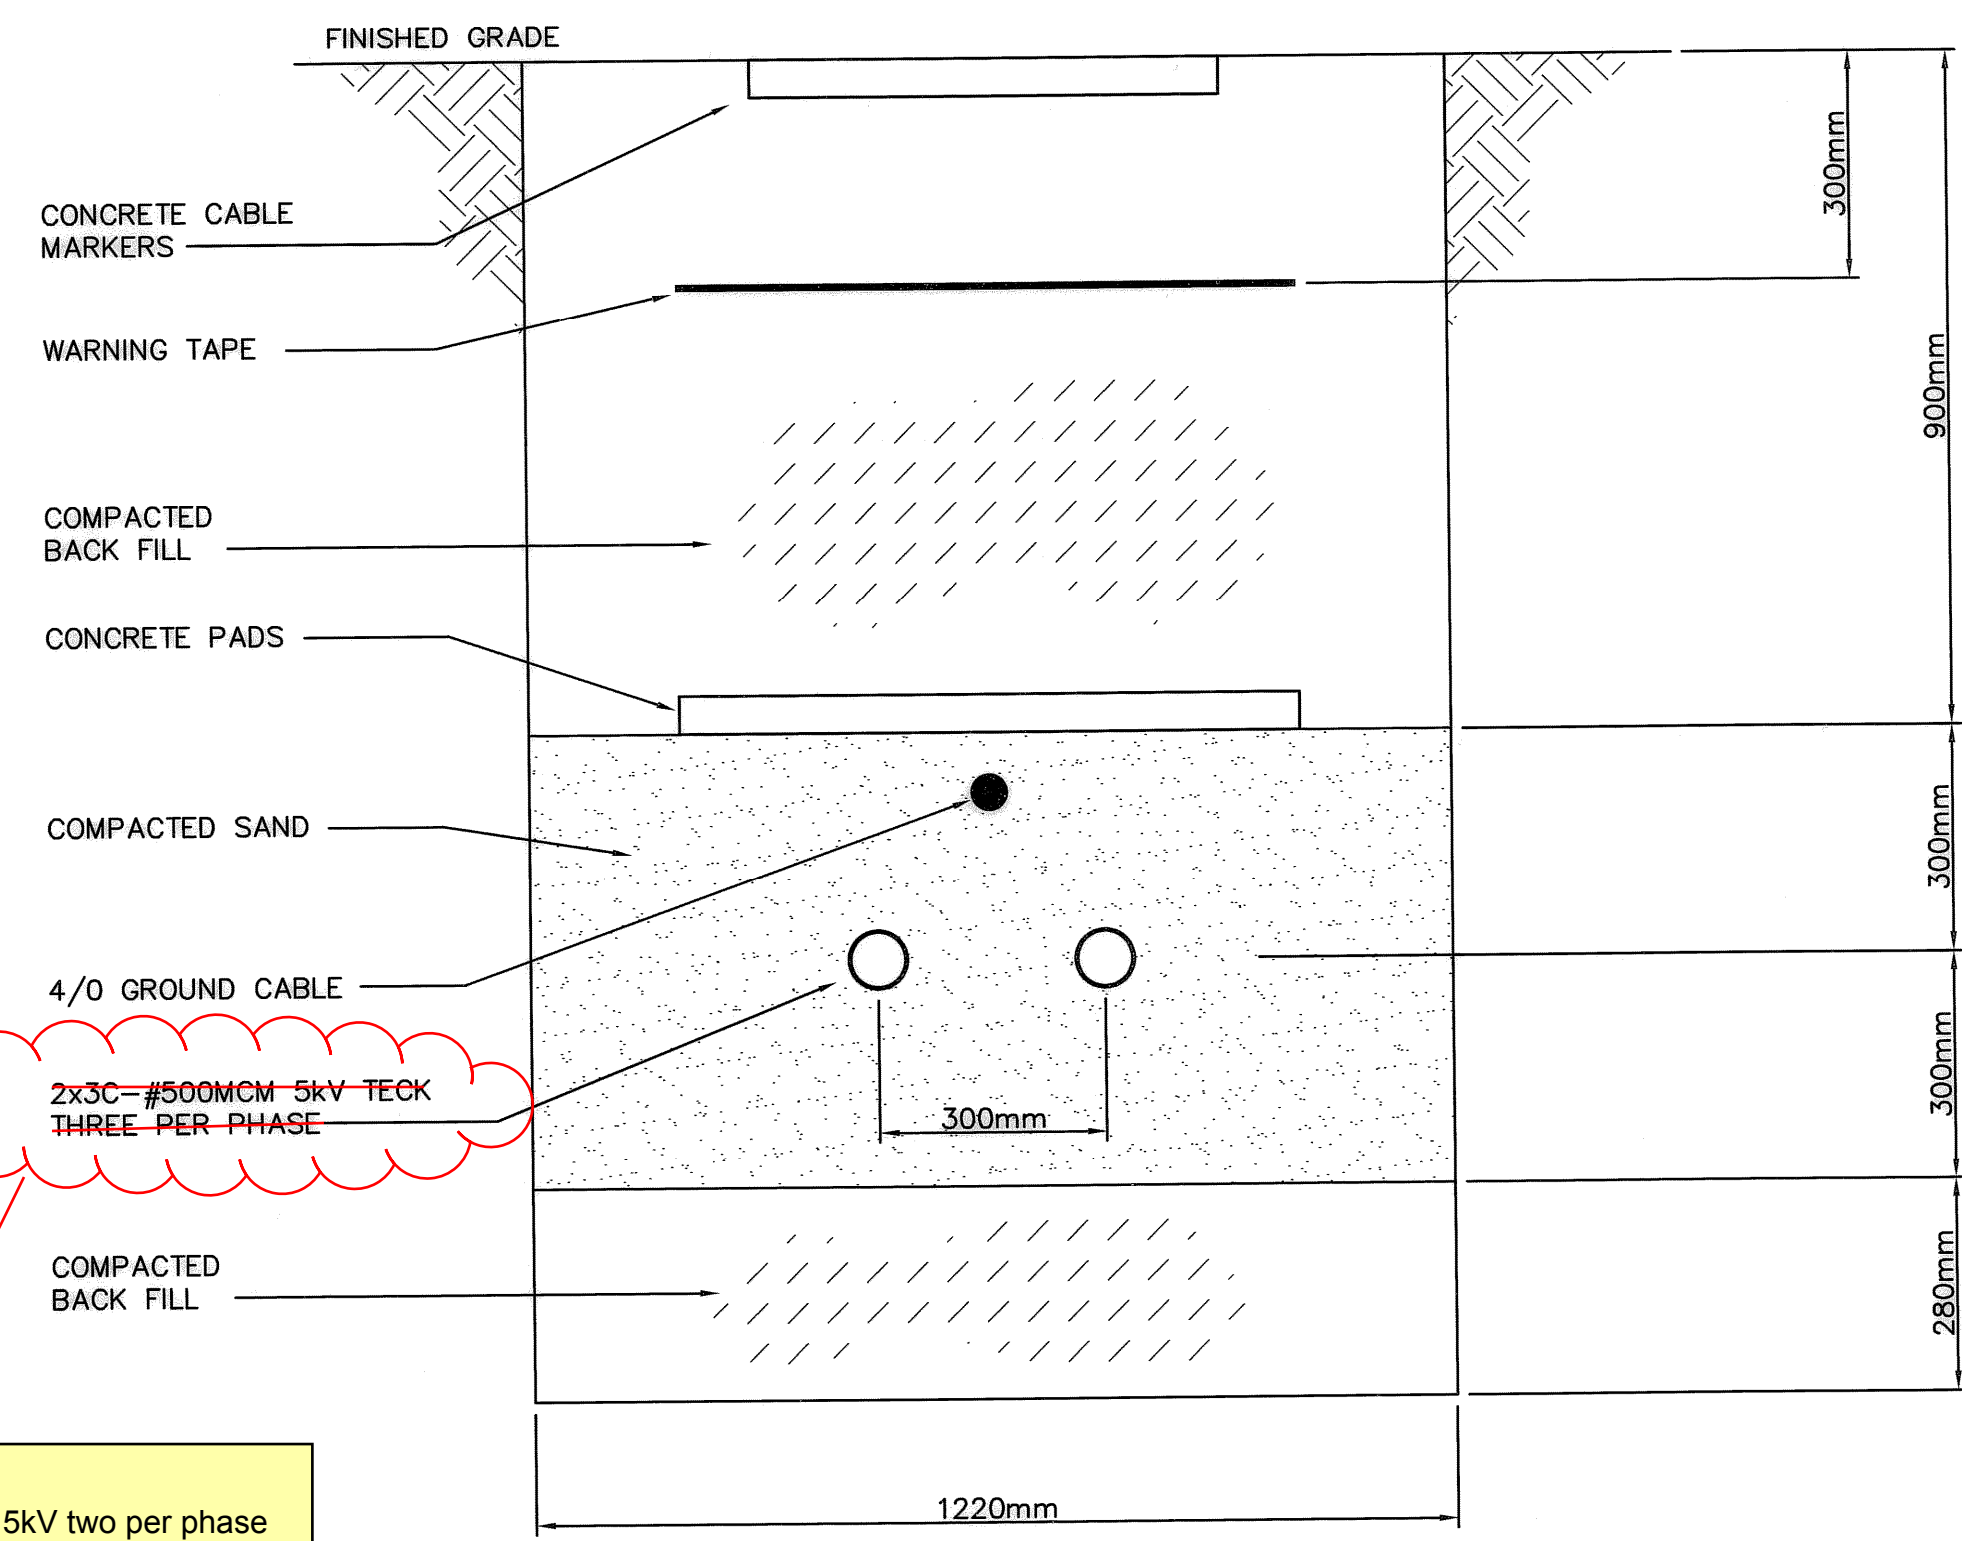

Replace with:  
2x3C-#500MCM 5kV two per phase

A SECTION  
E003 SCALE 1:10

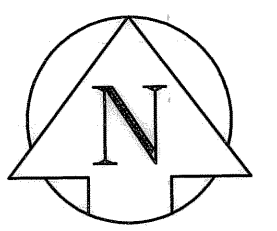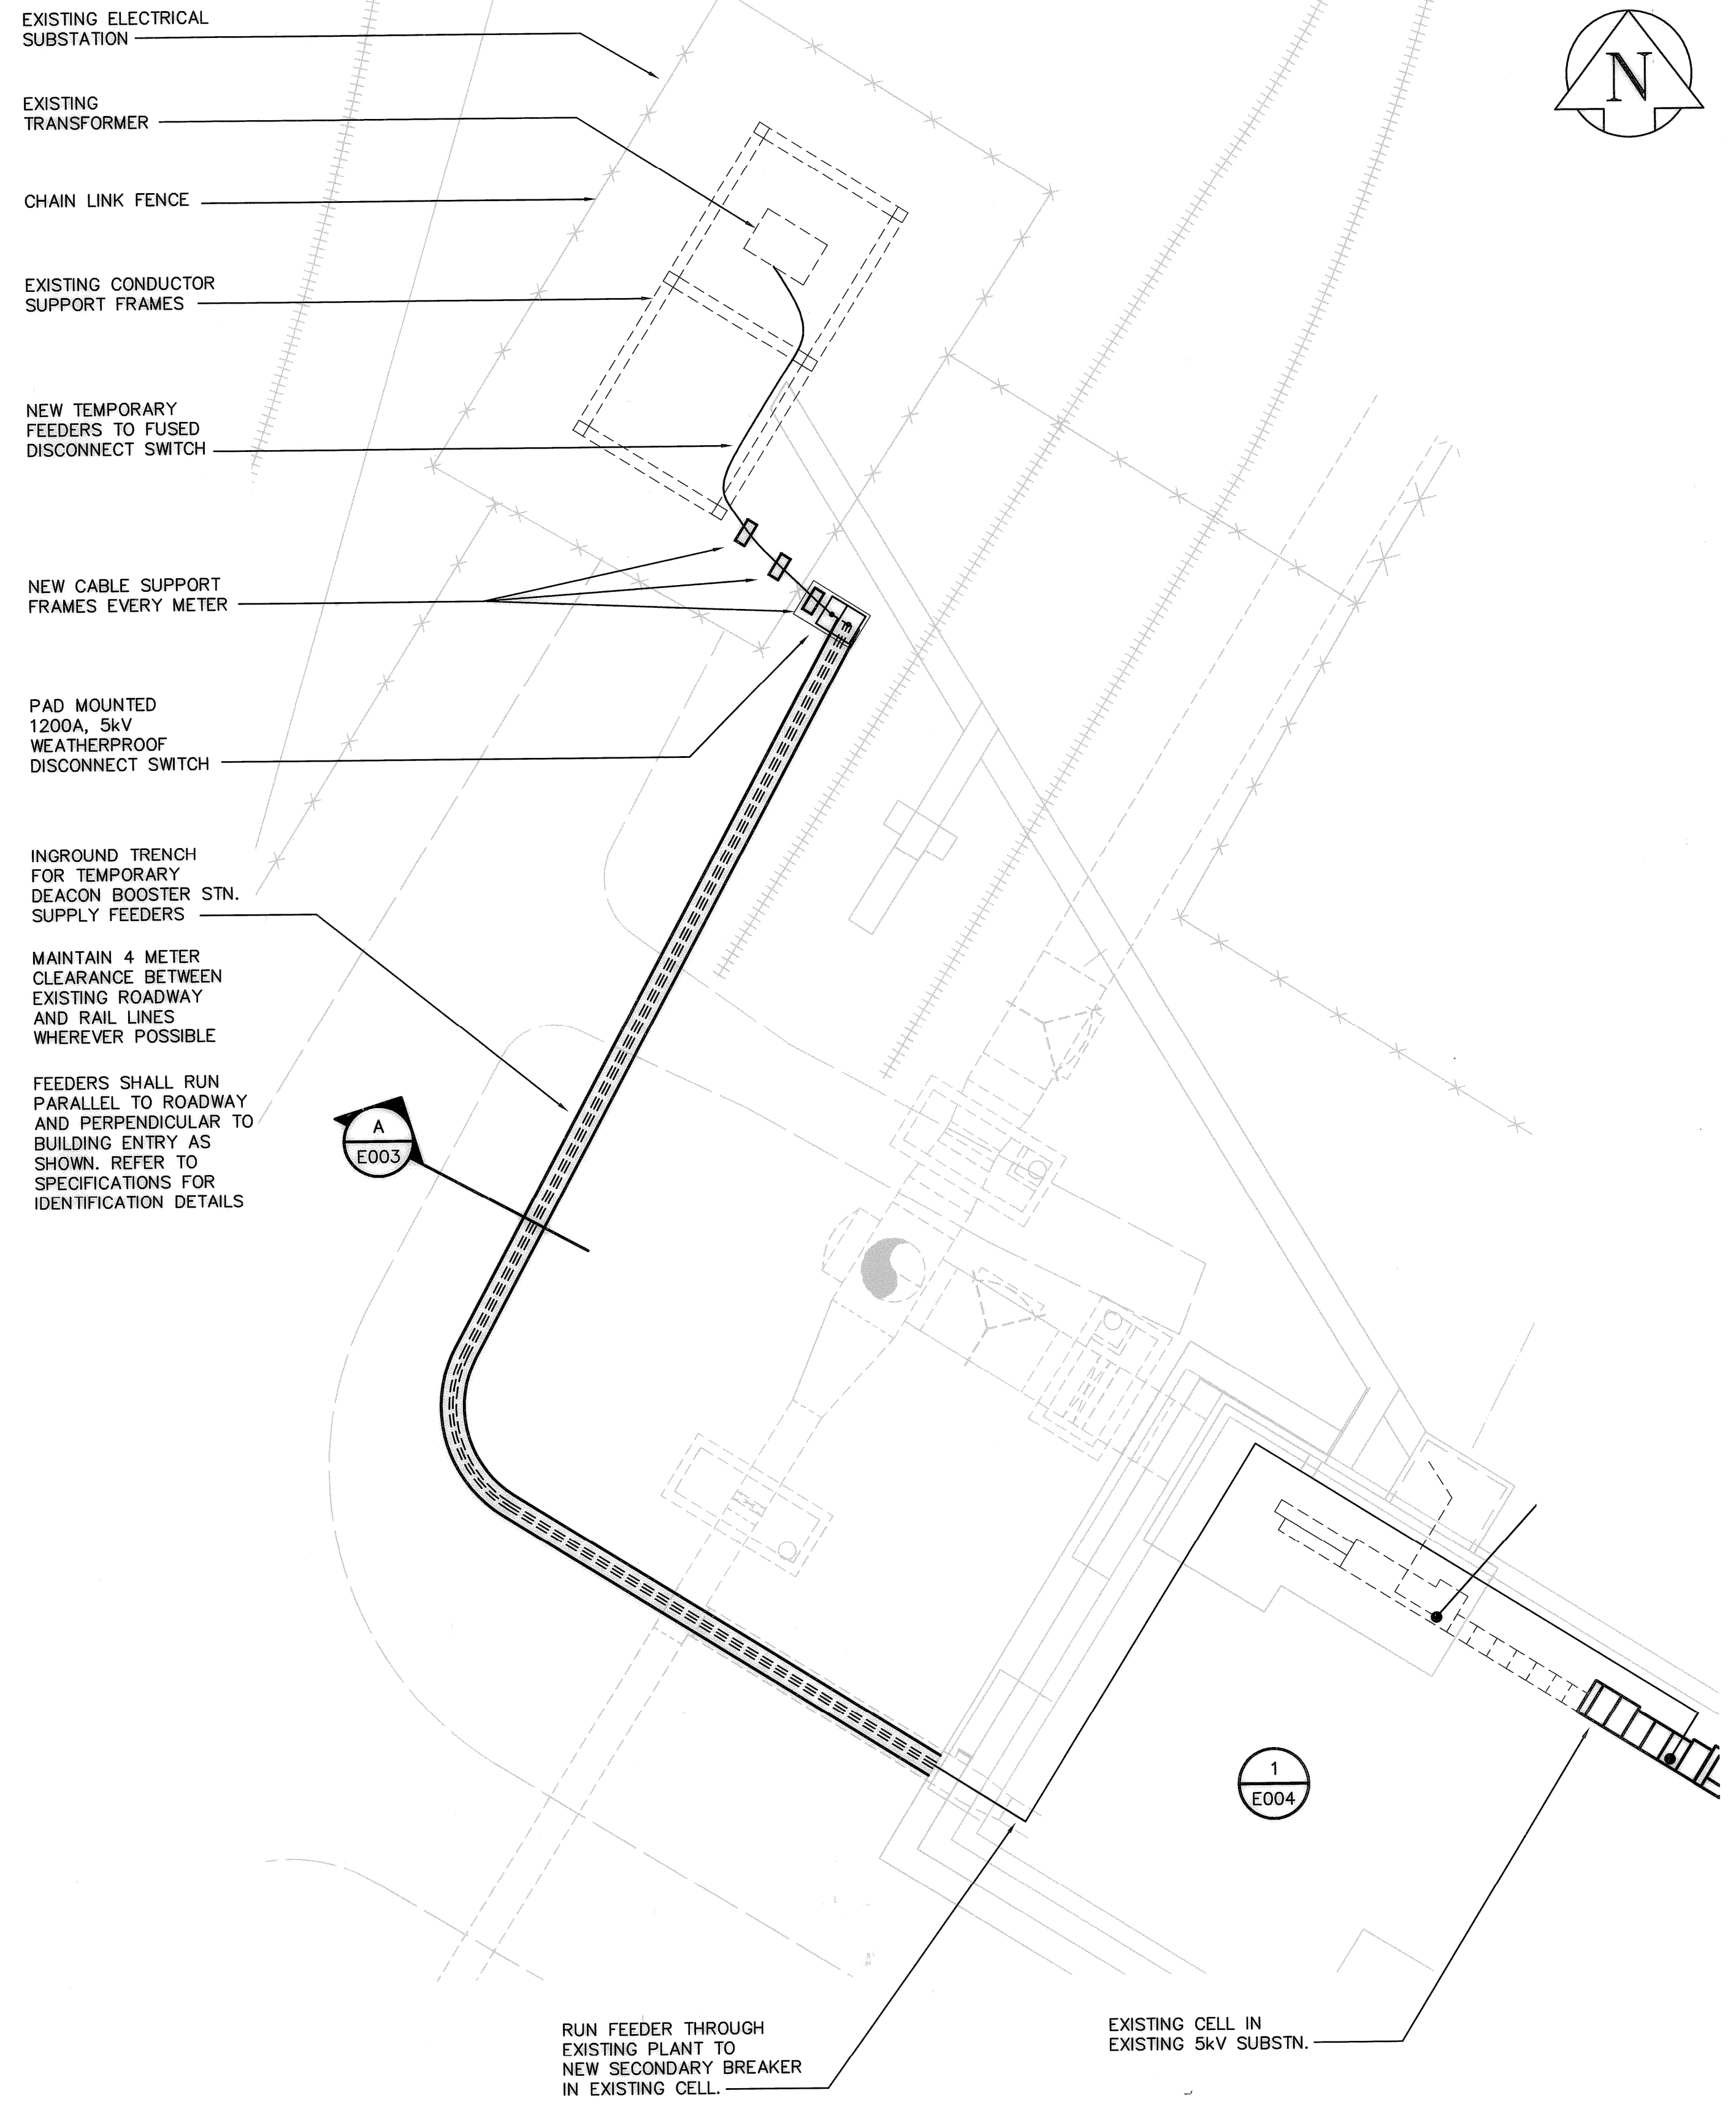

DRAWING NO. WM-E003-SK-1