


ARD AQUATIC MACROPHYTE ABUNDANCE SCALE

	BARREN	0% COVER (0 $\mu/25m^2$ )
	PRESENT	<10% COVER (1 $\mu/25m^2$ )
	SPARSE	10-38% COVER (1-10 $\mu/25m^2$ )
	MODERATE	40-88% COVER (11-48 $\mu/25m^2$ )
	DENSE	70-100% COVER ( $>50 \mu/25m^2$ )

- - - HIGH WATER LEVEL 230.120
- NORMAL WATER LEVEL 228.810
- - - 1.0m DEPTH ELEV 227.810
- LAKE BOTTOM ELEV 227.000

← SHORELINE TO BE TREATED

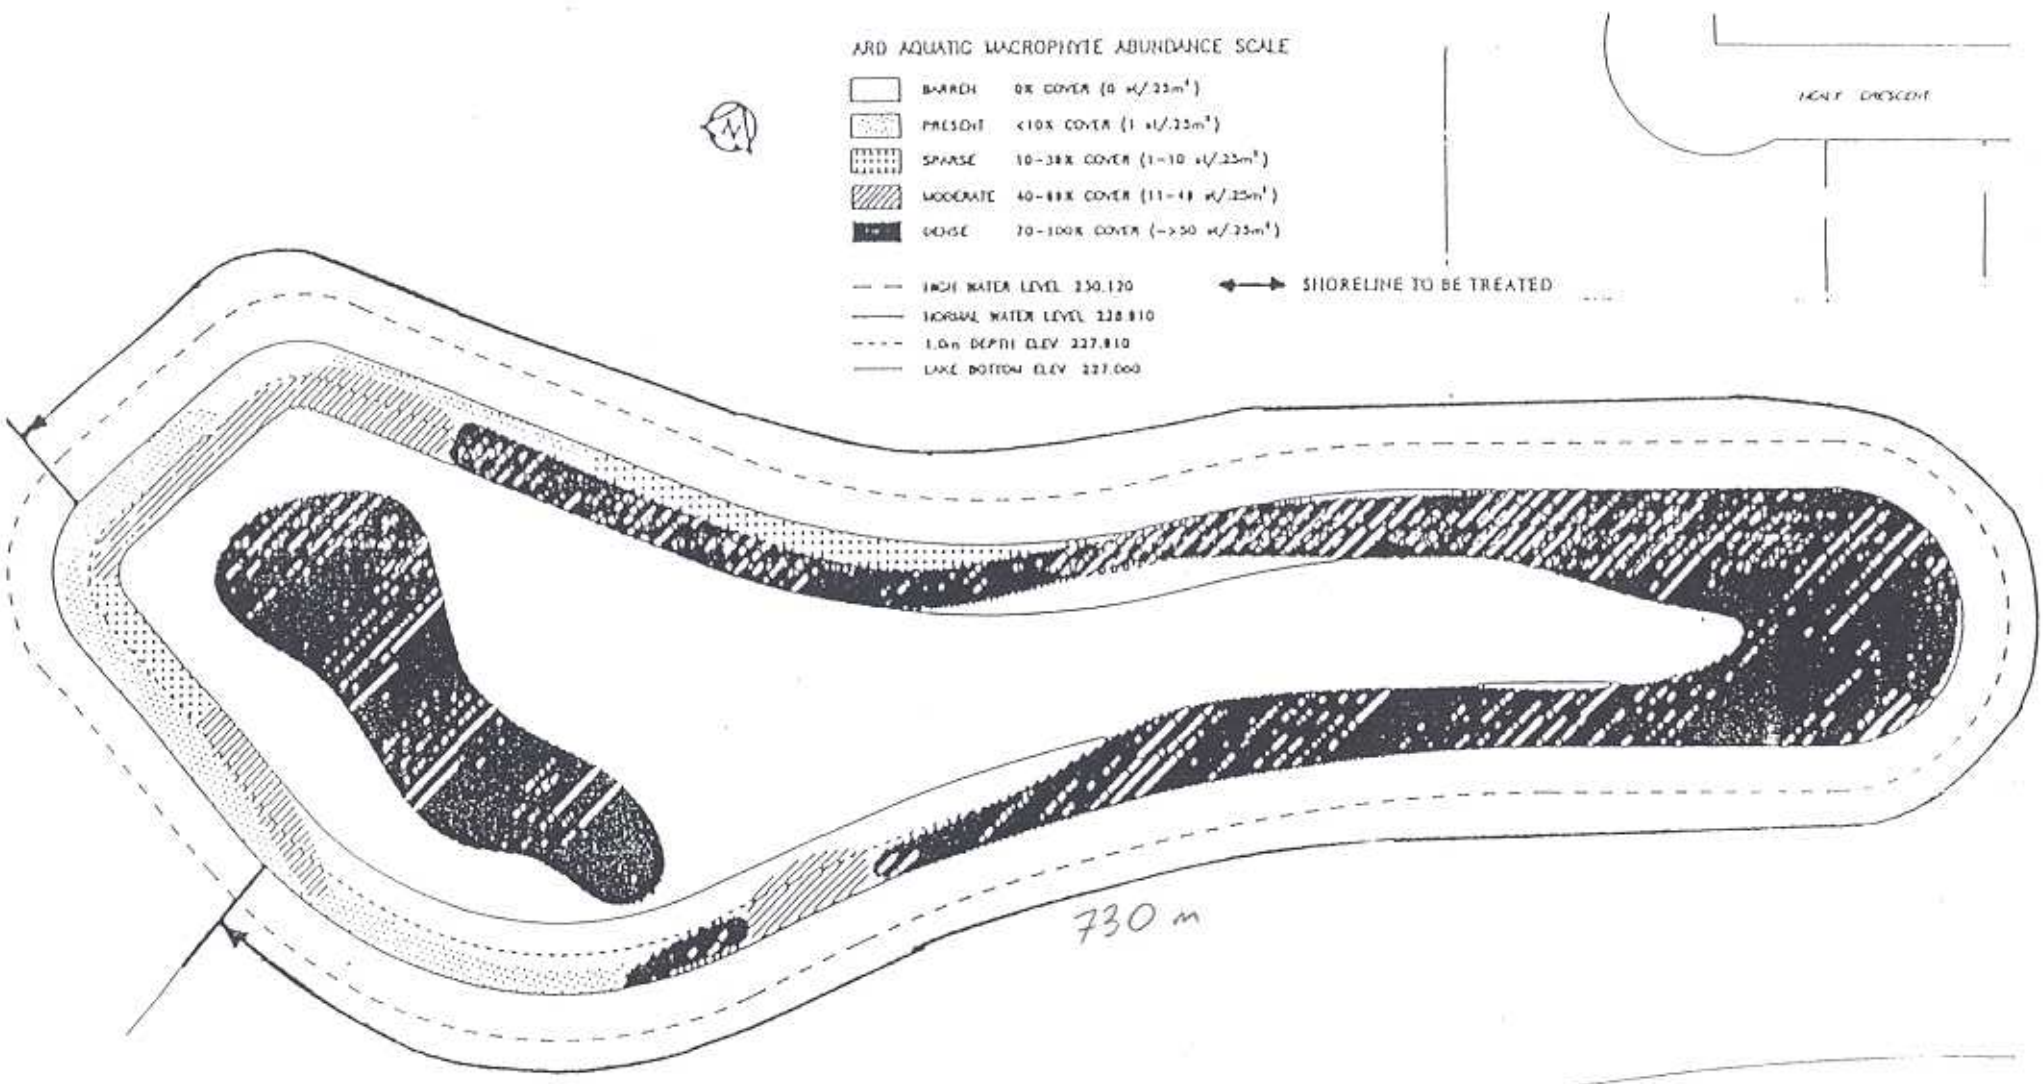

730 m

LAKE 5-16  
TOTAL SHORELINE TO BE TREATED = 730 m

N.T.S.

STORM WATER RETENTION BASIN REVIEW STUDY  
LAKE 5-16  
SAMPLING, MOORED AQUATIC MACROPHYTE COUNTS  
AUGUST 1991

DWG. No. 16