

NOTE:
 - STUD WALL TO BEAM CONNECTION
 - SEE STRUCT. 2/5101
 - STOP DRWL 150 FROM U/S BEAM
 - BREAK PLYWD 50 G U/S BEAM

SHOP DRAWING REFERENCE		
DESCRIPTION	SUPPLIER	NUMBER
Precast Architectural Concrete	Genstar Structures	2280
Precast Hollow Core Floor	Genstar Structures	2281

TOP OF PARAPET CONST.
 - STONE BALLAST
 - WATER PERMEABLE FABRIC
 - 100 RIGID INSULATION (R.S.I. 5.28)
 - 4 PLY BUILT-UP ROOF
 - 13 GYPSUM WALL BOARD
 - METAL DECK
 - STEEL JOISTS

MASONRY ANCHORS PROVIDED TOP & BOTTOM OF CONC. 6400 TYPICAL

TYPICAL WALL CONST.
 - 13 GYPSUM WALL BOARD
 - 4 MIL POLY. VAPOUR BARRIER
 - 92 METAL STUD 20x25 Ga. 46 @ 400
 - FIBRE GLASS BATT. INSULATION (R12)
 - 13 PLYWOOD SHEATHING
 - 25 RIGID INSULATION (R.S.I. 1.87)
 - BUILDING PAPER
 - 13 VOID
 - 20 FACE BRICK

NOTE!
 SEE STRUCT. FOR RIM OF TOPPING, HE SLAB, CR BEAMS & PILES.

1 WALL SECTION
 102 | 105

2 WALL SECTION
 102 | 105

3 WALL SECTION
 102 | 105

4 WALL SECTION
 102 | 105

5 WALL SECTION
 104 | 105


6 WALL SECTION
 102 | 105

REVISED AS CONSTRUCTED
 DATE FEB. 14 84 BY CSA
 CHECKED BY C. VEJNIAU

METRIC
 WHOLE NUMBERS INDICATE MILLIMETRES
 DECIMALIZED NUMBERS INDICATE METRES

E. J. GABOURY AND ASSOCIATES
 ARCHITECTS AND URBAN DESIGNERS

NO.	REVISIONS	DATE	APP.
1	ISSUED FOR TENDER	82.05.10	
0	FOR CLIENT REVIEW	22/01/82	

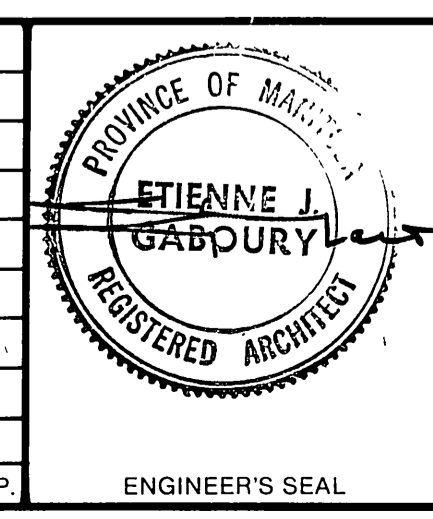

W. L. WARDROP & ASSOCIATES LTD.
MacLAREN ENGINEERS PLANNERS & SCIENTISTS INC.

DESIGNED BY: DC., E.J.G.
 CHECKED BY: D.C.
 APPROVED BY: M. Proquet

DRAWN BY: D.F.C.
 DATE: 82.03.19
 DATE: Mar/82

THE CITY OF WINNIPEG
 WORKS & OPERATIONS DIVISION
 WATERWORKS, WASTE & DISPOSAL DEPARTMENT

**NORTH END WATER POLLUTION CONTROL CENTRE
 SECONDARY TREATMENT EXPANSION
 MAIN BUILDING EXPANSION
 ARCHITECTURAL - WALL SECTIONS**

RELEASED FOR CONSTRUCTION: [Signature] DATE: 1982 05 07
 SCALE: 1:20
 DRAWING NO: NEP 1011

NR 11187