

ROAD RELOCATION
(REFER TO DWG. NEP-1299 FOR DETAILS)

EXIST.
CITY
OFFICE

NOTE:
B.M. DERIVED FROM GEODETIC EL.
231.261, W. SIDE OF MAIN ST. ON THE
NORTH END TREATMENT PLANT,
TBLT., ON TOP OF CONC PIT IN
FRONT OF MAIN BLDG., 22.3m E. OF
LINE OF MOST ELY. WALL AND
18.8m S. OF MOST NLY. WALL OF
MAIN BLDG. (TIES TO TBLT.)


SOUTH PROPERTY LINE

304 SLUDGE FORCEMAIN

FOR SHOP DRAWING INFORMATION
REFER TO THE SHOP DRAWING
CROSS REFERENCE INDEX


AS CONSTRUCTED
APPROVED BY *[Signature]*
DATE 88-03-28

"TO OBTAIN PLANT DATUM SUBTRACT 221.764 METRES"

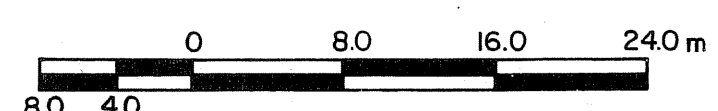

A	DESIGNATION
B	ITEM ORIGIN
C	ITEM LOCATION

NO.	REVISIONS	DATE	APP.
A	REVISED TO AS CONSTRUCTED	8/16/85	[Signature]

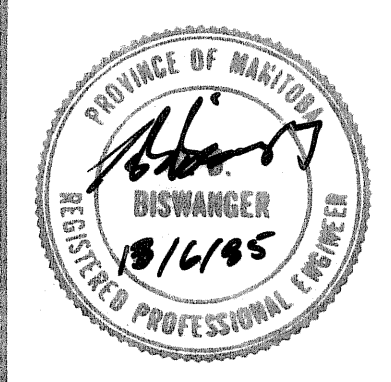

Underwood McLellan Ltd. Consulting Engineers and Planners	
GORE & STORRIE LIMITED CONSULTING ENGINEERS	
DESIGNED BY B. BISWANGER	DRAWN BY B.D.
CHECKED BY D. ROGOWSKY	DATE FEB./85
APPROVED BY <i>[Signature]</i>	DATE JUNE/85

THE CITY OF WINNIPEG

WORKS & OPERATIONS
DIVISION

WATERWORKS, WASTE &
DISPOSAL DEPARTMENT

NORTH END WATER POLLUTION CONTROL CENTRE SLUDGE DIGESTION EXPANSION	
SITE PLAN	
RELEASED FOR CONSTRUCTION <i>[Signature]</i>	DATE 17/16/85
SCALE: AS SHOWN	DRAWING NO.: NEP-1187