


TRAFFIC SERVICES BUILDING



- LEGEND**
- PULL STATION C/W ADDRESSABLE MONITOR MODULE FM-101A
 - ADDRESSABLE MONITOR MODULE FMM-1A
 - ⊙ ADDRESSABLE SMOKE DETECTOR FSP-851A
 - + ADDRESSABLE HEAT DETECTOR FST-851A
 - ⊞ ADDRESSABLE RELAY MODULE FRM-1A
 - 🔊 FIRE ALARM HORN
 - ⎓ END OF LINE RESISTOR
 - ⊕ ADDRESSABLE DUCT SMOKE DETECTOR
 - HLIN#7 ADDRESSABLE DEVICE ADDRESS
 - ⎓ SPRINKLER WATERFLOW SWITCH
 - ⊓ SPRINKLER ISOLATION VALVE
 - ⊞ FIRE ALARM STROBE

BLDG A OVERHAUL/REPAIR SHOP - FIRE ALARM LAYOUT

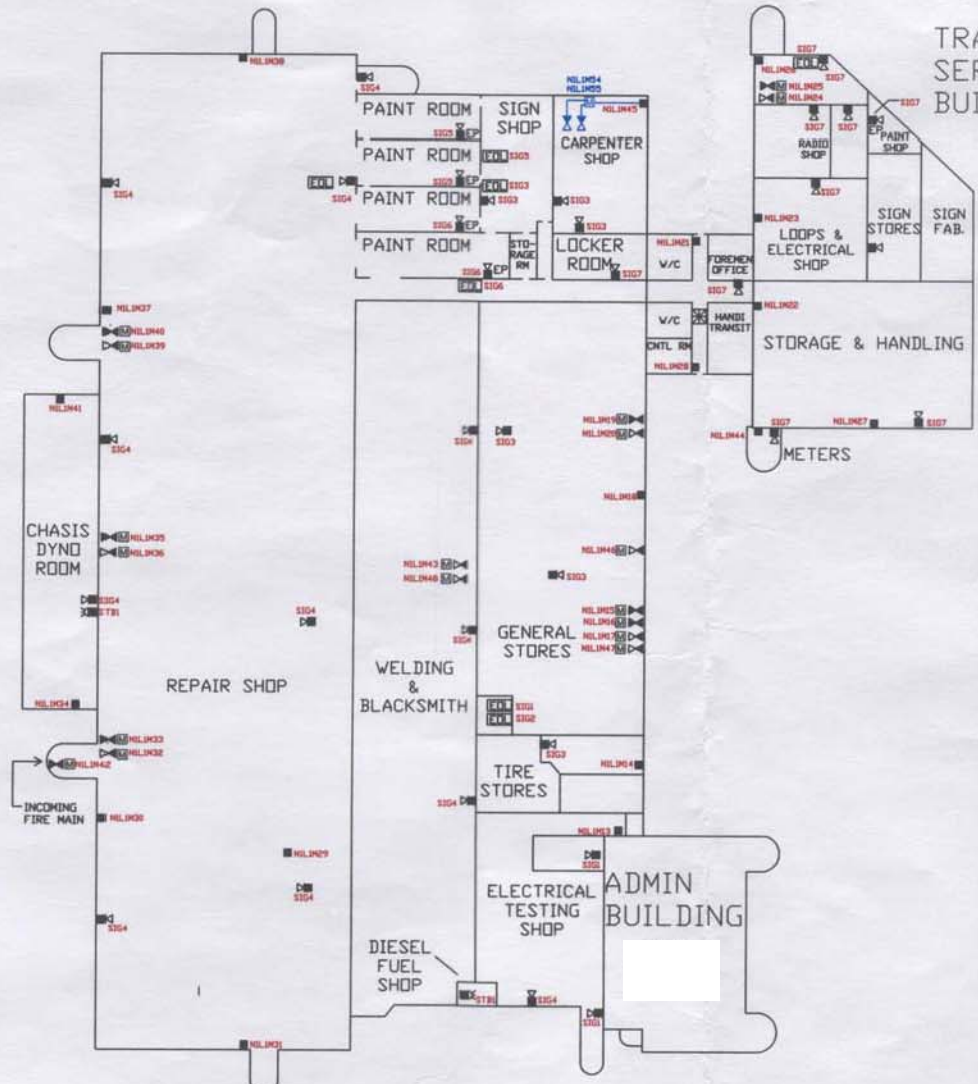

REVISION - OCT. 31/06
 A TAMPON SWITCHES ADDED ON NEW GLEYSOL LOOP IN CARPENTER SHOP.

AS-BUILT
 FROM 2006
 NOR-TEC ELECTRIC LTD.

REV. DATE		DESCRIPTION	BY	DATE
1	2006-04-28	AS-BUILT		

PROJECT	THE CITY OF WINNIPEG TRANSIT GARAGE BLDG A OVERHAUL/REPAIR SHOP
TITLE	FIRE ALARM DETAIL
DRAWN	DATE
CHECKED	SCALE

VIPOND SYSTEMS GROUP
 1110 14th Street S.W. Calgary, Alberta T2C 1S7
 (403) 243-8888