


- 1 SEAL ALL JOINTS OF REMOVEABLE SLAB WITH HOT PITCH.
- 2 HOT GALVANIZE ALL MISCELLANEOUS IRON WORK.

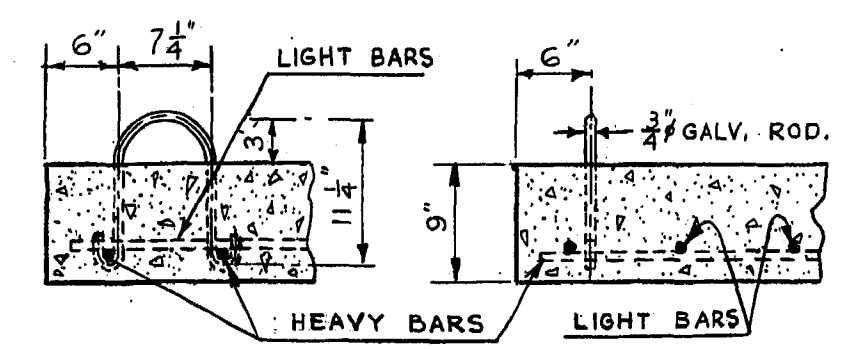

STANDARD LIFTING LUG DETAIL  
SCALE 1"=1'-0"

AS BUILT  
MAR. 1971 V.D.



REVISIONS				THE METROPOLITAN CORPORATION OF GREATER WINNIPEG WATERWORKS & WASTE DISPOSAL DIVISION SEWAGE DISPOSAL BRANCH	
NO.	DESCRIPTION	DATE	BY		
1					
2					
3					
4					
5					
6					
7					
8					

APPROVED BY <i>[Signature]</i> CHIEF ENGINEER	DESIGNED BY <i>[Signature]</i> DATE MAR 1963	CHECKED BY <i>[Signature]</i> DATE MAR 1963	DRAWING NO. <b>445</b>
---	---	--	---------------------------