


*Hauptman*

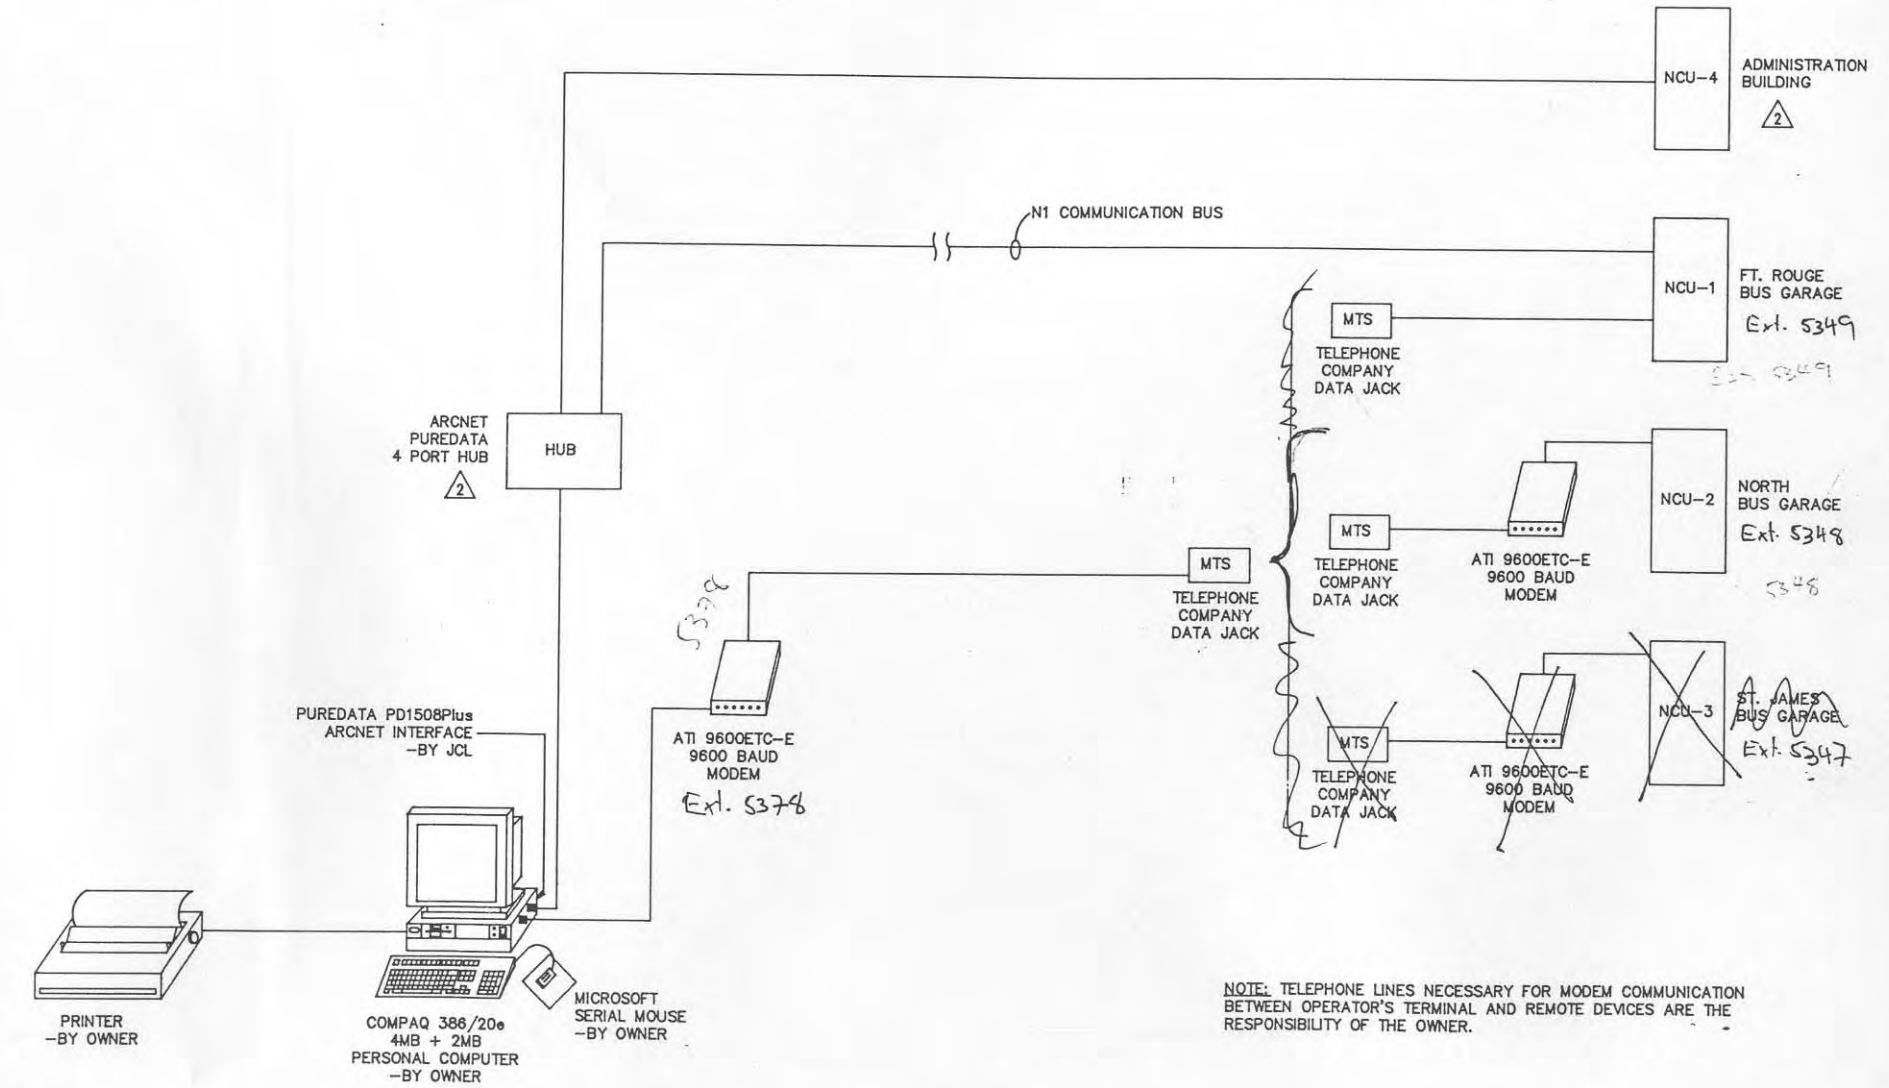

FMS OPERATOR'S TERMINAL EQUIPMENT  
LOCATED IN WINNIPEG TRANSIT OFFICES (421 OSBORNE ST.)

NOTE: TELEPHONE LINES NECESSARY FOR MODEM COMMUNICATION BETWEEN OPERATOR'S TERMINAL AND REMOTE DEVICES ARE THE RESPONSIBILITY OF THE OWNER.

DRAWING TITLE FACILITY MANAGEMENT SYSTEM OPERATOR INTERFACE		AS BUILT 2 1098-5006		08/17/92 CMR	
AS BUILT 1 0098-0310		REVISION-LOCATION		08/28/91 JF	
SALES ENGR PROJECT MGR APPL ENGR		DRAWN		APPROVED	
PROJECT WINNIPEG TRANSIT METASTIS FACILITY MANAGEMENT SYSTEM		JAHNSON CONTROLS Systems & Services Division		CONTRACT NUMBER 90098-0310	
DRAWING NUMBER 1501-47		JAHNSON CONTROLS LTD 800 MURRAY STREET WINNIPEG, MANITOBA R3J 3Y9 204-885-8380		DRAWING NUMBER 1501-47	