


JOHNSON CONTROLS AS-UNT111-0 CONTROLLER

ADDR #16  
SF-2 SYSTEM

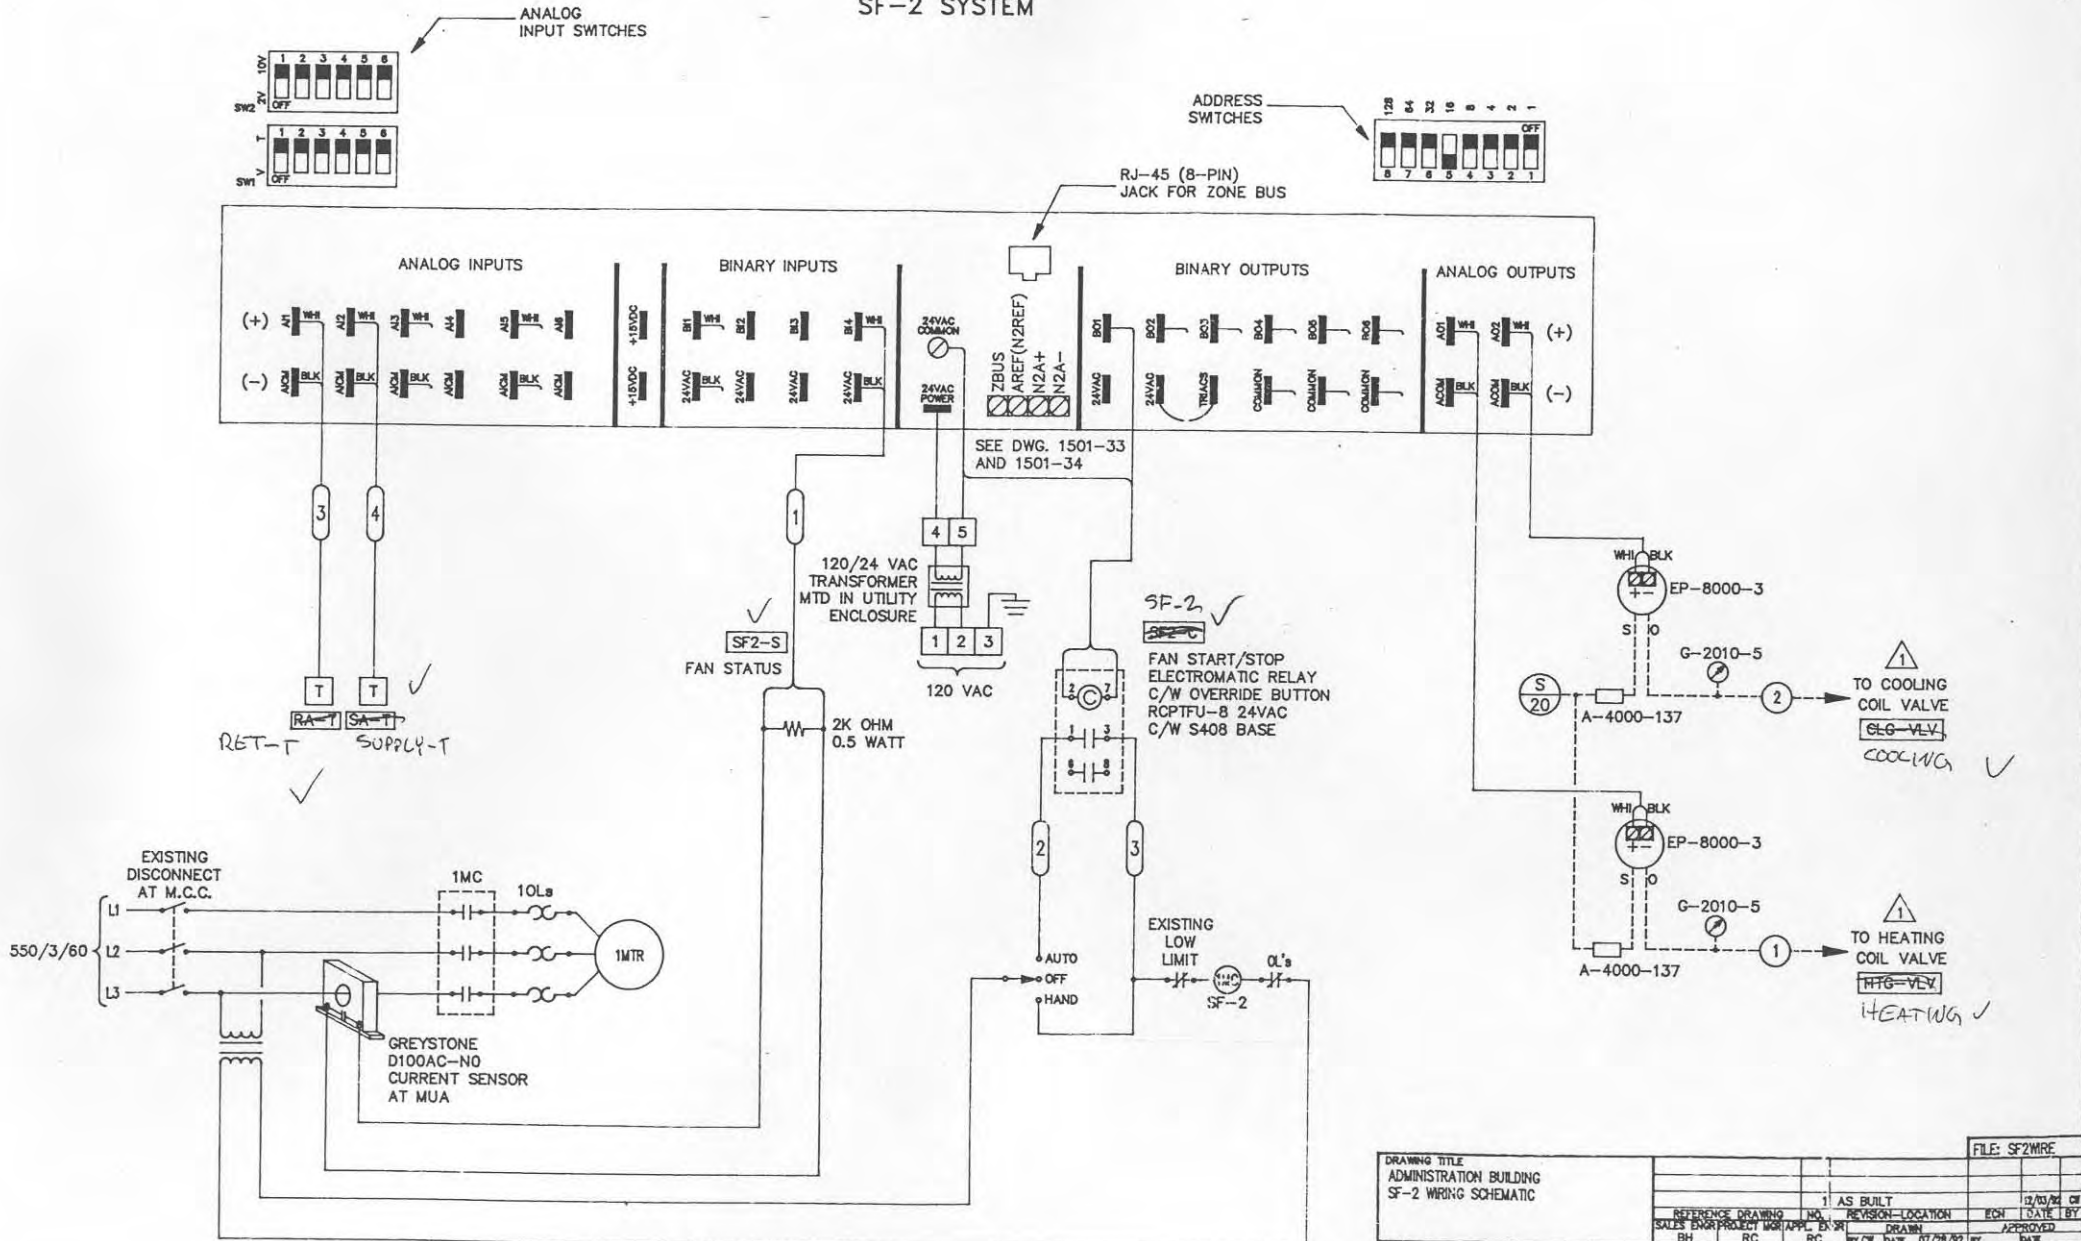

DRAWING TITLE ADMINISTRATION BUILDING SF-2 WIRING SCHEMATIC		1 AS BUILT		12/10/82	BY
REFERENCE DRAWING NO.	REVISION-LOCATION	DATE	BY	APPROVED	
BH	RC	RC	BY DATE 07/28/82	DATE	
PROJECT WINNIEG TRANSIT INFRARED AND SF-2 421 OSBORNE STREET WINNIEG, MANITOBA	 JOHNSON CONTROLS Systems & Services Division		JOHNSON CONTROLS LTD 800 MORAY STREET WINNIEG, MANITOBA R3J 3J9	CONTRACT NUMBER 92098-5007	DRAWING NUMBER 1501-49