


SEE DRAWING NO. D-2073 FOR CELL 3 OUTLET PIPING DETAILS

MATCH EXISTING DITCH

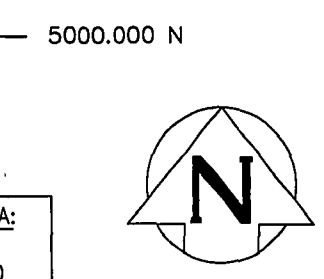

CURVE DATA:
 $\Delta = 90^\circ$
 $R = 90.000$
 $T = 90.000$

CURVE DATA:
 $\Delta = 90^\circ$
 $R = 90.000$
 $T = 90.000$

EXTERIOR TOE OF EMBANKMENT
 TOP OF EMBANKMENT AND EDGE OF ROADWAY
 TOP OF EMBANKMENT AND EDGE OF ROADWAY
 INTERIOR TOE OF EMBANKMENT

RELOCATED PROVINCIAL DITCH

SEE DRAWING NO. D-2037 FOR INLET PIPING DETAILS

SEE DRAWING NO. D-2054 FOR INTERCONNECTING PIPE NORTH DETAILS

SEE DRAWING NO. D-2055 FOR INTERCONNECTING PIPE SOUTH DETAILS

CONTRACTOR TO FILL DEPRESSIONS

SEE DRAWING NO. D-2105 FOR DRAINAGE PUMP STATION DISCHARGE DITCH DETAILS

SEE DRAWING NO. D-2021 FOR SECTION A-A

4100.000 E
 4200.000 E
 4300.000 E
 4400.000 E
 4500.000 E
 4600.000 E
 4700.000 E
 4800.000 E
 4900.000 E
 5000.000 E
 5100.000 E

5000.000 N
 4900.000 N
 4800.000 N
 4700.000 N
 4600.000 N
 4500.000 N
 4400.000 N
 4300.000 N
 4200.000 N

LEGEND:

- 235.200 PROPOSED EMBANKMENT GRADE
- CONSTRUCTION CONTROL MONUMENT
- HYDRO POLE
- PROPOSED CONTOUR
- STOCKPILE/SPOIL AREA
- G.W.W.D. RAILWAY
- AQUEDUCT
- CONTOUR (GEODETIC IN METERS)
- TREED AREA

METRIC
 WHOLE NUMBERS INDICATE MILLIMETRES
 DECIMALIZED NUMBERS INDICATE METRES

DESIGNED BY		CT		CHECKED BY		CT/KMD	
DRAWN BY		EN/MBD		APPROVED BY		JEC	
HOR. SCALE		1:2000		RELEASED FOR CONSTRUCTION			
VERTICAL		1:2000		DATE		1995 01 20	
NO. REVISIONS		DATE		BY		DATE	
1		REVISED TO AS-BUILT		98.08.14		TM	

ENGINEER'S SEAL
 ORIGINAL SIGNED BY
 J. E. COMEAU
 1995.01.30
 TENDER 95-2
 AUTOCADR2000



THE CITY OF WINNIPEG
 WORKS AND OPERATIONS DIVISION
 WATERWORKS WASTE AND DISPOSAL DEPARTMENT

DEACON RESERVOIR EXPANSION
 CONSTRUCTION OF CELL 3 AND CELL 4
 CELL 3 EMBANKMENT LOCATION,
 STOCKPILE/SPOIL AREA AND
 BORROW EXCAVATION AREA

SHEET OF
 CITY DRAWING NUMBER
D-2013

AS-CONSTRUCTED
Salma K. Walker 01.09.27
 CONTRACT ADMINISTRATION DRAFTING & GRAPHIC SERVICES DATE
 WATER AND WASTE DEPARTMENT

