


SEE DRAWING NO. D-2054 FOR INTERCONNECTING PIPE NORTH DETAILS

SEE DRAWING NO. D-2022 FOR SECTION B-B

SEE DRAWING NO. D-2055 FOR INTERCONNECTING PIPE SOUTH DETAILS

SEE DRAWING NO. D-2038 FOR INLET PIPING DETAILS

AS-CONSTRUCTED
John S. Colton 01.09.27
 CONTRACT ADMINISTRATION DRAFTING & GRAPHIC SERVICES DATE
 WATER AND WASTE DEPARTMENT

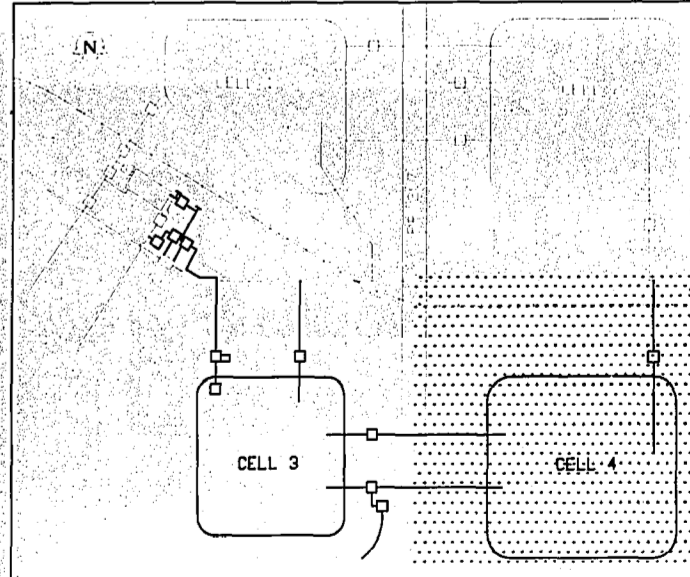

LEGEND:

- 235.200 PROPOSED EMBANKMENT GRADE
- PROPOSED CONTOUR
- ⊕ CONSTRUCTION CONTROL MONUMENT
- HYDRO POLE
- ⊕ HYDRO TOWER
- ⊕ LEGAL SURVEY BAR
- G.W.W.D. RAILWAY
- ⊕ AQUEDUCT
- CONTOUR (IN GEODETIC METERS)
- ☁ TREED AREA
- LIMIT OF BORROW EXCAVATION IF REQUIRED, ENSURE SLOPE TO DRAINAGE CHANNEL.

METRIC

WHOLE NUMBERS INDICATE MILLIMETRES
 DECIMALIZED NUMBERS INDICATE METRES

NO.	REVISIONS	DATE	BY
1	REVISED TO AS-BUILT	98.08.14	TM

Prepared By
The Engineering Division of the Waterworks, Waste and Disposal Department

DESIGNED BY	CT	CHECKED BY	CT/KMD
DRAWN BY	REF/TM	APPROVED BY	JEC
HOR. SCALE	1 : 2000	RELEASED FOR CONSTRUCTION	
VERTICAL		DATE	1995 01 20

ENGINEER'S SEAL
 ORIGINAL SIGNED BY
 J. E. COMEAU
 1995.01.30
 TENDER 95-2
 AUTOCADR2000

THE CITY OF WINNIPEG
 WORKS AND OPERATIONS DIVISION
 WATERWORKS WASTE AND DISPOSAL DEPARTMENT

DEACON RESERVOIR EXPANSION
 CONSTRUCTION OF CELL 3 AND CELL 4

CELL 4 EMBANKMENT LOCATION
 AND BORROW EXCAVATION AREA

SHEET OF
 CITY DRAWING NUMBER
D-2014