

DEACON RESERVOIR CELL I

16" 18" 145A CMP  
 CW FLAP GATE  
 E INV. = 776.96  
 N INV. = 776.56

CORNER FENCE POST  
 26+17.7N  
 27+55.0E

OBSERVATION WELL  
 25+00N  
 26+30.0E

FOR DETAILS OF OBSERVATION WELLS SEE DWG. D-1338

EAST LIMIT OF CITY OF WINNIPEG PROPERTY AT STA. 27+56E

NORTH LIMIT OF BORROW & SPOIL SITE APPROXIMATELY STA. 13+95N

DITCH GRADE = 0.026%

SPOIL & BORROW SITE

- DEACON RESERVOIR CELL II DRAWINGS
- D-1334 Inlet Piping
  - D-1335 Aqueduct Connection
  - D-1336 Drain Piping
  - D-1337 Inlet Valve Chamber
  - D-1338 Dike X - Section
  - D-1339 Cell Interconnection Box Culverts
  - D-1340 Miscellaneous Details
  - D-1341 Access Road
  - D-1342 Access Ramp Details
  - D-1343 Fence Details
  - D-1344 Inlet Valve Building
  - D-1345 Box Culvert Gate Chamber
  - D-1346 Location Plan
  - G-125 Topographical Site Plan
  - G-128 Site Plan

NOTE THIS PLAN SHOWS VARYING DEPTHS OF CLAY CUT OFF AT TOE OF SLOPE AS PER DWS. D-1338

COORDINATE ARE SET AT INSIDE SHOULDER OF ROAD AT 10+00 AND 20+00 COORDINATES ON EACH DYKE

2	REVISED TO AS-BUILT	79 02 01 R.F.	
1	WEST DIKE RELOCATED 100' EAST	25 5 77 R.F.	
NO.	DESCRIPTION	DATE	BY
<b>REVISIONS</b>			
FIELD BOOKS NO. F-457, F-474	SURVEYED BY R.J.		
LAND SURVEY PLAN NO. 1474-2269, 3364-1344	DATE AUGUST 1976		
B.M.			

**The City of Winnipeg**  
 Waterworks, Waste and Disposal Division

ENGINEERING BRANCH  
 WATERWORKS

**DEACON RESERVOIR CELL II**  
 SITE PLAN


DESIGNED BY PDW & R.B.  
 CHECKED BY R.J.  
 DATE 4-APR-77

DRAWN BY R.F.  
 DATE 4-APR-77

APPROVED BY [Signature]  
 DATE 18/4/77

SCALE 1" = 100'

DRAWING NO. G-128

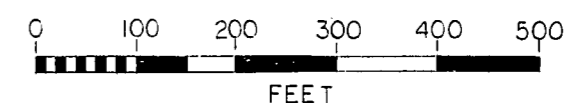

D. Scott Walsh 79 02 19