



SLUDGE GAS PIPING SCHEMATIC (TYPICAL)


- LEGEND**
- NEW VALVE
  - EXISTING VALVE
  - PRESSURE RELIEF VALVE
  - REDUCER
  - FLEXIBLE CONNECTION
  - ORIFICE PLATE
  - PRESSURE TRANSDUCER
  - FLOW INDICATOR
  - PRESSURE GAUGE AND SHUT OFF VALVE

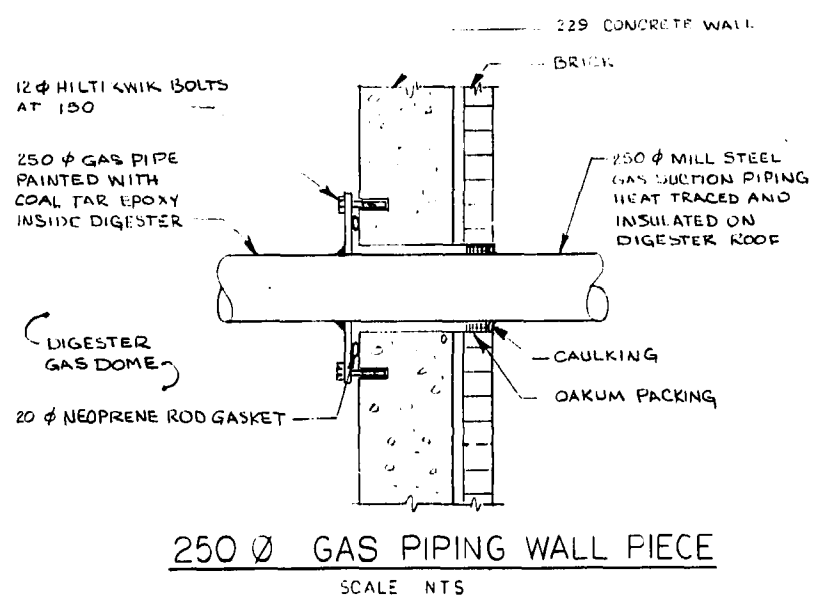


250 Ø GAS PIPING WALL PIECE SCALE NTS

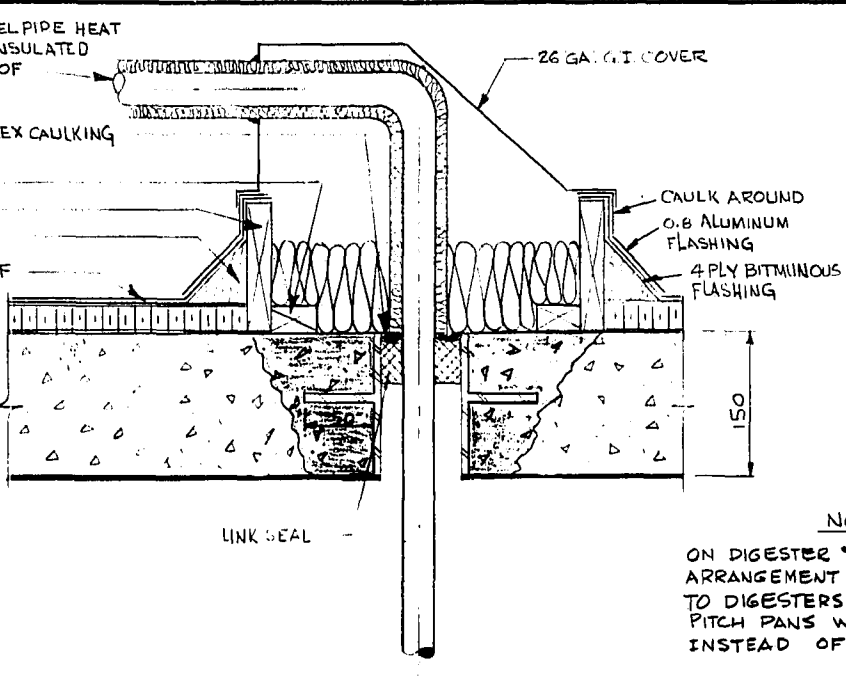


SLEEVE FOR GAS PIPING THROUGH GALLERY ROOF NTS DIGESTERS #9, 11 & 12

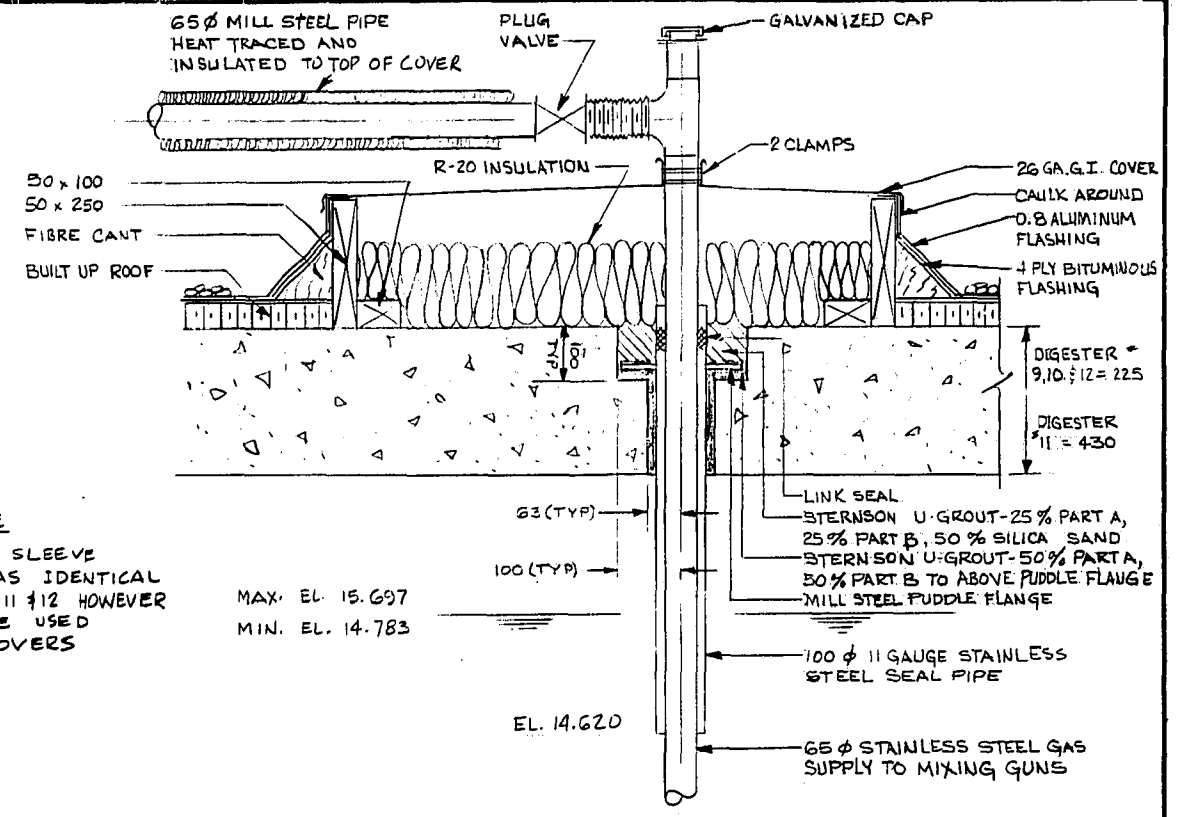

SLEEVE FOR GAS PIPING THROUGH DIGESTER ROOF NTS DIGESTERS #9, 11 & 12

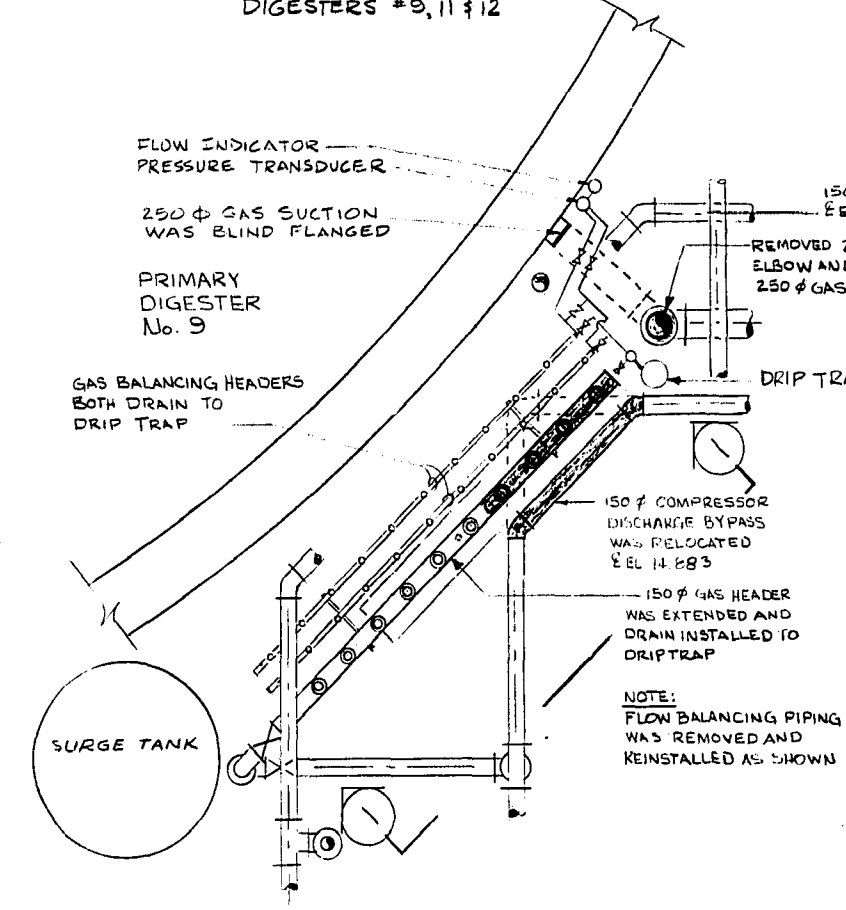


PLAN OF FLOW BALANCING SYSTEM SCALE: 1:50

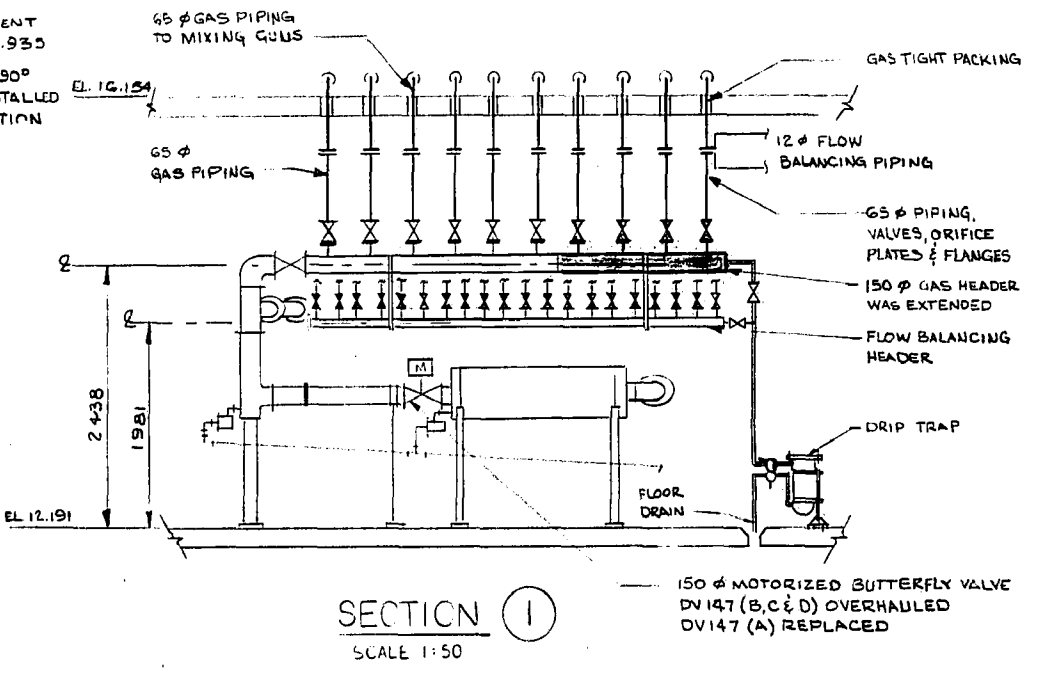


SECTION 1 SCALE 1:50

NOTE  
GAS ROOM IS CLASSIFIED AS A HAZARDOUS AREA CLASS 1 DIVISION 2 GROUP D

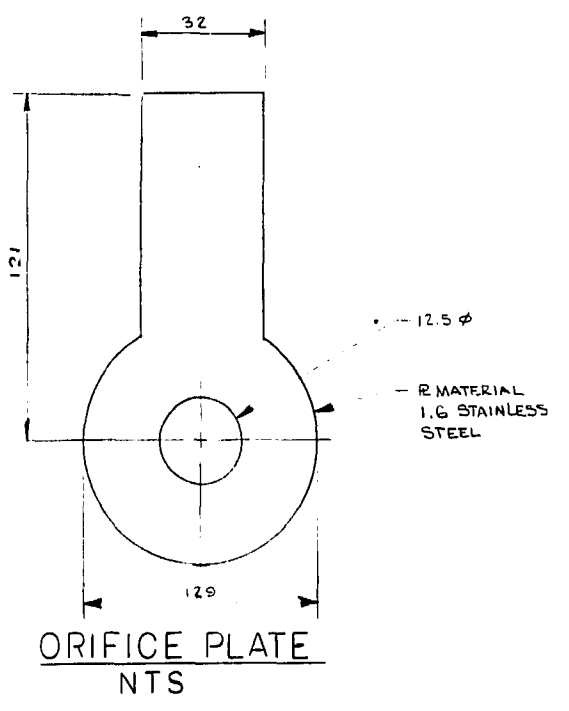

ORIFICE PLATE NTS

NO	REVISIONS	DATE	APP
1	REVISED TO AS-BUILT	FEB 83	CJA

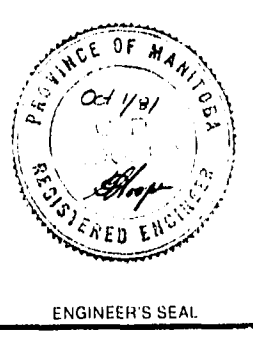

<b>Maclaren</b>	
DESIGNED BY GDH/CJA	DRAWN BY CVC
CHECKED BY GR	DATE OCTOBER 2, 1981
APPROVED BY <i>[Signature]</i>	DATE Oct 7/81

AS BUILT



<b>SI</b> METRIC PROJECT DIMENSIONS IN MILLIMETRES EXCEPT AS NOTED ELEVATIONS IN METRES	
NORTH END WATER POLLUTION CONTROL CENTRE SLUDGE GAS RECIRCULATION SYSTEM SCHEMATIC & DETAILS	
RELEASED FOR CONSTRUCTION	DATE Oct 1/81
SCALE AS NOTED	DRAWING NO. NEP-1004