
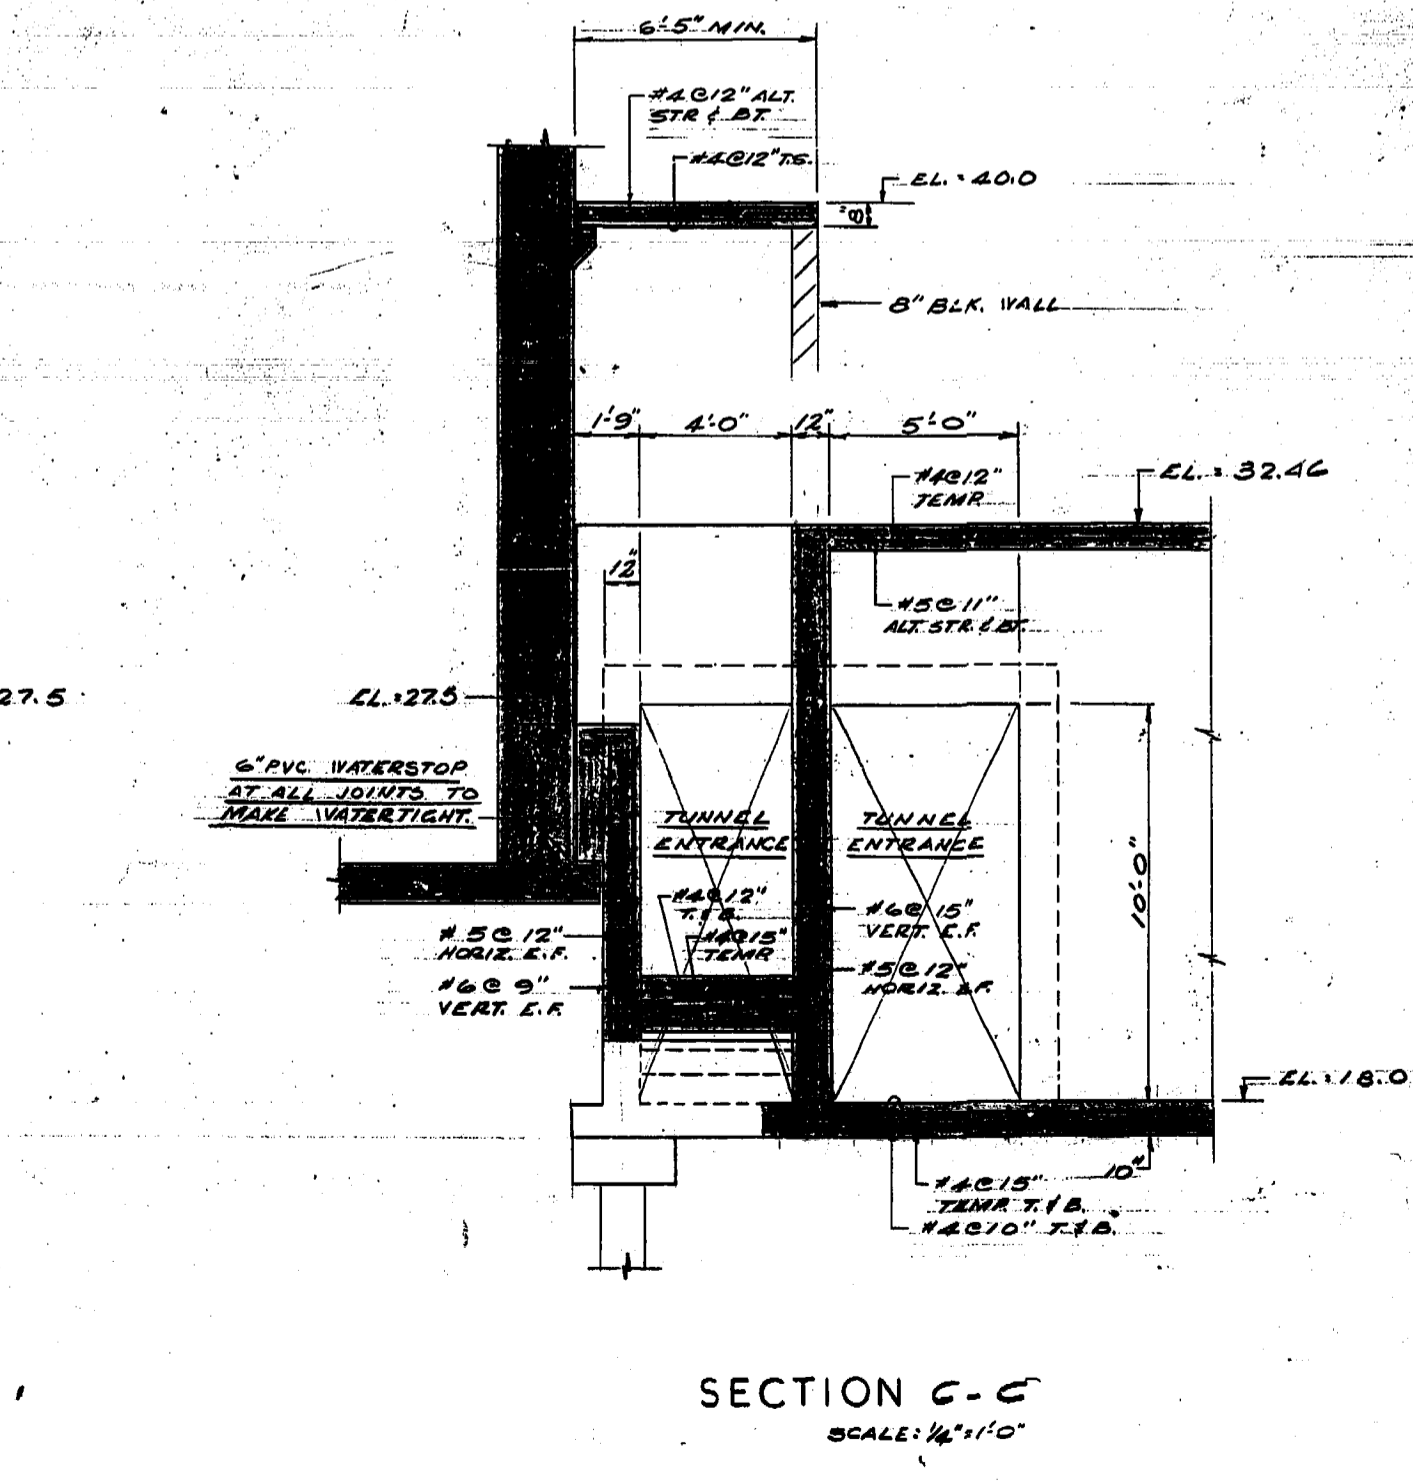
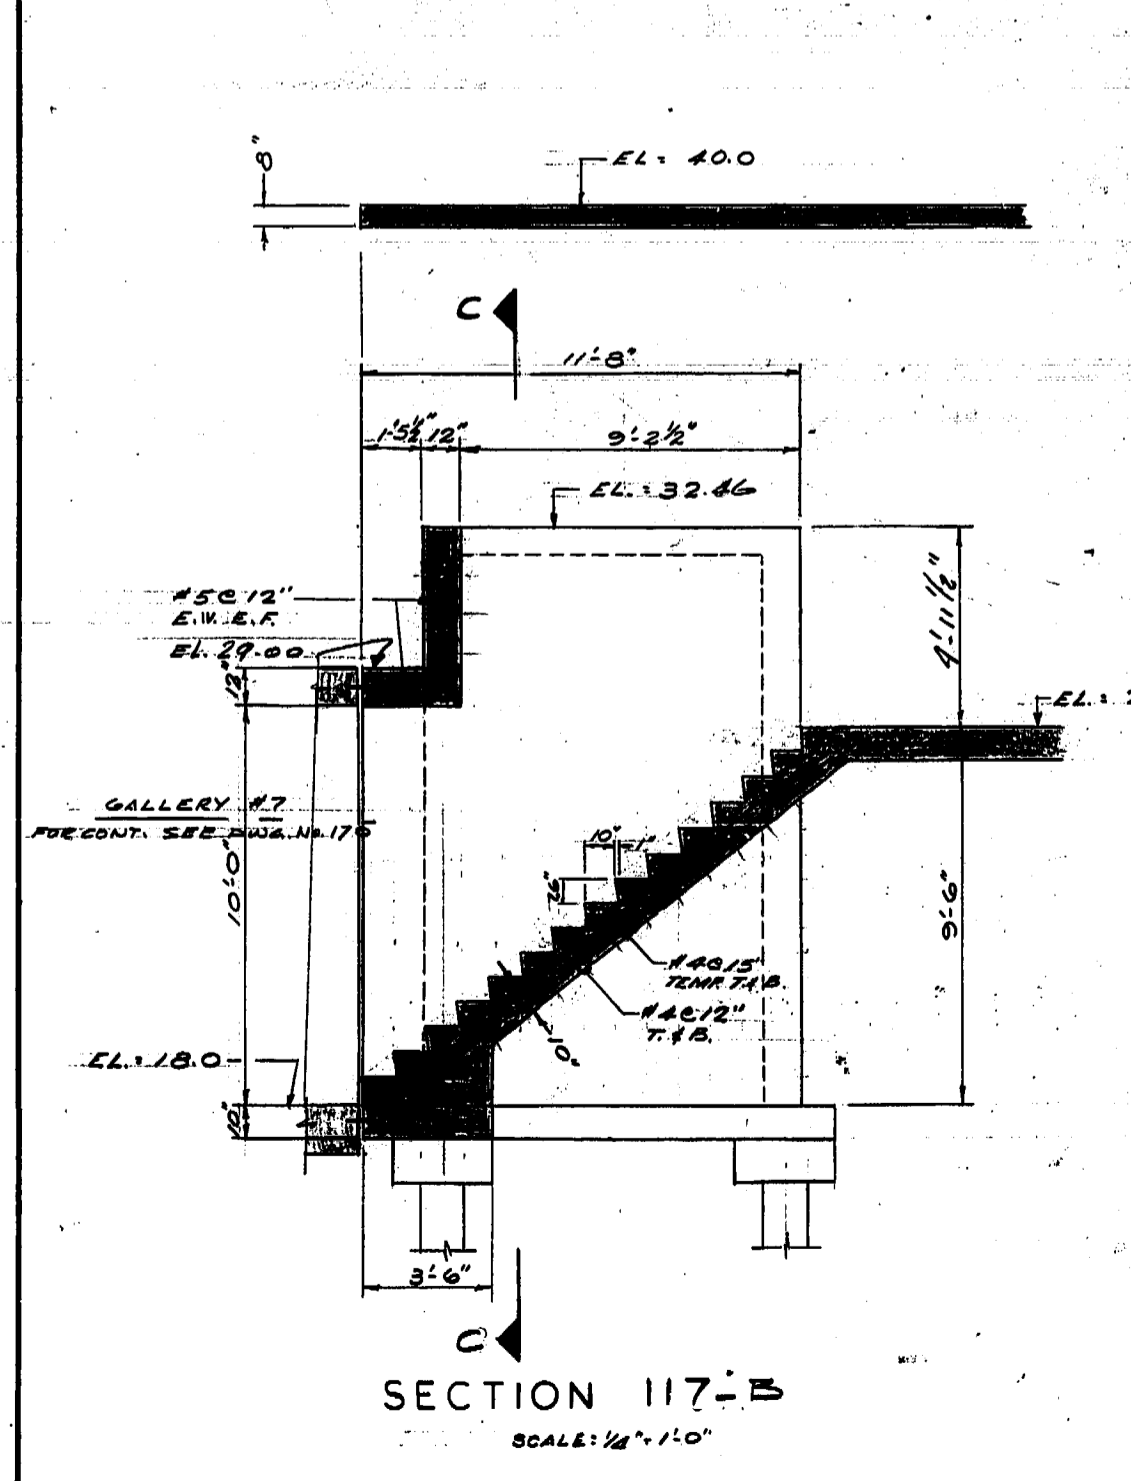


ENTRANCE ROOF BEAM SCHEDULE

MARK	SIZE W/D	REINFORCING		STIRRUPS
		BOTTOM	TOP	
EB-301	12" x 24"	1-#7 2-#6	2-#6	#3 @ 12"
EB-302	12" x 26"	2-#7 2-#6	2-#6	Do
EB-303	12" x 24"	2-#7 2-#8	2-#6	#4-506, 508" E.L. REINB 12"
EB-304	12" x 26"	2-#6	2-#6	#3 @ 12"

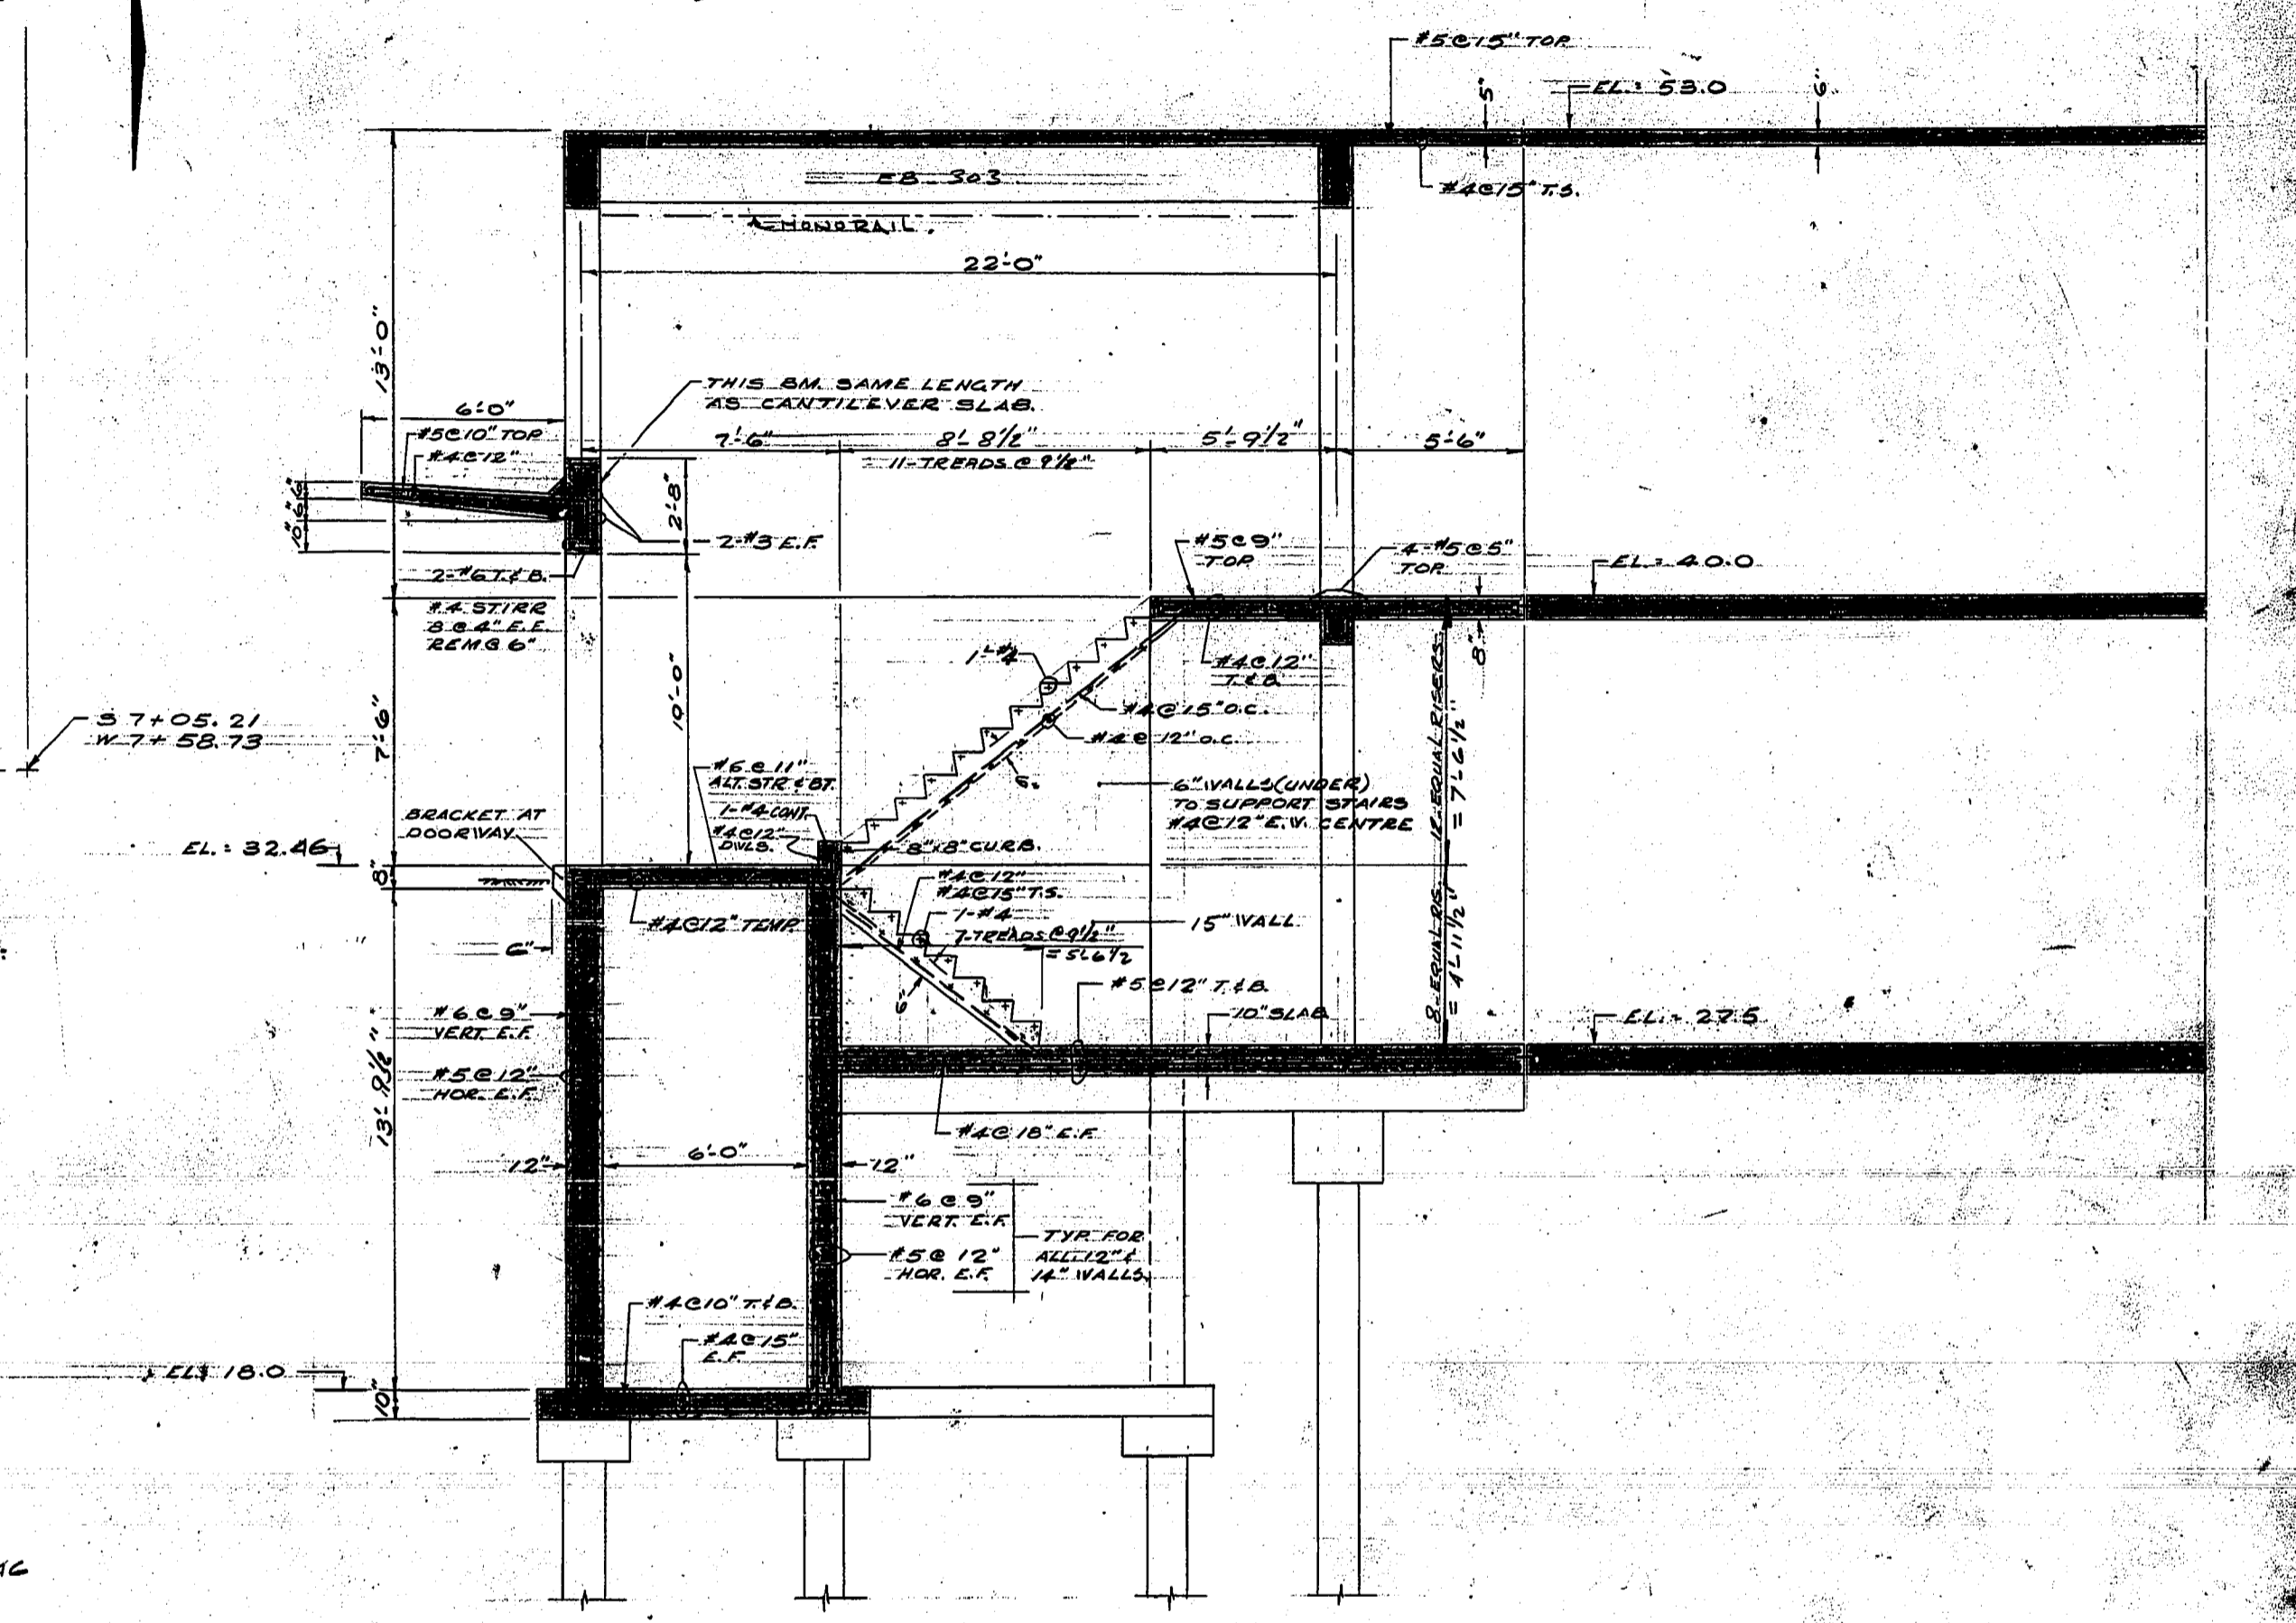

REVISIONS

No.	DATE	DETAIL

THE METROPOLITAN CORPORATION OF GREATER WINNIPEG  
WATERWORKS AND WASTE DISPOSAL DIVISION

NORTH END SEWAGE TREATMENT PLANT  
CONTRACT A - DIGESTION AREA  
STRUCTURAL - GALLERY No. 5  
ENTRANCE ROOF PLAN & SECTIONS

APPROVED  
J. W. MacLAREN  
REGISTERED ENGINEER

D. R. GRIMES  
REGISTERED ENGINEER

DATE: MARCH 11, 1963  
SCALE: AS SHOWN  
DWG. No. 117 OF 217  
NEP-117

FOR ACTUAL ELEV.  
SUBTRACT 0.37 FT.  
**AS BUILT**