


A DESIGNATION
B ITEM ORIGIN
C ITEM LOCATION

FOR SHOP DRAWING INFORMATION REFER TO THE SHOP DRAWING CROSS REFERENCE INDEX

AS CONSTRUCTED
APPROVED BY: [Signature]
DATE: 11/88 03-26

"TO OBTAIN PLANT DATUM SUBTRACT 221.764 METRES"

NO.	REVISIONS	DATE	APP.
1	REVISED TO AS CONSTRUCTED	2/1/88	[Signature]

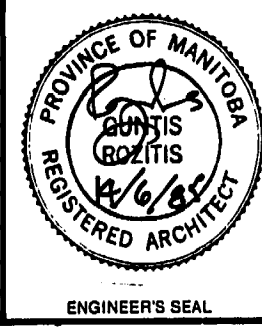

Underwood McLellan Ltd.
Consulting Engineers and Planners
GORE & STORRIE LIMITED
CONSULTING ENGINEERS

DESIGNED BY: G. ROZITIS
DRAWN BY: J.R.C.
CHECKED BY: G. ROZITIS
DATE: FEB./85
APPROVED BY: [Signature]
DATE: JUNE/85

THE CITY OF WINNIPEG
WORKS & OPERATIONS DIVISION
WATERWORKS, WASTE & DISPOSAL DEPARTMENT

NORTH END WATER POLLUTION CONTROL CENTRE SLUDGE DIGESTION EXPANSION

ROOF SECTIONS WALL EXPANSION JOINT DETAILS

RELEASED FOR CONSTRUCTION: [Signature]
DATE: 11/16/85

SCALE: AS SHOWN
DRAWING NO.: **NEP-1228**