



PLAN AT ELEV. 233.600

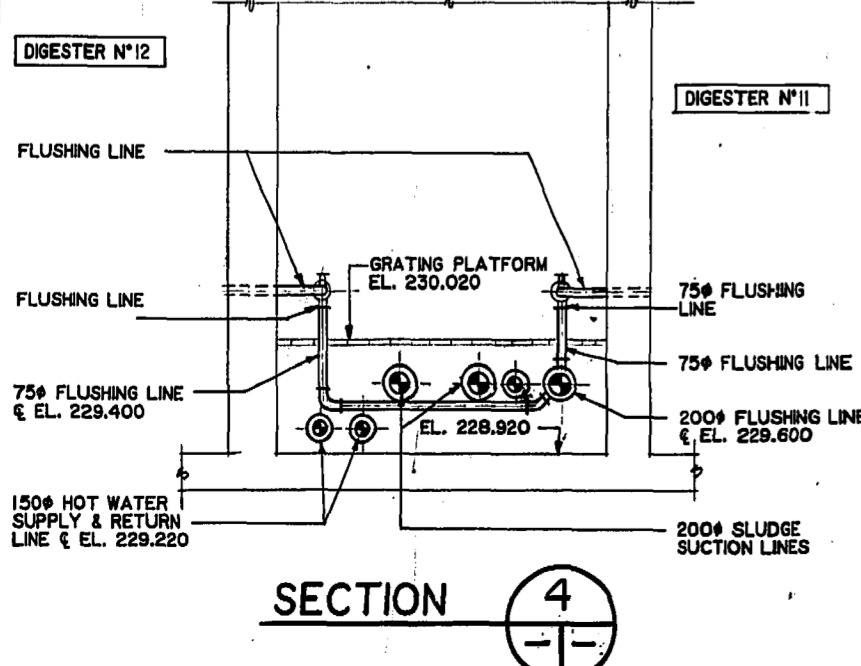


SECTION 4

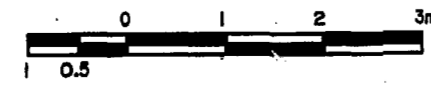

A	DESIGNATION
B	ITEM ORIGIN
C	ITEM LOCATION

- LEGEND
- EXISTING PIPING, VALVES, EQUIPMENT & STRUCTURE
 - NEW PIPING, VALVES, EQUIPMENT & STRUCTURE

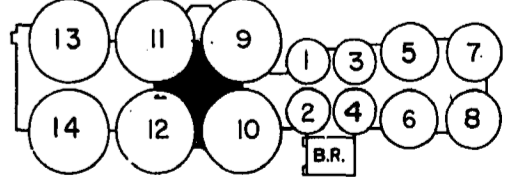


AS CONSTRUCTED
 APPROVED BY: [Signature]
 DATE: 1988-03-26

FOR SHOP DRAWING INFORMATION REFER TO THE SHOP DRAWING CROSS REFERENCE INDEX

"TO OBTAIN PLANT DATUM SUBTRACT 221.764 METRES"

NO.	REVISIONS	DATE	APP.
1	REVISED TO AS CONSTRUCTED	17/6/85	[Signature]

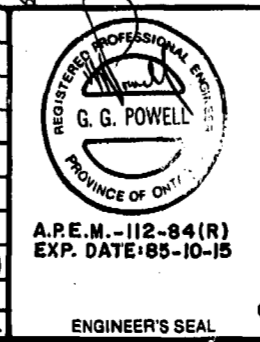

Underwood McLellan Ltd.
 Consulting Engineers and Planners
GORE & STORRIE LIMITED
 CONSULTING ENGINEERS

DESIGNED BY: M. MISTRY
 CHECKED BY: J. CHENG
 APPROVED BY: [Signature]

DRAWN BY: S.N.
 DATE: JUNE / 85
 DATE: JUNE / 85

THE CITY OF WINNIPEG
 WORKS & OPERATIONS DIVISION
 WATERWORKS, WASTE & DISPOSAL DEPARTMENT

NORTH END WATER POLLUTION CONTROL CENTRE
 SLUDGE DIGESTION EXPANSION

DIGESTION GALLERY No. 5
 PROCESS (LEVEL 230.020)
 ALTERATIONS

RELEASED FOR CONSTRUCTION: [Signature] DATE: 17/6/85
 SCALE: AS NOTED DRAWING NO.: **NEP-1253**