

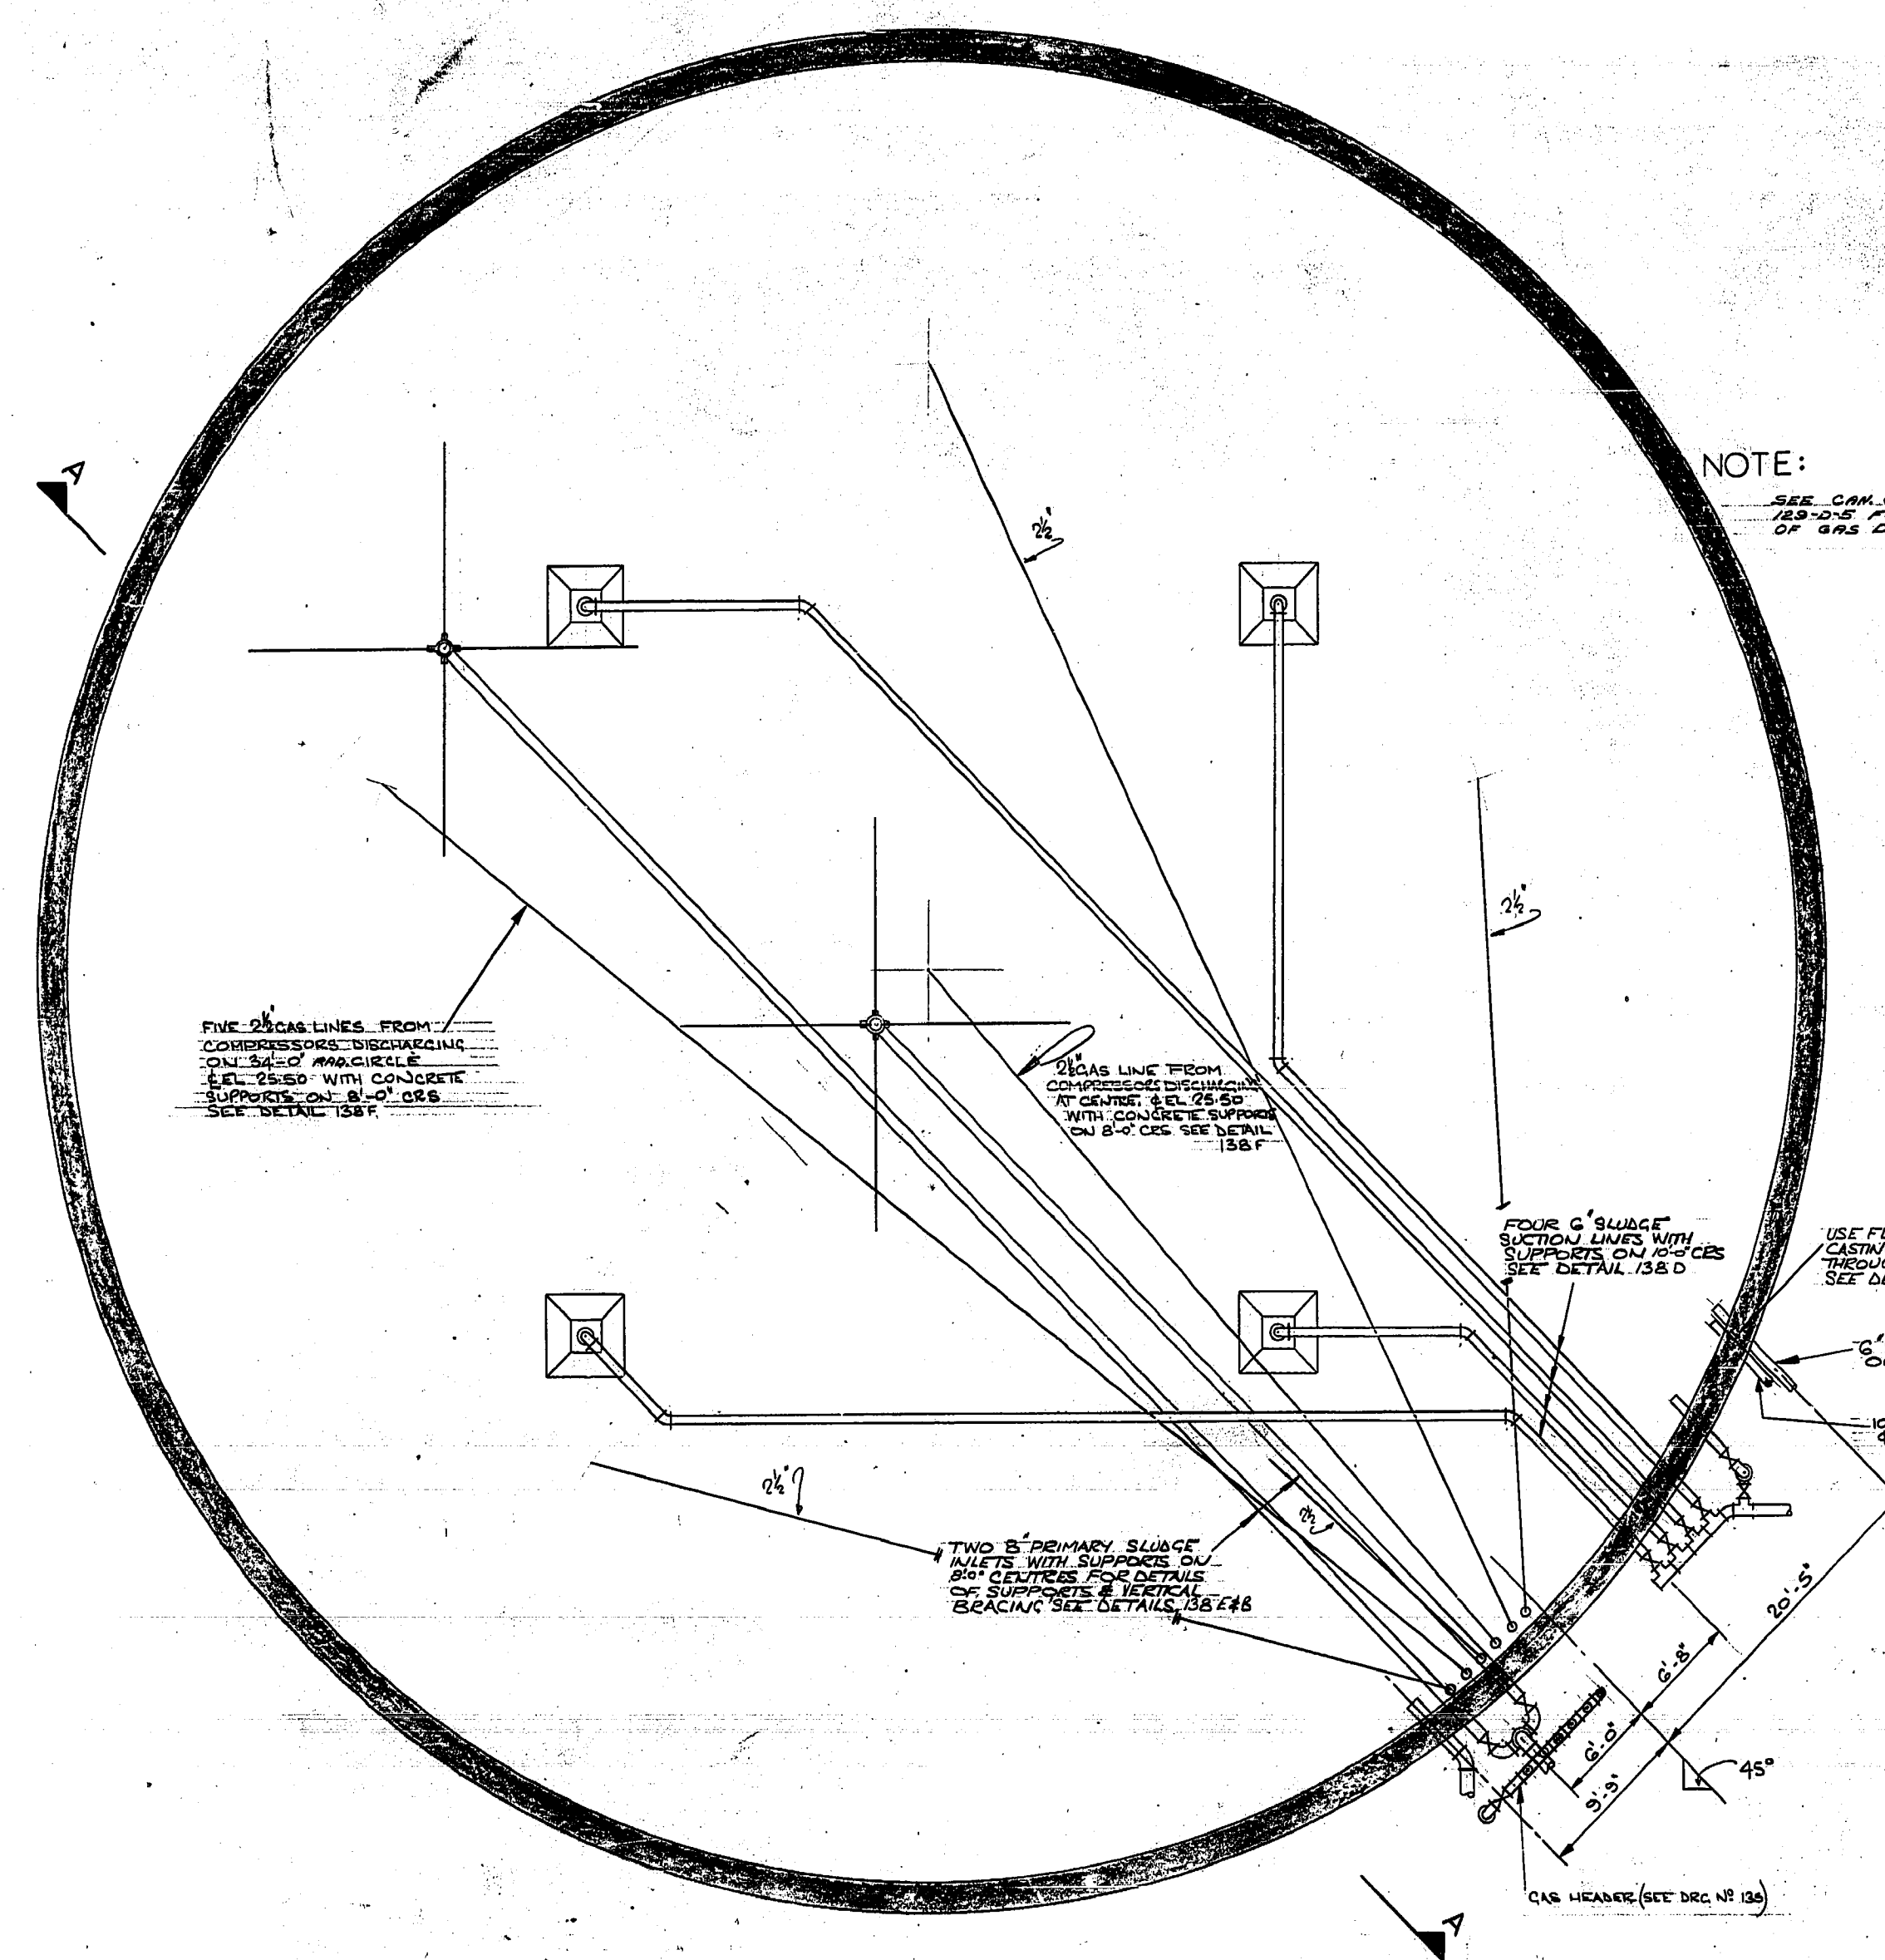
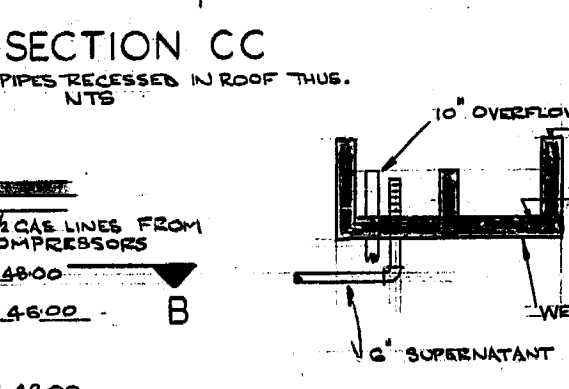
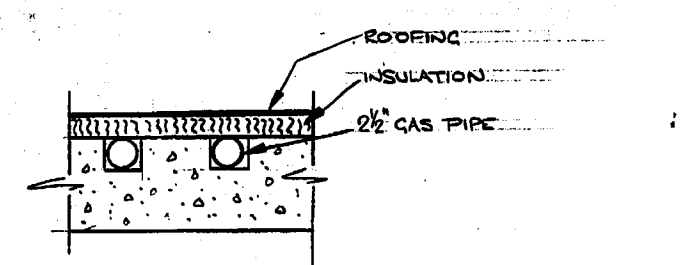


Ref. Drawing No. N.E.P.-137

DETAILS


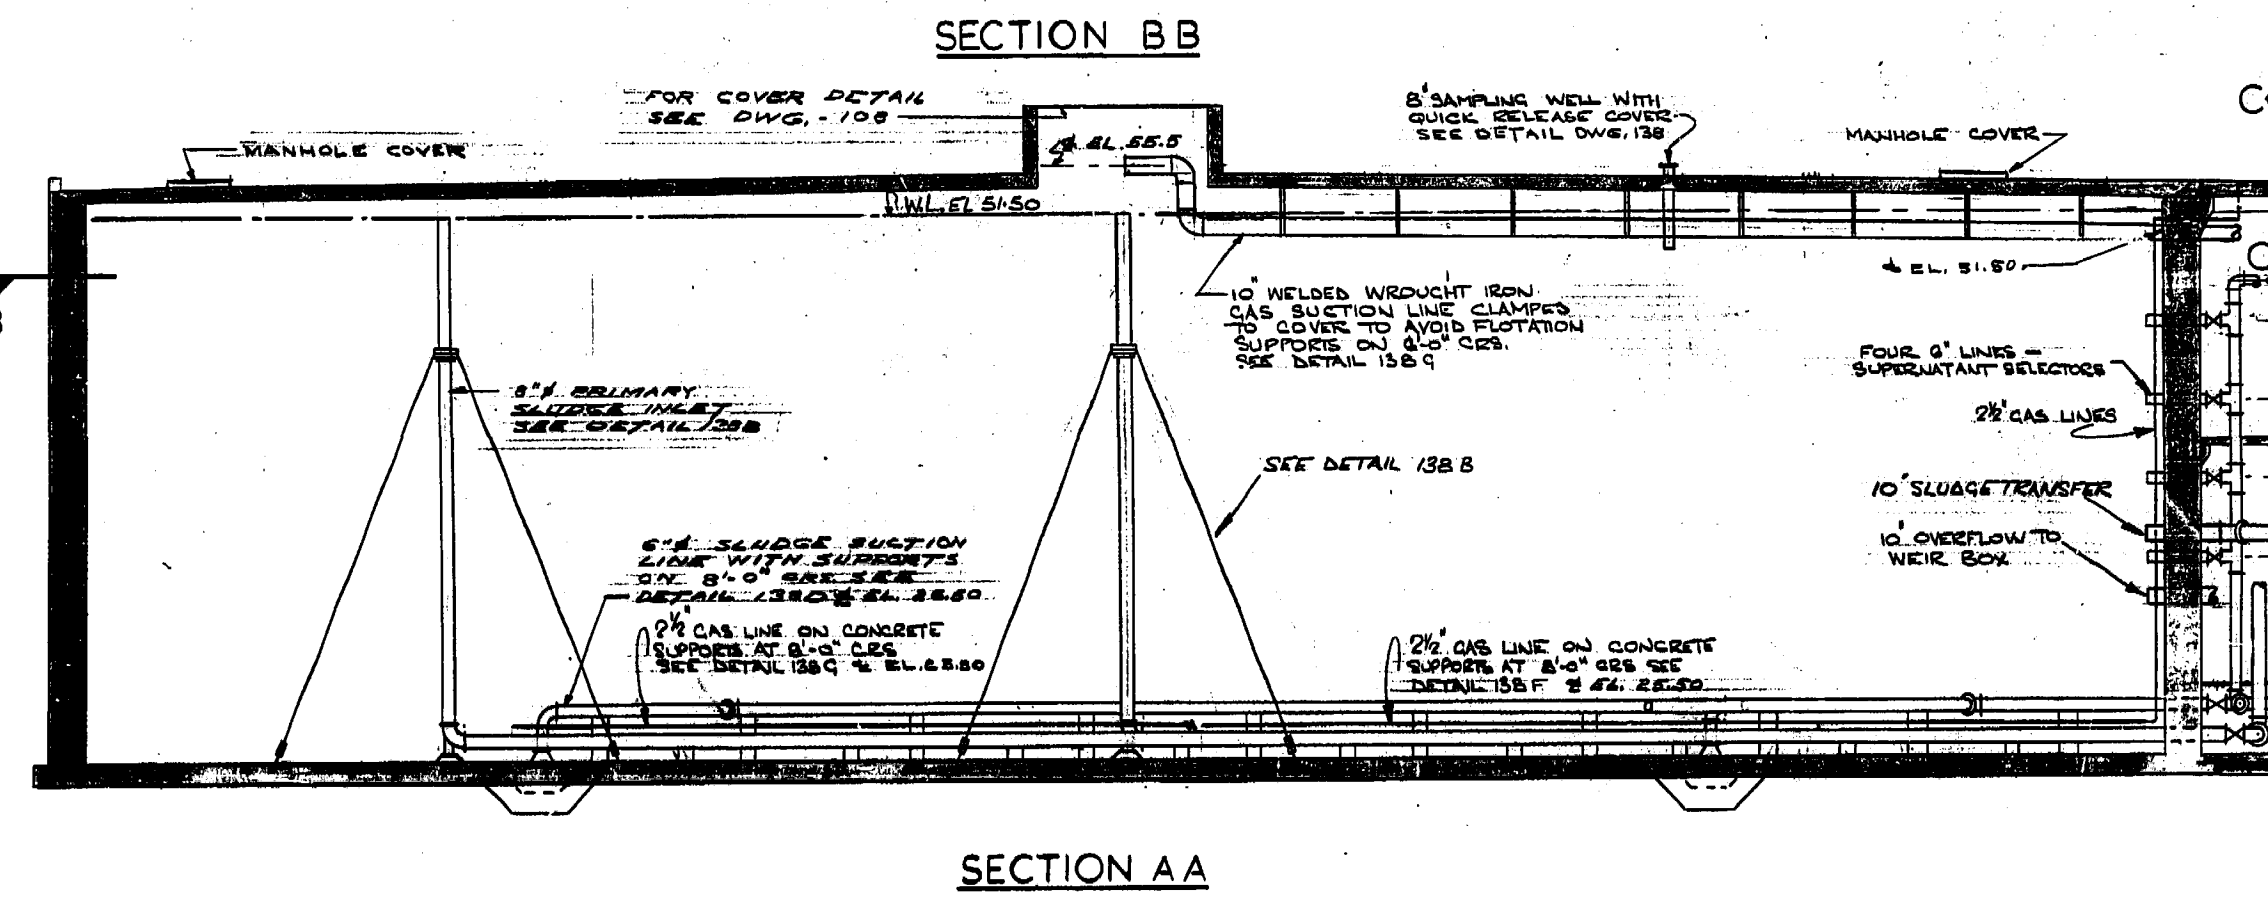


NOTE:
SEE CAN. COMSTOCK DWG. FILE NO. 189-0-5 FOR AS-BUILT LOCATION OF GAS DISTRIBUTION PIPING.

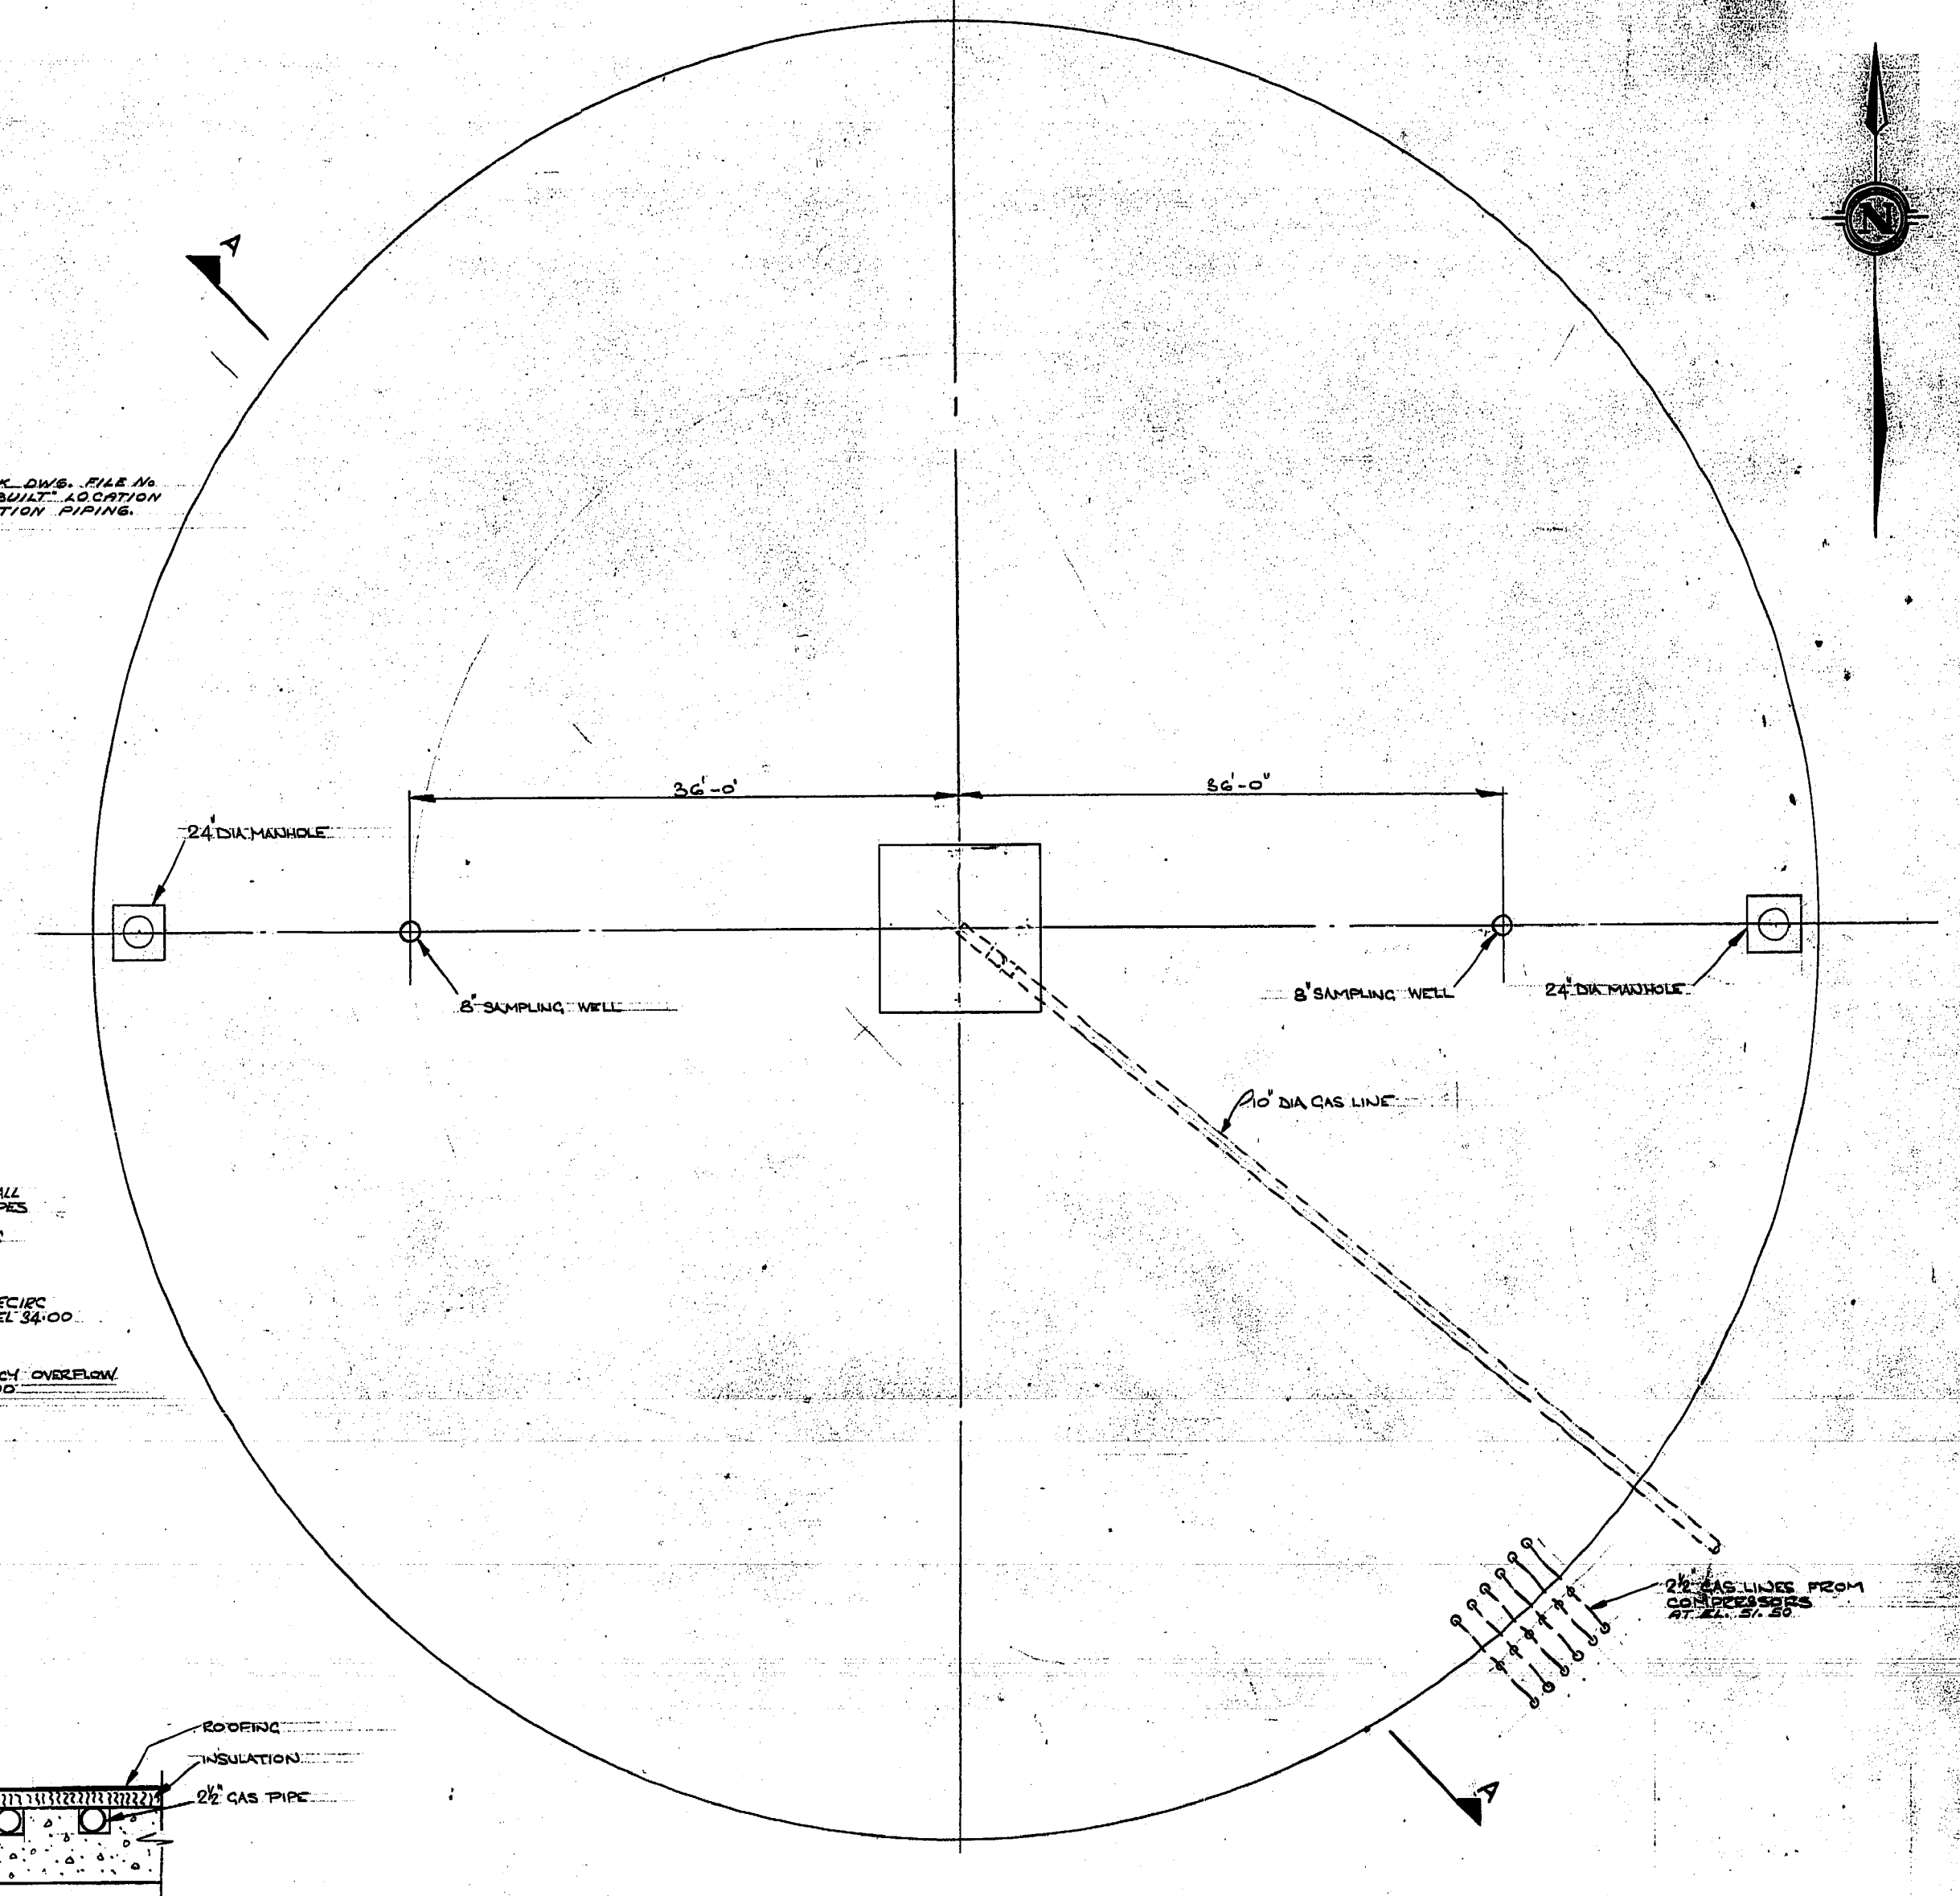

PLAN
NORTH-WEST DIRECTION TANK
OTHER TANKS SYMMETRICAL ABOUT CS OF GALLERY

REVISIONS		
No.	DATE	DETAIL

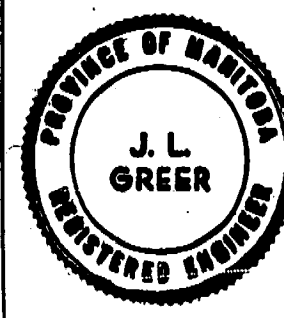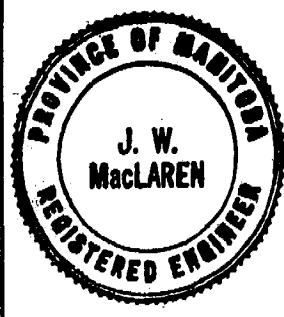

THE METROPOLITAN CORPORATION OF GREATER WINNIPEG
WATERWORKS AND WASTE DISPOSAL DIVISION

NORTH END SEWAGE TREATMENT PLANT
CONTRACT A-DIGESTION AREA
MECHANICAL - TANKS
TYPICAL PLAN & SECTIONS

APPROVED: *J. W. MacLaren*
ENGINEER OF DESIGN

J. L. Greer
ENGINEER OF WASTE DISPOSAL

W.L. WARDROP ASSOCIATES (MANAGEMENT) LIMITED
ENGINEERING CONSULTANTS / WINNIPEG

DATE: MARCH 11, 1963
SCALE: 1/8" = 1' 0"
DWG. No. 137 OF 217

NEP-137

FOR ACTUAL ELEV. SUBTRACT 0.37 FT. **AS BUILT**