


- NOTES:
1. COORDINATE LUMINAIRE LOCATIONS WITH PIPING AND MECH. DUCTING WHERE REQUIRED SUSPEND UNITS BELOW SUCH EQUIPMENT.
 2. UTILIZE PVC JACKETED TECK CABLE FOR ALL POWER WIRING. WIRING FOR LIGHTING RECEPTACLES AND COMMUNICATIONS TO BE IN RIGID ALUMINUM CONDUIT.
 3. ALL CONDUIT TO BE MINIMUM 19mm CONDUIT UNLESS OTHERWISE NOTED.

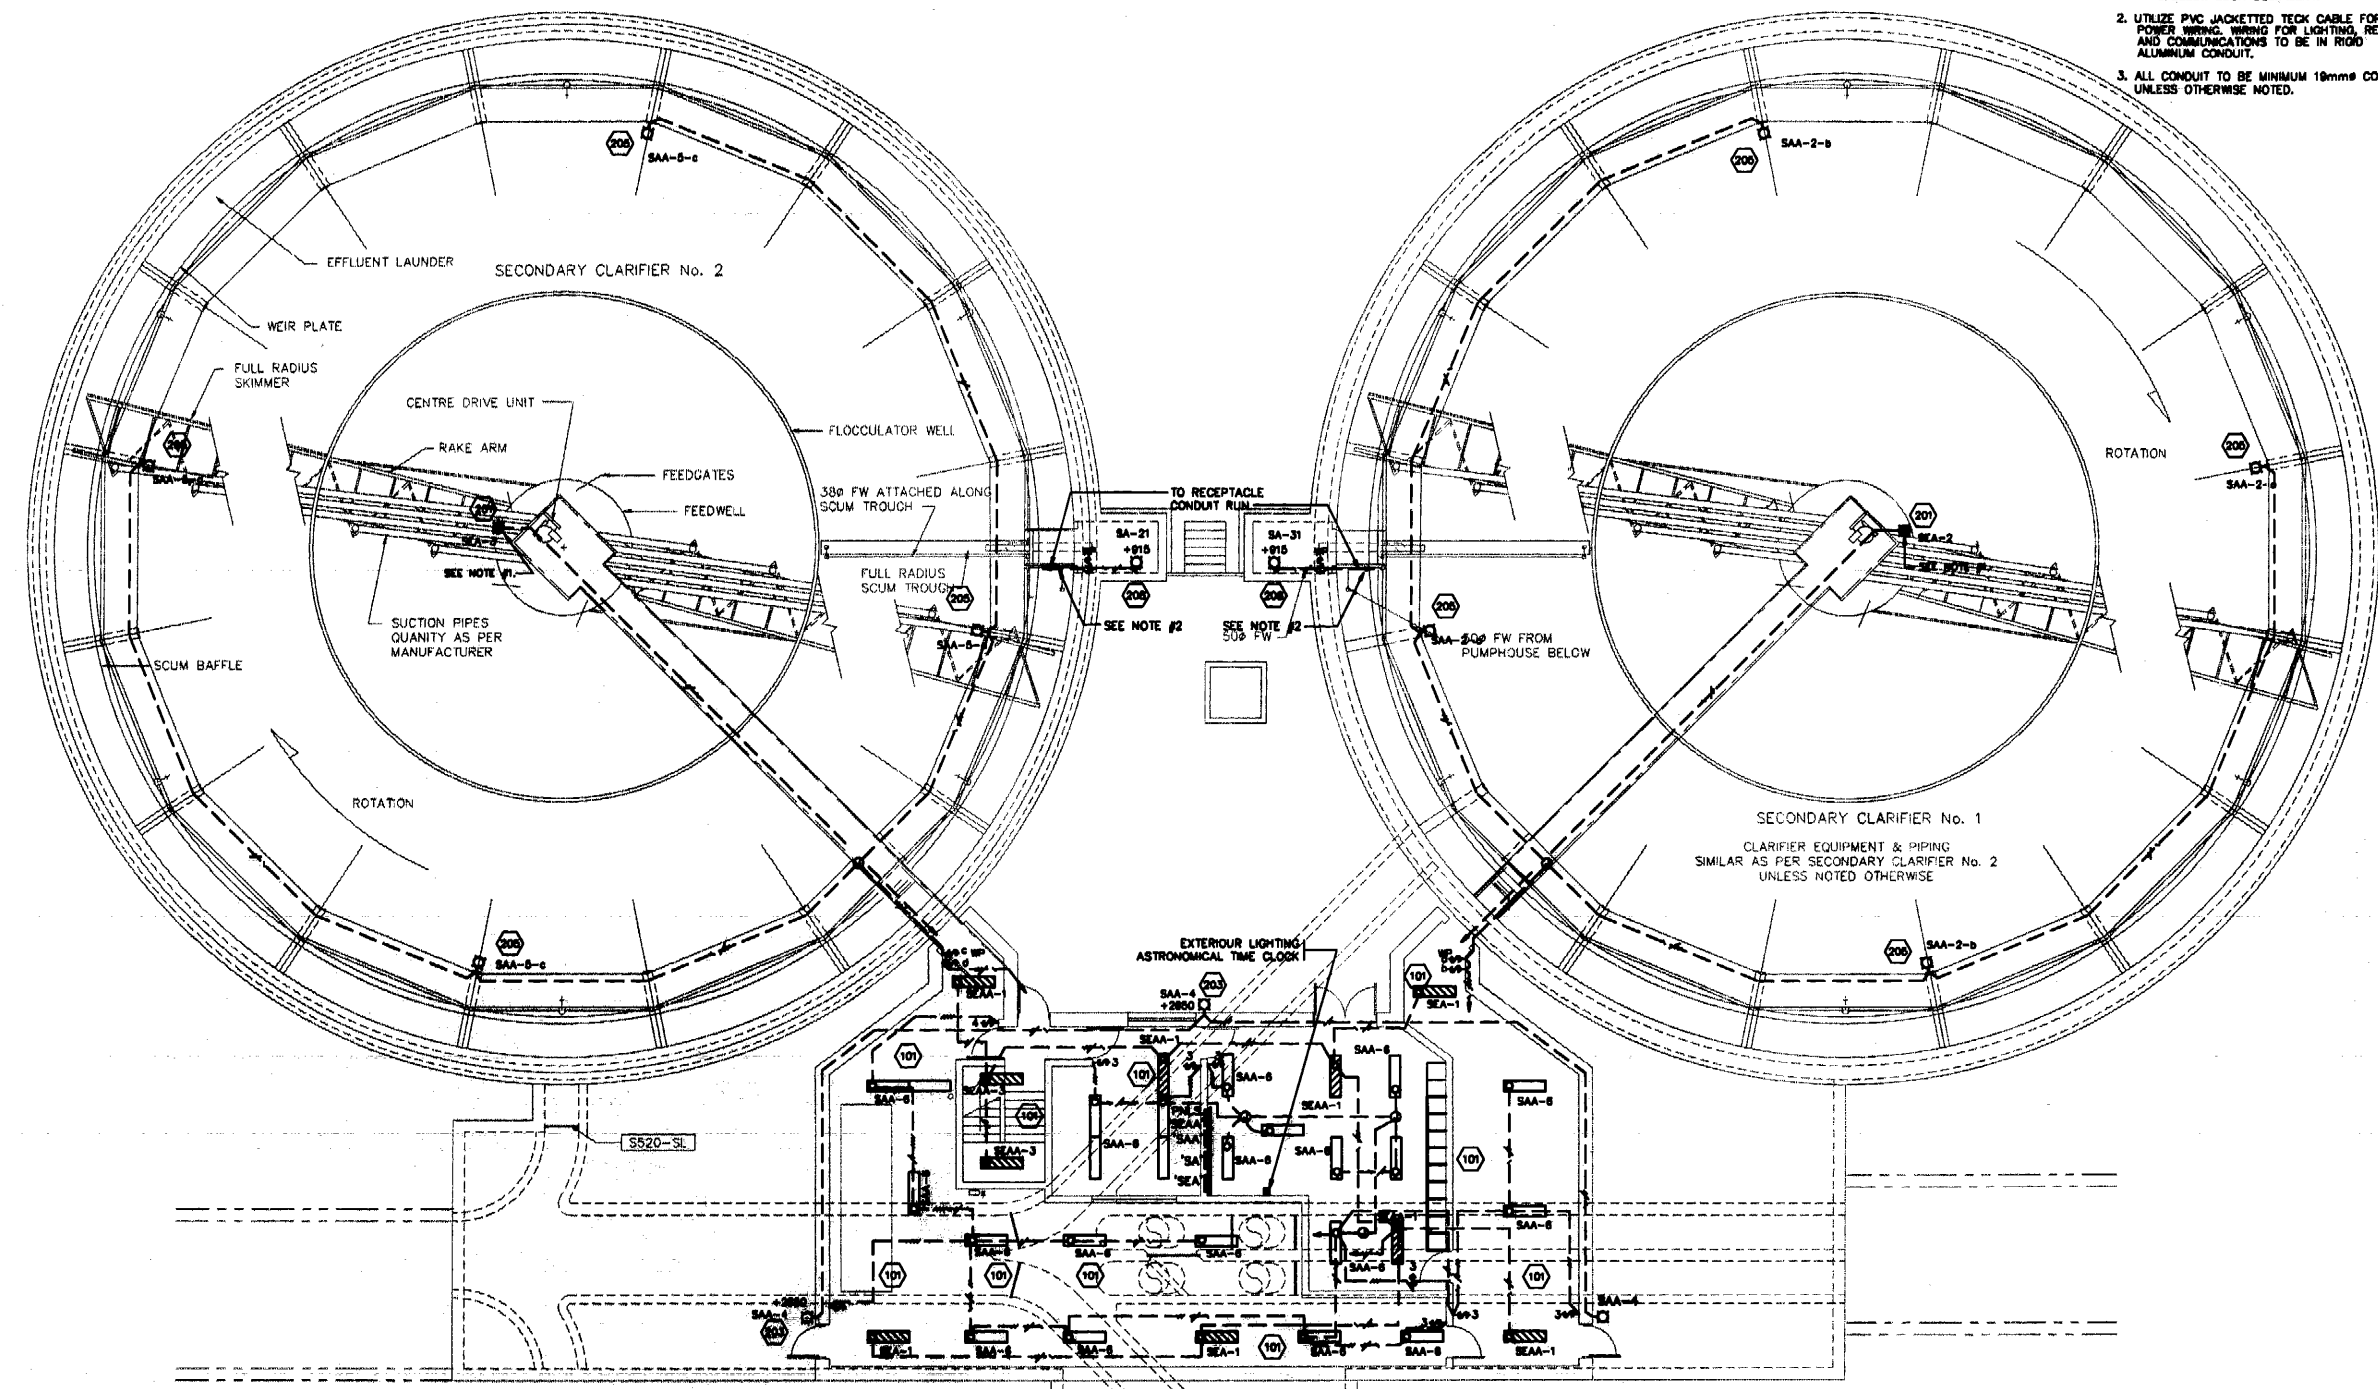

THE ENGINEER THAT SEALED THIS DRAWING IS RESPONSIBLE FOR ONLY THE AS-CONSTRUCTED CHANGES ON THIS DRAWING.
THE ORIGINAL DESIGN WAS THE RESPONSIBILITY OF THE DESIGN ENGINEER WHO SEALED THE ISSUED FOR TENDER DRAWINGS IN 1991.

REID, CROWTHER & PARTNERS LIMITED
WINNIPEG
AS CONSTRUCTED
SIGNED: *[Signature]* DATE: *[Date]*

detail symbol

A detail number
B drawing where detail shown
C cross reference to drawing where detail taken

P.L.M. ELEV. 89-006 237.639 m				ENGINEER'S SEAL 		THE CITY OF WINNIPEG WORKS AND OPERATIONS DIVISION WATERWORKS WASTE AND DISPOSAL DEPT.	
DESIGNED BY: LT DRAWN BY: EJS	CHECKED BY: DJS APPROVED BY:	HOR. SCALE: 1:100 VERTICAL:		RELEASED FOR CONSTRUCTION:		CITY DRAWING NUMBER SHEET OF	
1 AS BUILT 93/11 DE 0 ISSUED FOR TENDER		DATE BY: DATE 91-06-06 DATE		CONSULTANT DRAWING NO. 60910 - SE4		WEST END WATER POLLUTION CONTROL CENTRE AREA S - SECONDARY CLARIFIERS SECONDARY PUMPHOUSE UPPER LEVEL ELECTRICAL LIGHTING LAYOUT	
						WEP-270	

File # WS 10325