



PLAN

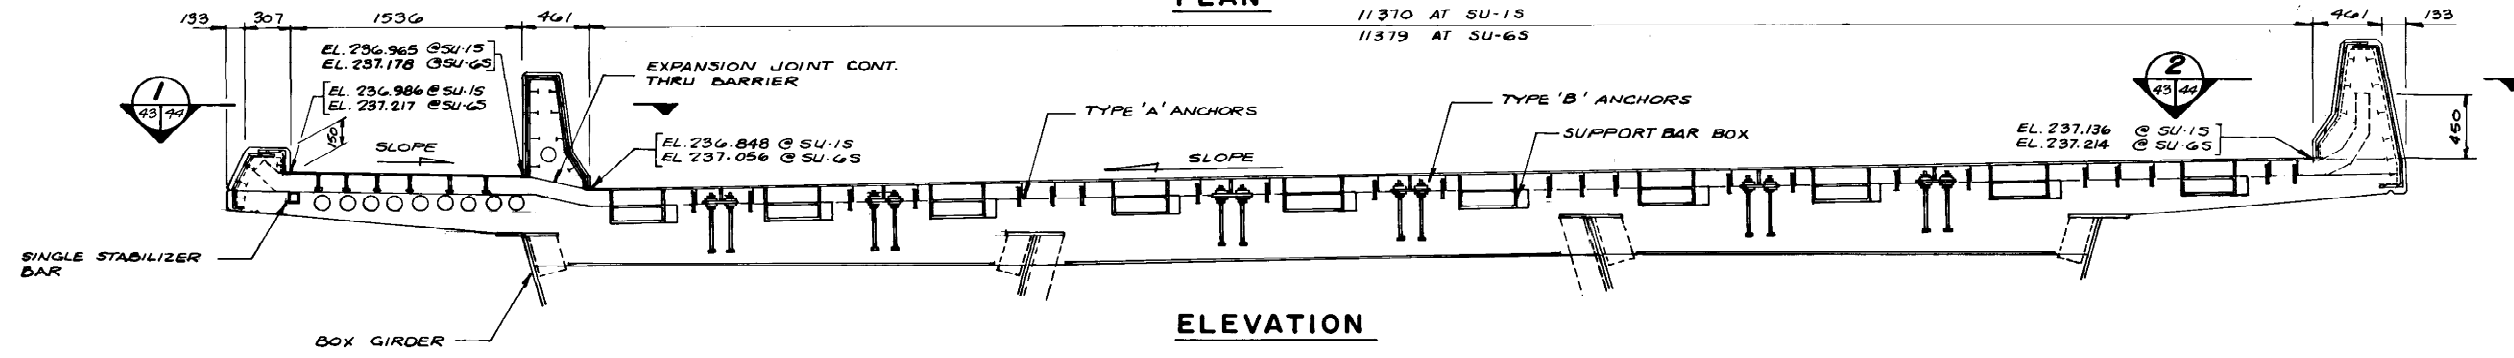


ELEVATION

SOUTH STRUCTURE SU-1S (SU-6S SIMILAR)

1:25

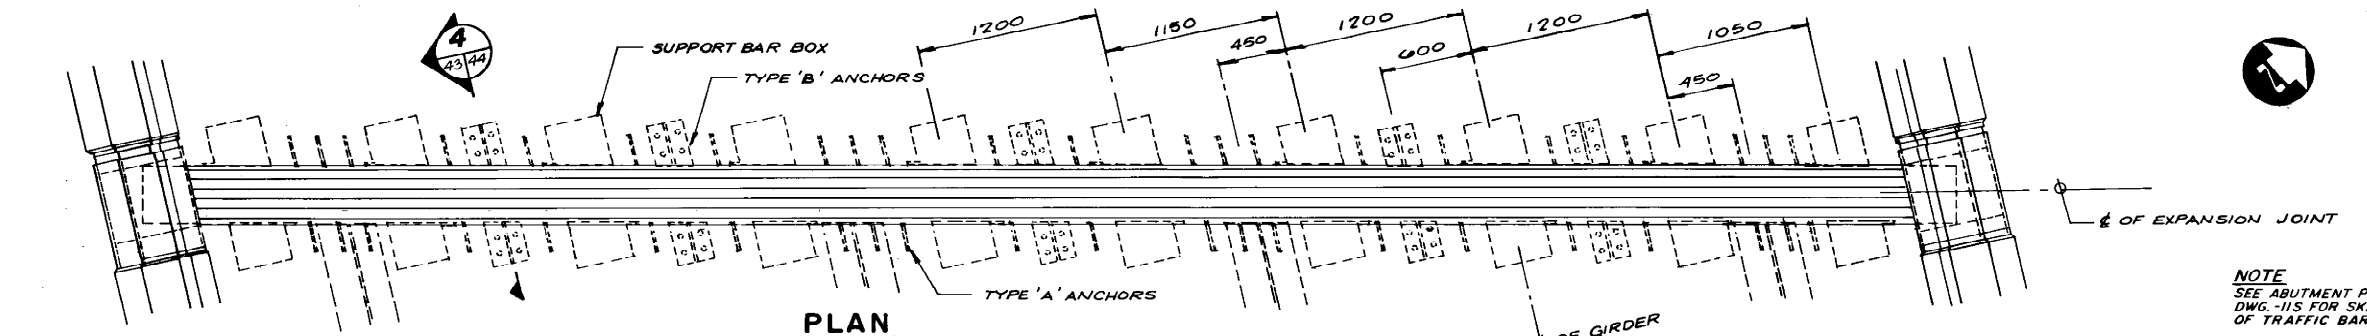

PLAN

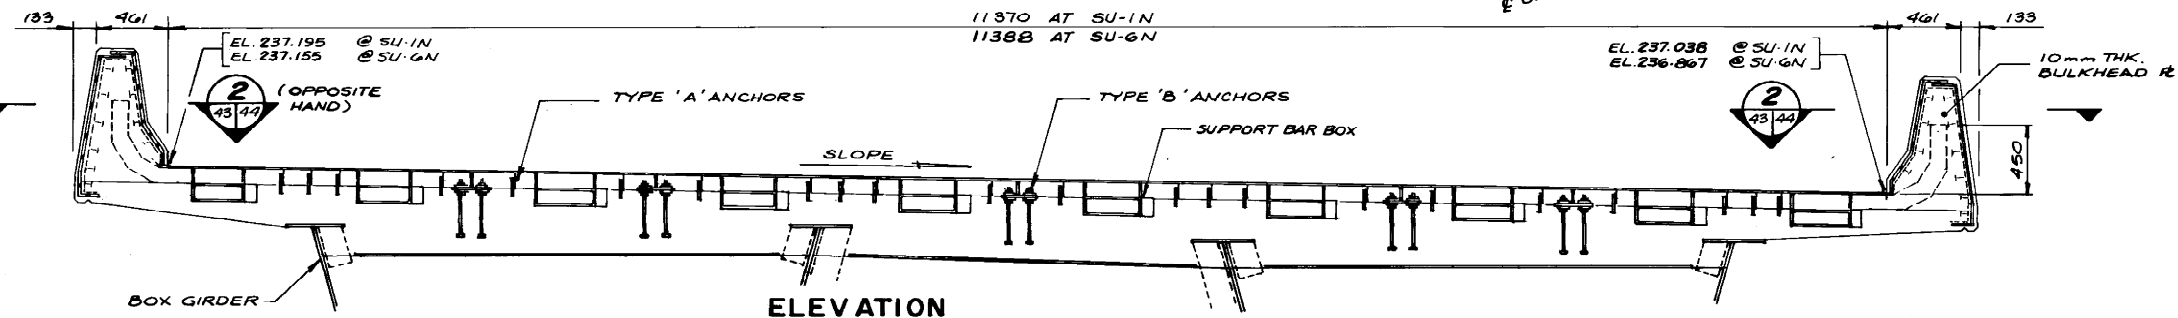

ELEVATION

NORTH STRUCTURE SU-1N (SU-6N SIMILAR)

1:25

RECORD DRAWING

APPROVED BY: *[Signature]* 90.1128
DATE

LOCATION APPROVED
UNDERGROUND STRUCTURES
NA
SUPV. U/G STRUCTURES COMMITTEE DATE
NOTE:
LOCATION OF UNDERGROUND STRUCTURES AS SHOWN ARE BASED ON THE BEST INFORMATION AVAILABLE BUT NO GUARANTEE IS GIVEN THAT ALL EXISTING UTILITIES ARE SHOWN ON THIS PLAN. THE GIVEN LOCATIONS ARE EXACT COORDINATIONS OF EXISTENCE AND EXACT LOCATION OF ALL SERVICES MUST BE OBTAINED FROM THE INDIVIDUAL UTILITIES BEFORE PROCEEDING WITH CONSTRUCTION.

| | | | | |
|------------|--|----------|--------|--|
| B.M. ELEV. | | | | |
| NO. | REVISIONS | DATE | BY | |
| 1 | BRIDGE RAISED TO INCREASE NAV. CLEARANCE | 02-24-89 | M.P.S. | |

DILLON
Consulting Engineers - Planners
Environmental Scientists

DESIGNED BY: W.P.S. CHECKED BY: S.S.R.
DRAWN BY: K.C.
HOR. SCALE: AS SHOWN
VERTICAL: AS SHOWN
DATE: MAR. 1989

ENGINEER'S SEAL
24/1/89
S.S.
RIHAL
REGISTERED ENGINEER

THE CITY OF WINNIPEG
WORKS AND OPERATIONS DIVISION
STREETS & TRANSPORTATION DEPARTMENT

KILDONAN CORRIDOR BRIDGE
STEEL GIRDER ALTERNATIVE
EXPANSION JOINTS
AT SU-1 AND SU-6
SHEET 1 OF 2

CITY DRAWING NUMBER: B216-89-43S
SHEET OF: 2
B-5828-46