


REF. or DRAWING NO. **NEP 237**
DETAILS FINAL SETTLING TANKS

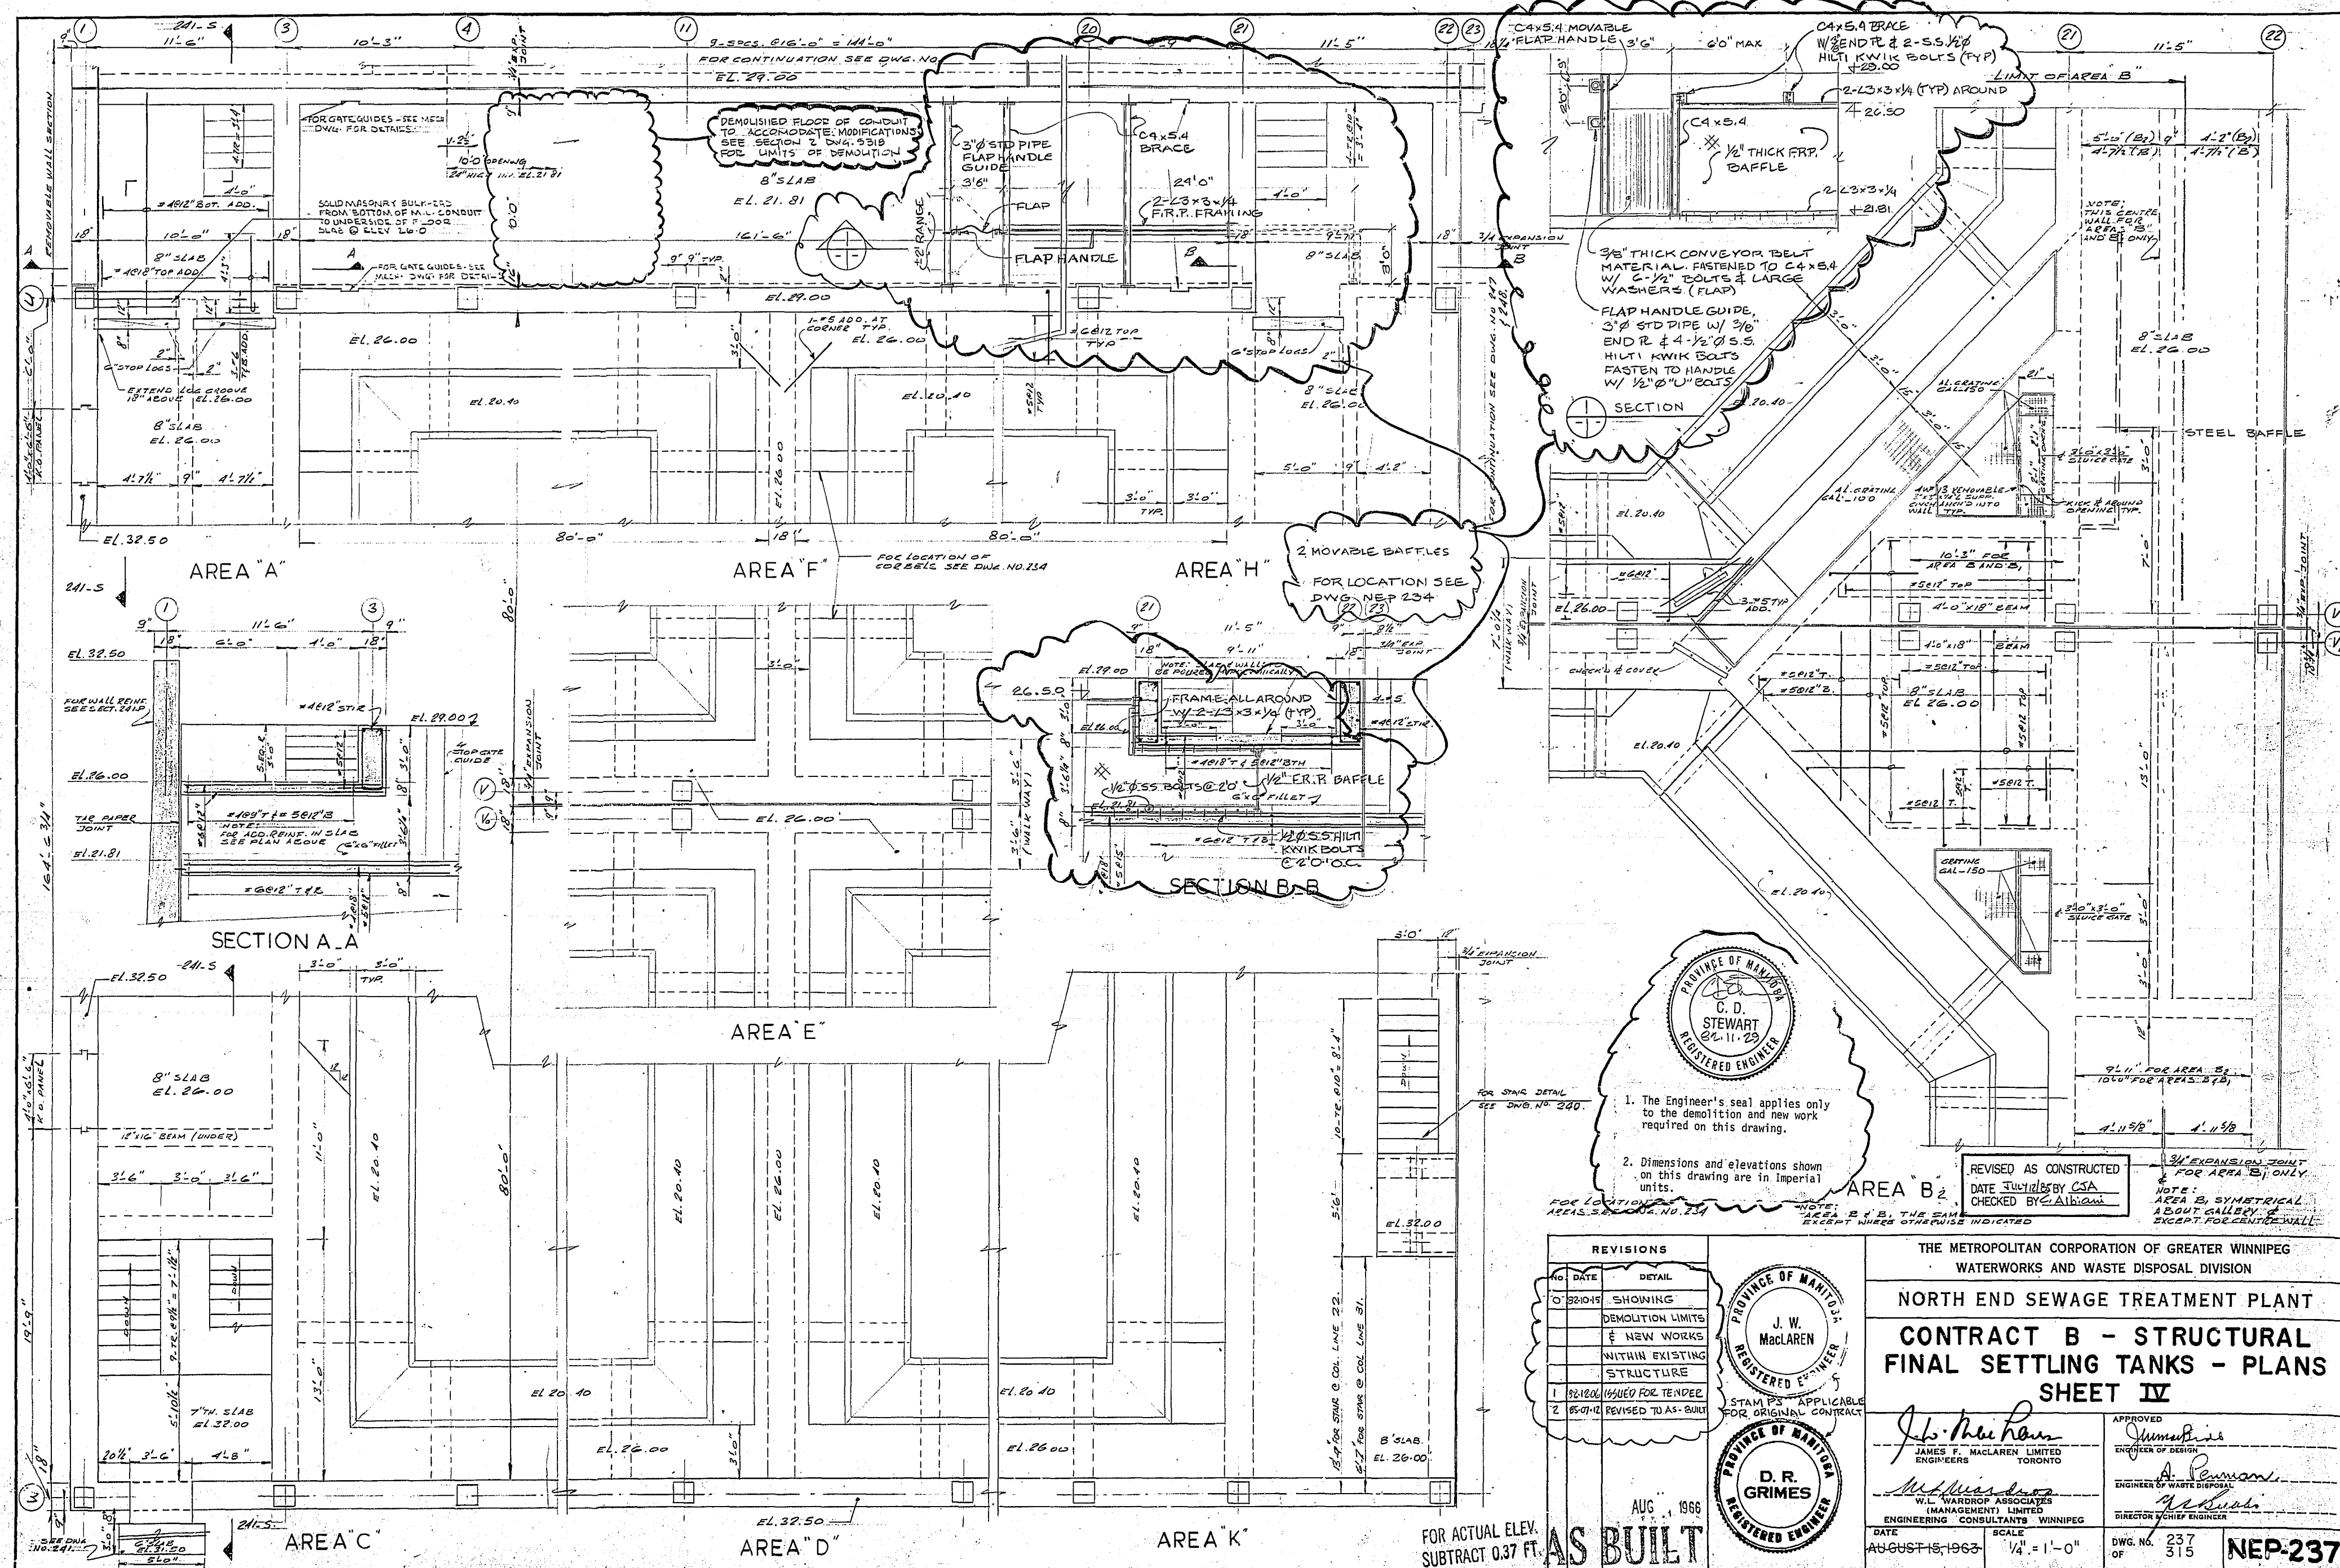

PROVINCE OF MANITOBA
C. D. STEWART
 REGISTERED ENGINEER
 22.11.29

1. The Engineer's seal applies only to the demolition and new work required on this drawing.

2. Dimensions and elevations shown on this drawing are in Imperial units.

REVISED AS CONSTRUCTED
 DATE JULY 1963 BY CSA
 CHECKED BY ALBION

NO.	DATE	DETAIL
0	02-10-59	SHOWING DEMOLITION LIMITS & NEW WORKS WITHIN EXISTING STRUCTURE
1	02-12-60	ISSUED FOR TENDER
2	05-07-62	REVISED TO AS-BUILT

PROVINCE OF MANITOBA
J. W. MacLAREN
 REGISTERED ENGINEER

PROVINCE OF MANITOBA
D. R. GRIMES
 REGISTERED ENGINEER

THE METROPOLITAN CORPORATION OF GREATER WINNIPEG
 WATERWORKS AND WASTE DISPOSAL DIVISION

NORTH END SEWAGE TREATMENT PLANT

CONTRACT B - STRUCTURAL

FINAL SETTLING TANKS - PLANS

SHEET IV

APPROVED
James F. MacLaren
 ENGINEER OF DESIGN

APPROVED
A. Penman
 ENGINEER OF WASTE DISPOSAL

DATE **AUGUST 15, 1963** SCALE **1/4" = 1'-0"** DWG. NO. **237** OF **315** **NEP-237**

AUG. 1966
AS BUILT
 FOR ACTUAL ELEV. SUBTRACT 0.37 FT.