
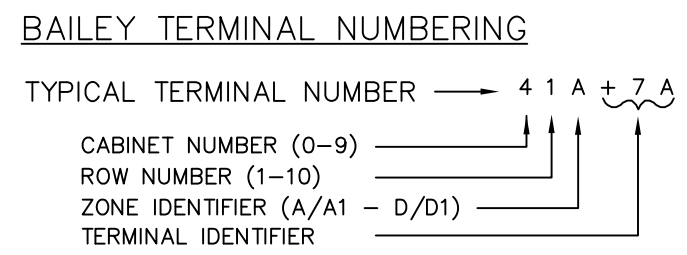


INSTRUMENT LOOP DIAGRAM

LOOP NO. - M701

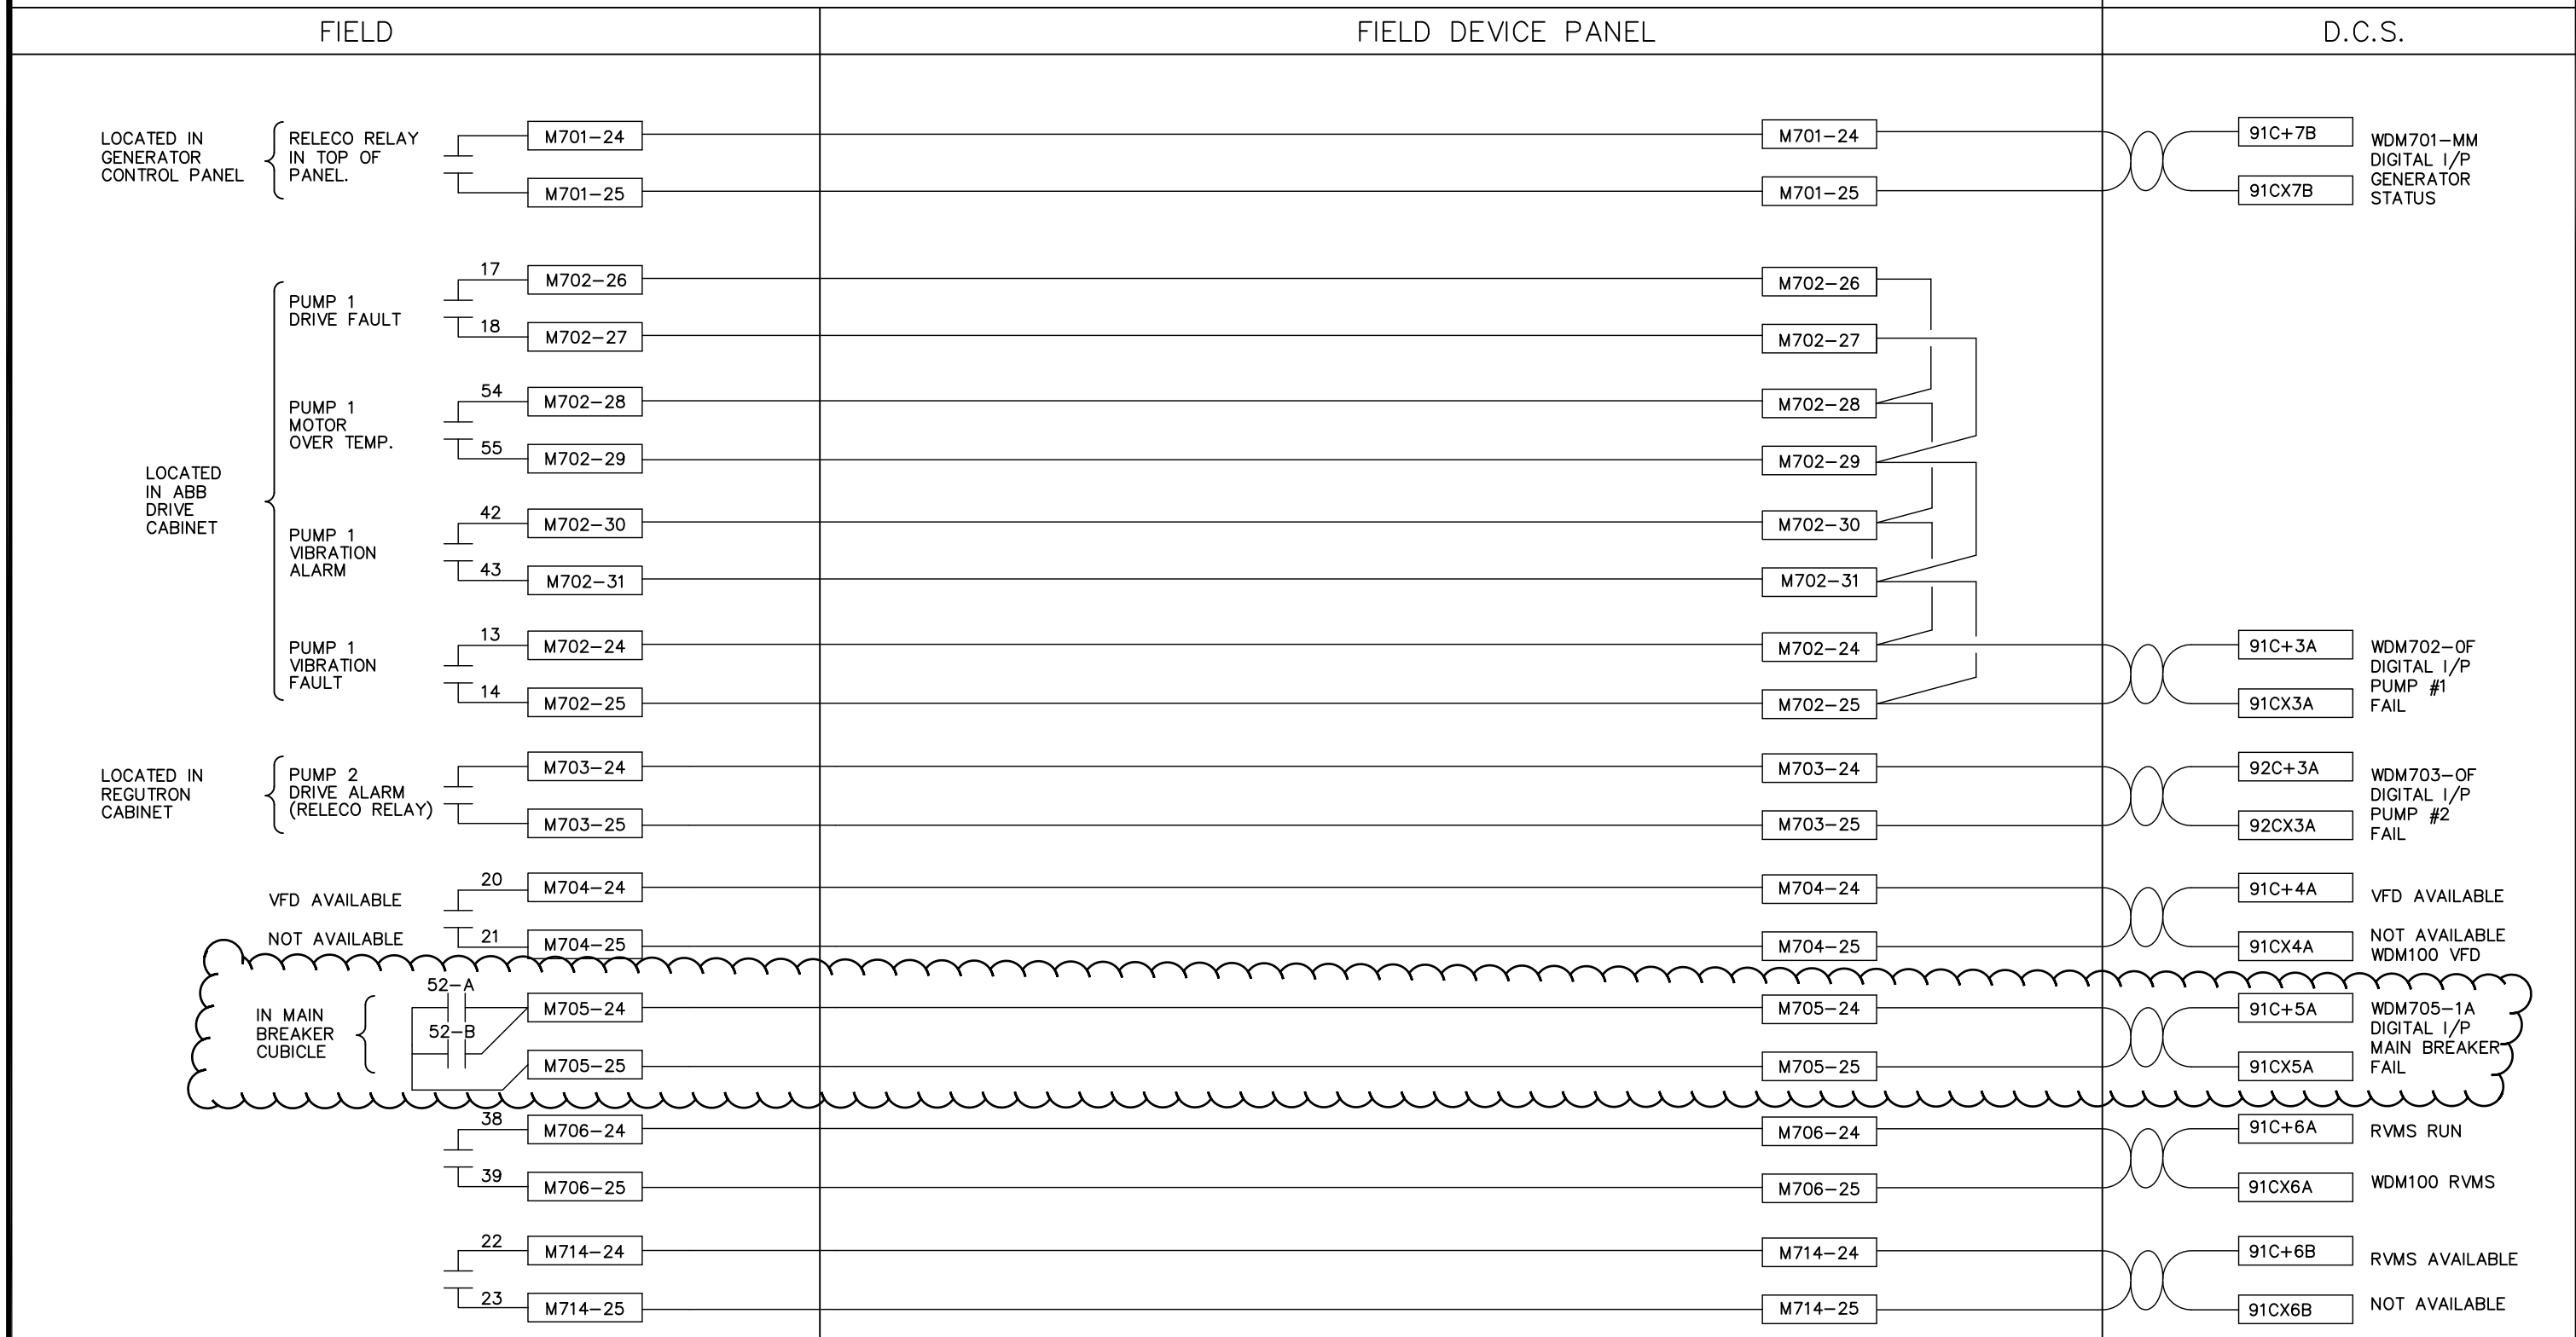

Reid Crowther

06.11.09	C.O.W. REVISION	SPH
01.04.09	C.O.W. REVISION	GMZ
JAN./94	AS BUILT	
DATE	REVISION	APP.

THE CITY OF WINNIPEG
 WORKS AND OPERATIONS DIVISION
 WATERWORKS, WASTE AND DISPOSAL DEPT.
 WEST END WATER POLLUTION CONTROL CENTRE

PERIMETER ROAD PUMPING STATION
MINOR ALARMS

SCALE N.T.S.

DATE MAY 1991

DES BL DWN DED

CKD GRG APP

DRAWING NO.

WEP-0660