




THE CITY OF WINNIPEG

WORKS AND OPERATIONS DIVISION
STREETS AND TRANSPORTATION DEPARTMENT

NAIRN AVENUE OVERPASS STRUCTURAL STRENGTHENING AND RELATED WORKS

P.D. NO. 85-74

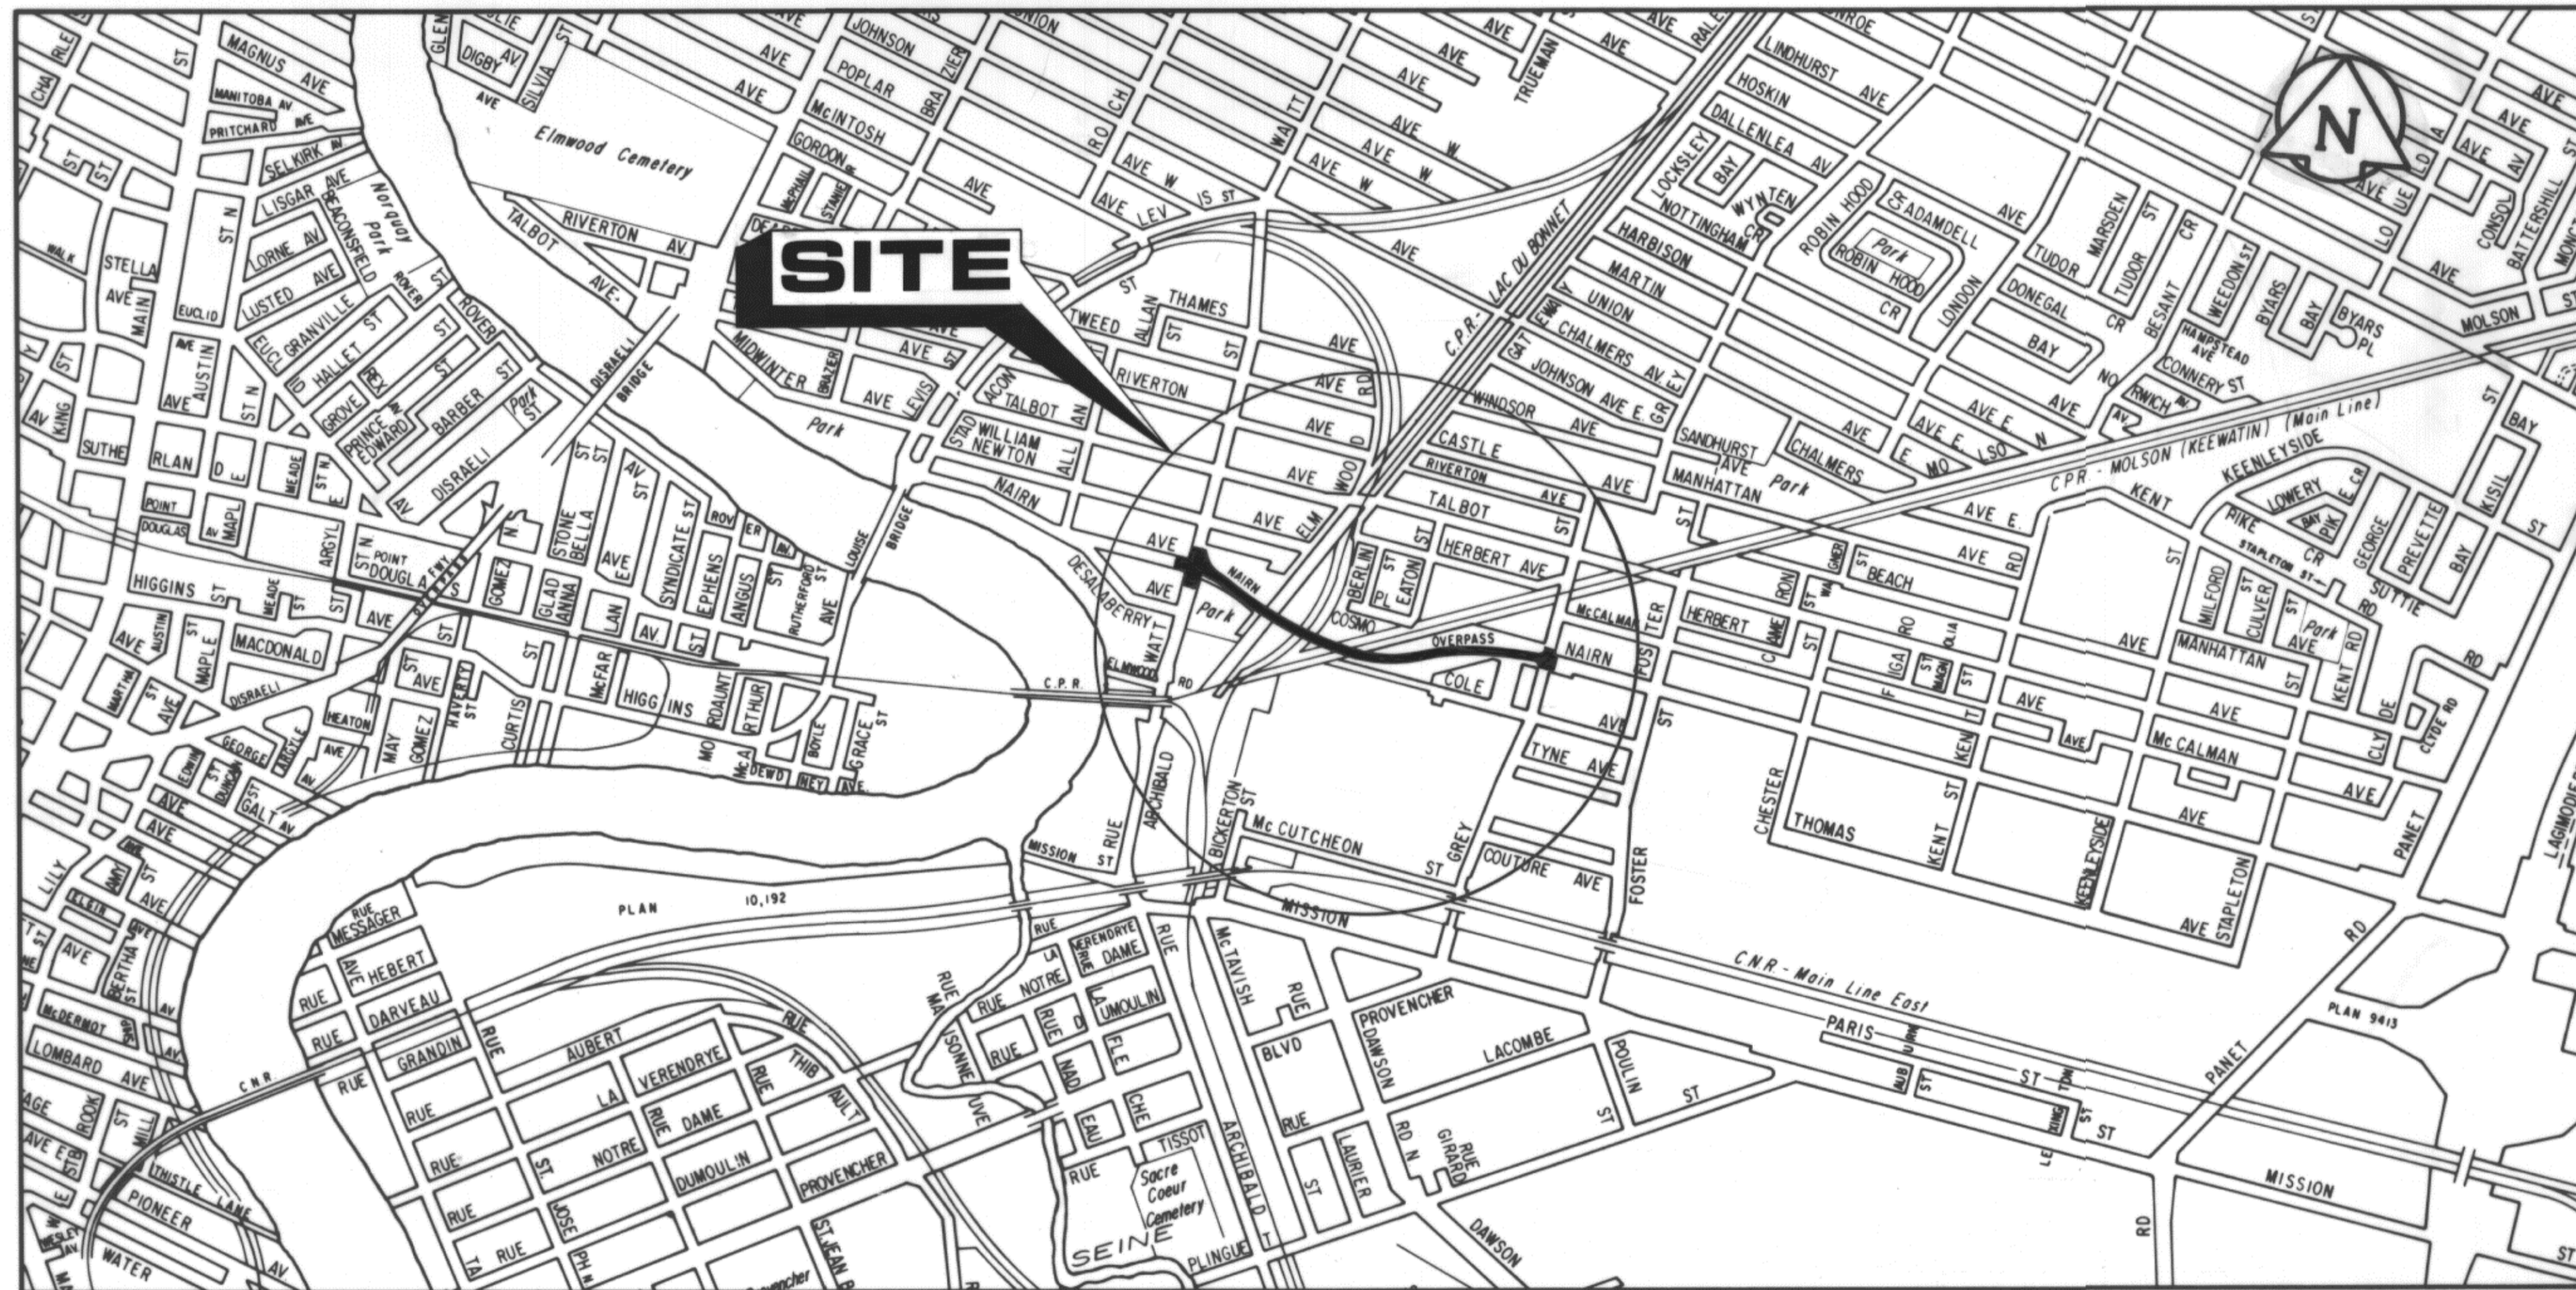

Underwood McLellan Ltd.
Consulting Engineers and Planners

RELEASED FOR CONSTRUCTION BY: *James R. Call*
MANAGER OF STREETS AND TRAFFIC DATE: 15.04.10

RECORD DRAWING

B-5566



DRAWING NO.
B/21-85-01