

PLAN
SCALE 1 : 500

NOTES:
1. FOR GEOMETRY SEE DWG. B121-85-10.
2. SCREED ELEVATIONS GIVEN BELOW INCLUDE ALLOWANCE FOR DEAD LOAD DEFLECTION.

POINT SPACING AND DEAD LOAD DEFLECTIONS

Table with columns for points 0-82 and rows for SPAC. and ORDIN. values across sections A-F.


SCREED ELEVATION

Table with columns for points 0-82 and rows for POINT B, C, D, F values.

B-5577
METRIC


WHOLE NUMBERS INDICATE MILLIMETRES
DECIMALIZED NUMBERS INDICATE METRES

RECORD DRAWING

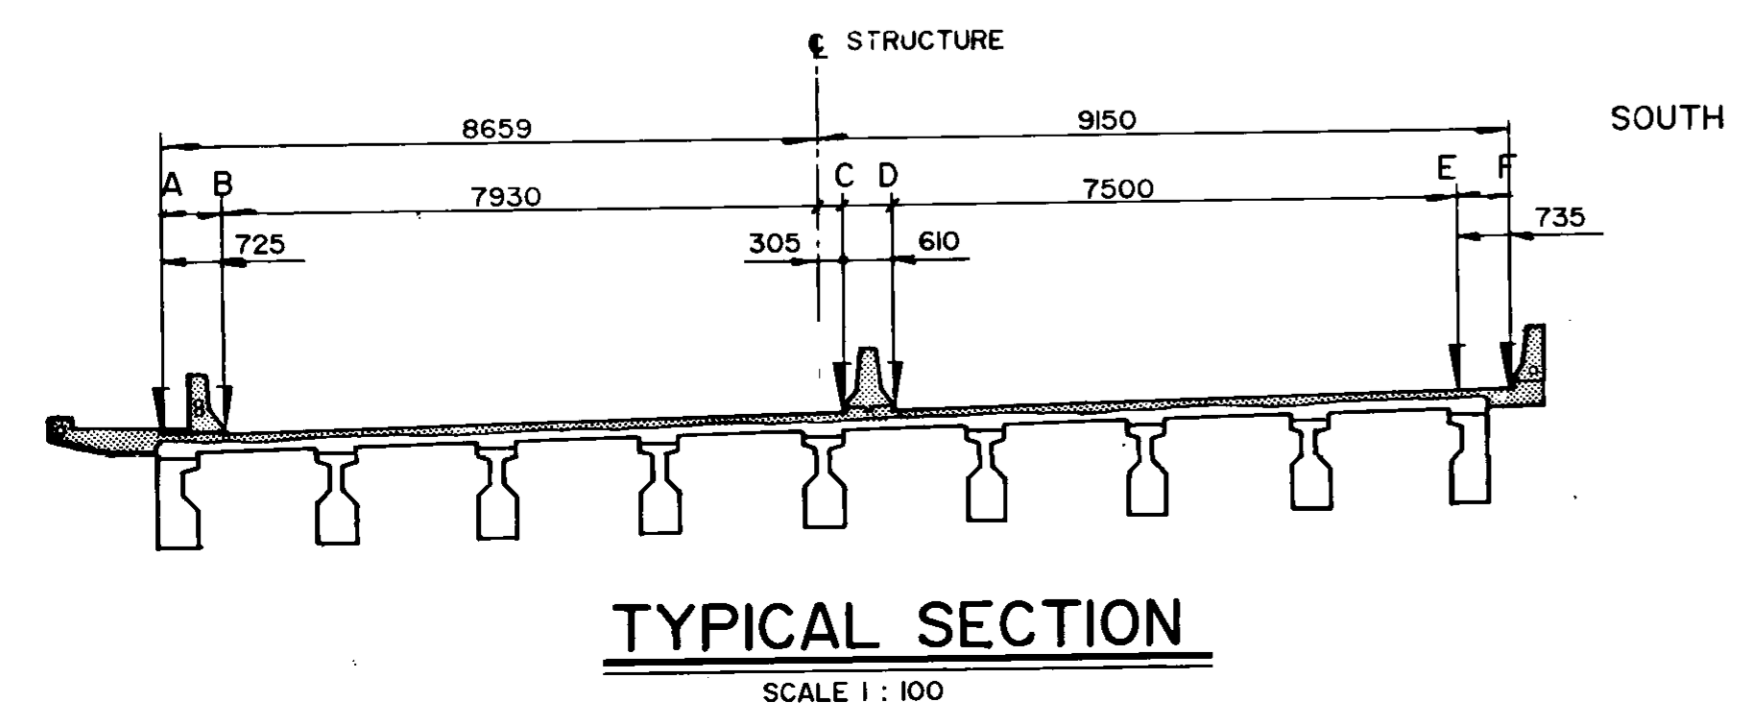

TYPICAL SECTION
SCALE 1 : 100

Table for REVISIONS with columns for NO, REVISIONS, DATE, APP.

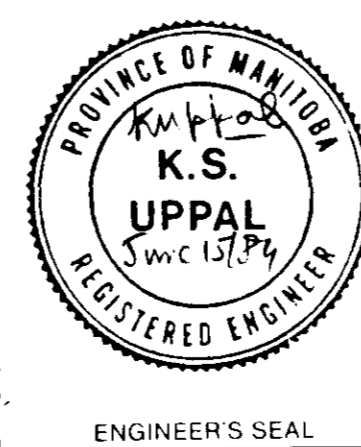

Information for Underwood McLellan Ltd. Consulting Engineers and Planners, including designer and checker details.

Logo and name of THE CITY OF WINNIPEG, Works & Operations Division, Streets & Transportation Department.

Project title: NAIRN AVENUE OVERPASS, DECK REHABILITATION, STRUCTURAL STRENGTHENING AND RELATED WORKS. Includes authorized and accepted signatures.

APPROVED BY: [Signature] DATE: June 14/84