


NOTE:
1. SECTIONS A TO F FOR SLOPED PAVING (EAST) ARE SHOWN OPPOSITE HAND.

NOTE: S10009 FIELD BEND FOR CATCH BASIN

METRIC
WHOLE NUMBERS INDICATE MILLIMETRES
DECIMALIZED NUMBERS INDICATE METRES

NO	REVISIONS	DATE	APP
2	RECORD DRAWING	NOV. 86	
1	GENERAL REVISIONS	6. 6. 86	

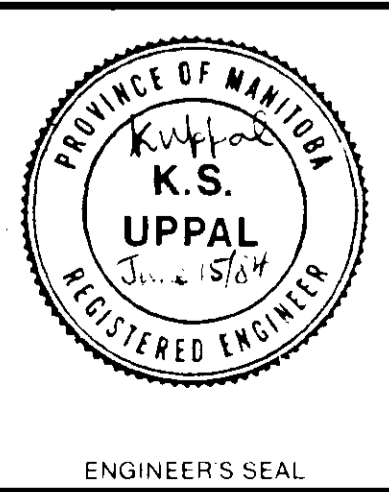

DESIGNED BY:	K.U.	DRAWN BY:	BH
CHECKED BY:	J.T.	DATE:	APRIL 1985
APPROVED BY:		JOB No.:	0265-216-01

THE CITY OF WINNIPEG
WORKS & OPERATIONS DIVISION
STREETS & TRANSPORTATION DEPARTMENT

NAIRN AVENUE OVERPASS
DECK REHABILITATION, STRUCTURAL STRENGTHENING AND RELATED WORKS
SLOPE PAVING DRAINAGE CHANNEL DETAILS
AUTHORIZED BY: *W. ...* DATE: *1985-04-16*
ACCEPTED BY: *...* DATE: *1985-04-16*
SCALE: AS NOTED
DRAWING NO: B121-85-20

RECORD DRAWING B-5586