


GENERAL NOTES:
 A. BASELINE MEASURED DOWN CENTERLINE OF WATER
 B. EARTH TECH FIELD BOOK No. 4401
 C. LOCATION OF UNDERGROUND STRUCTURES AS SHOWN ARE BASED ON THE BEST INFORMATION AVAILABLE, BUT NO GUARANTEE IS GIVEN THAT ALL EXISTING UTILITIES ARE SHOWN OR THAT THE GIVEN LOCATIONS ARE EXACT. CONFIRMATION OF EXISTENCE AND EXACT LOCATION OF ALL SERVICES MUST BE OBTAINED FROM THE INDIVIDUAL UTILITIES BEFORE PROCEEDING WITH CONSTRUCTION.

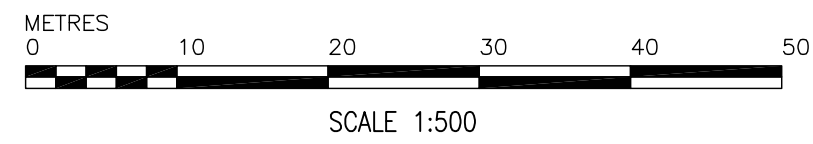

AECOM
As of January 3, 2009, EarthTech became AECOM Canada Ltd.

AECOM AS-CONSTRUCTED
SIG..... DATE.....

150 mm W.M.	WATERMAIN	150 mm W.M.	HYDRO	HYDRO	LIGHT STANDARD
◇	HYDRANT	+	M.T.S./F.O.C.	•	BOLLARD
⊙	VALVE	○	CONCRETE	—	FIRE EXTINGUISHER
300mm L.D.S.	LAND DRAINAGE SEWER	300mm L.D.S.	ASPHALT	—	CURB STOP
250mm W.W.S.	WASTEWATER SEWER	250mm W.W.S.	PROPERTY LINE	—	TREATED CENTRATE
○	MANHOLE	●	TEST HOLES	—	⊕ RAILWAY TRACK
□	CATCH BASIN	■	ELEVATION (32.750)	—	DITCH
▽	CURB INLET	▲	TREE	—	RAS
+	JUNCTIONS	+	ANODE	—	WAS
—	CULVERT	—	CONCRETE SIDEWALK	—	FW
—	GAS	—	FENCE	—	CENTRATE
EXISTING	LEGEND - PLAN	PROPOSED	EXISTING	LEGEND - PLAN	PROPOSED

AECOM
Certificate of Authorization
AECOM Canada Ltd.
Original dated on: 2006/05/15
No. 4671 Date: 2006/05/15

B.M. 13-027 W. side Main St. on the grounds of the North End Treatment Plant, 10ft. on top of conc. pit in front of main bldg., 22.3m E. of line of most Ely. wall & 32.8m S. of most Nly. wall of main bldg. (ties to 10ft.) ELEV. = 231.261m	DESIGNED BY	GSK	CHECKED BY	KWF
	DRAWN BY	FC	APPROVED BY	JEH
	SCALE:	HOR: 1:500 VERT: 1:50	RELEASED FOR CONSTRUCTION BY:	K. MARTENS
02 AS-CONSTRUCTED DRAWING 09/04/06 DEP	DATE	2006/01/16	DATE	2006/05/15
01 ISSUED FOR CONSTRUCTION 06/08/30 GLG				
00 ISSUED FOR TENDER 06/05/15 FC				
NO. REVISIONS	DATE	BY	DATE	

EarthTech
A Tyco International Ltd. Company

ENGINEER'S SEAL
ORIGINAL SIGNED BY
K.W. FITCHETT
2006/05/15
CONSULTANT DRAWING NO.
C3.02

THE CITY OF WINNIPEG
WATER AND WASTE DEPARTMENT
ENGINEERING DIVISION
NEWPC CENTRATE NUTRIENT TREATMENT NITROGEN REMOVAL FACILITY
CITY FILE NUMBER
SHEET OF
CITY DRAWING NUMBER
1-0101C-C0005-002-02
CIVIL WATERMAINS - PLAN AND PROFILE SHEET 2