



LEGEND

- ⊙ RAIN BIRD MODEL NO 27
- ⊕ RAIN BIRD MODEL NO 31
- ⊗ RAIN BIRD MODEL NO 41
- ⊖ RAIN BIRD MODEL NO 171 S
- △ BEDDING POINTS
- 6" ASBESTOS CEMENT WATERMAIN
- - - PLASTIC PIPE
- INV. 25.10 ELEVATION OF PIPE INVERT

NOTE:
THE CONTRACTOR SHALL PLACE ALL CONNECTIONS.

NOTE: SEE SHOP DWG. 89-X-5 FOR "AS-BUILT" LAYOUT

REVISIONS		
No.	DATE	DETAIL

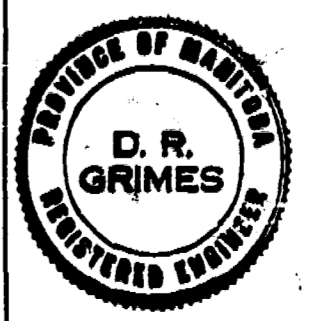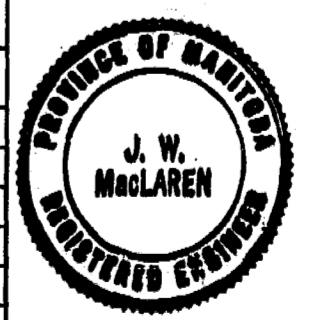

THE METROPOLITAN CORPORATION OF GREATER WINNIPEG
WATERWORKS AND WASTE DISPOSAL DIVISION

**NORTH END SEWAGE TREATMENT PLANT -
CONTRACT A- MISCELLANEOUS
LAWN SPRINKLER LAYOUT
WEST OF MAIN BUILDING**

APPROVED: *J. W. MacLaren*
JAMES F. MACLAREN LIMITED
ENGINEERS TORONTO

APPROVED: *A. Penman*
W.L. WARDROP ASSOCIATES
(MANAGEMENT) LIMITED
ENGINEERING CONSULTANTS WINNIPEG

DATE: MARCH 11, 1963
SCALE: 1" = 50'-0"

DWG. No. 215 OF 217
NEP-215

AUG. 1966
FOR ACTUAL ELEV. SUBTRACT 0.37 FT. **AS BUILT**

DETAILS

