


NEP-0862

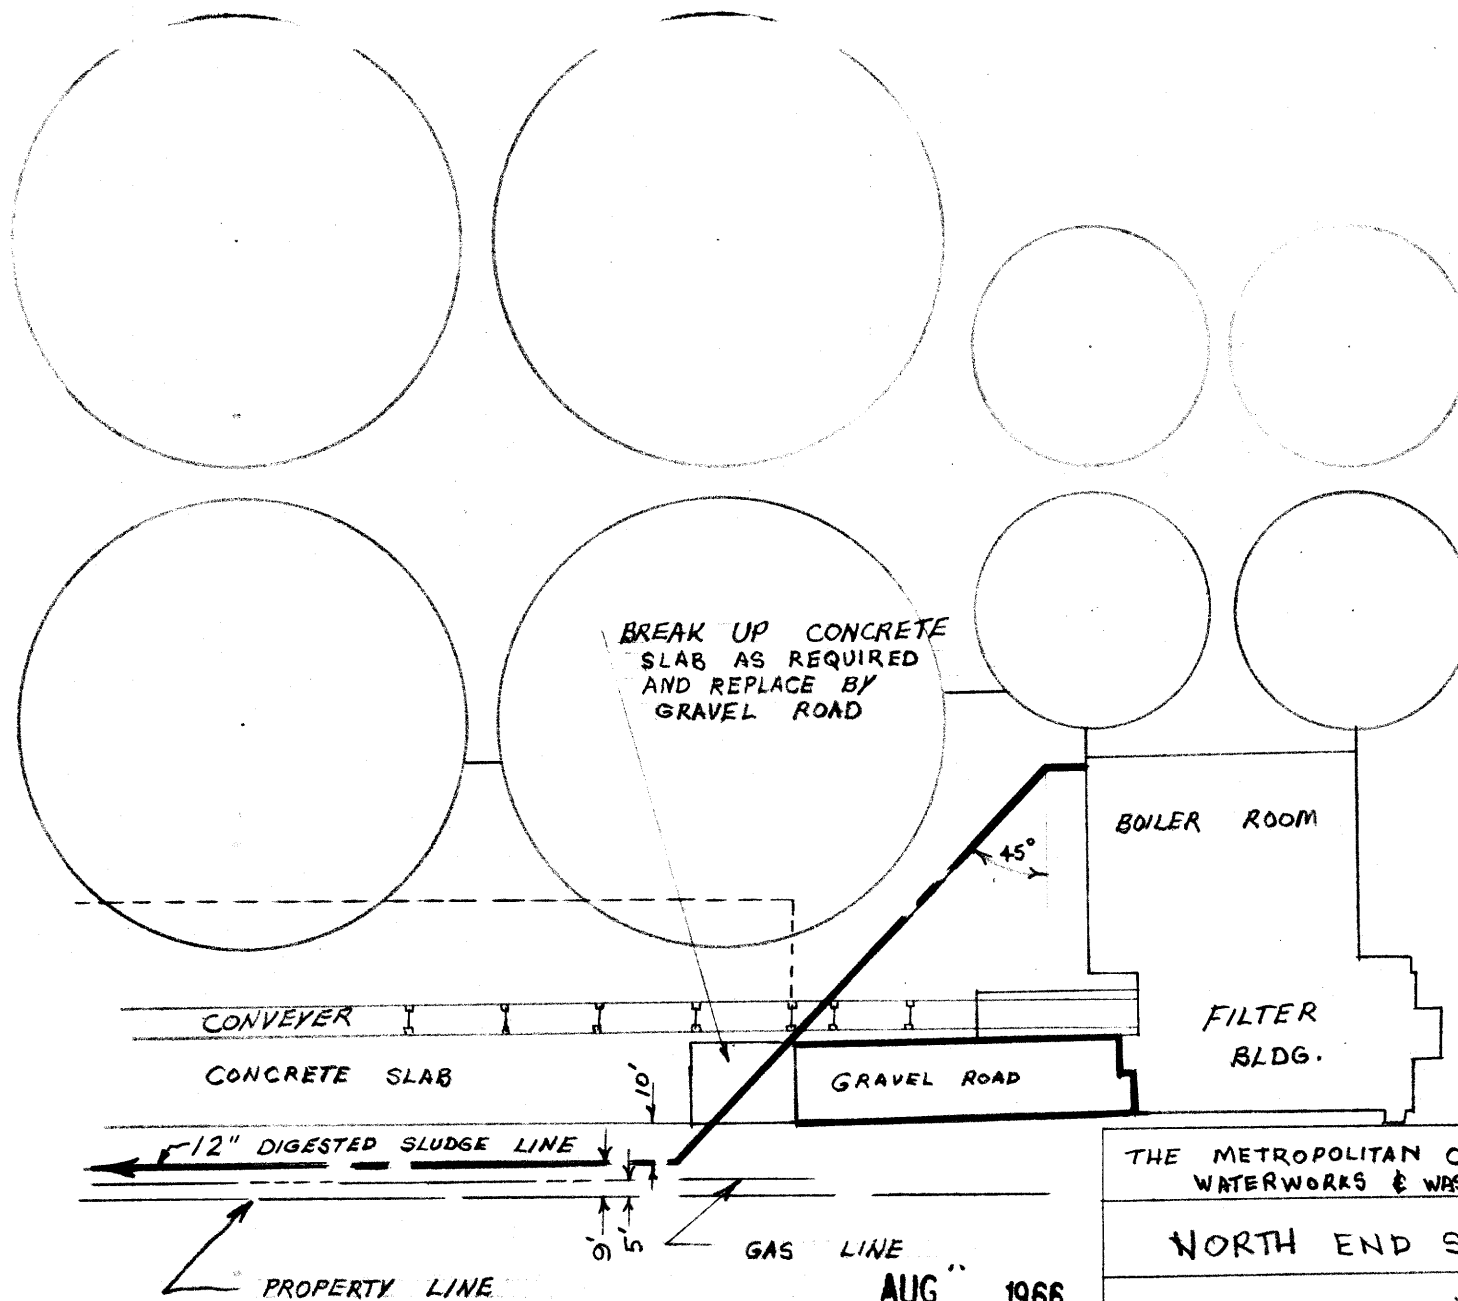

NR11038

MICROFILMED
NEP-862

AUG 1966
AS BUILT

READ THIS DRAWING IN CONJUNCTION WITH
CONTRACT DRAWINGS 206 & 208

THE METROPOLITAN CORPORATION OF GREATER WINNIPEG WATERWORKS & WASTE DISPOSAL DIVISION		
NORTH END SEWAGE TREATMENT PLANT		
CONTRACT 'A' YARD PIPING REVISED LOCATION OF DIGESTED SLUDGE LINE		
JAMES F. MACLAREN LTD.		W.L. WARDROP & ASSOC. LTD.
<i>P. Croop Koopman</i>		
SCALE 1" = 50'	DATE, OCT. 2, /63	DETAIL DWG. NO. 10