




Desk Unit 204 Plan

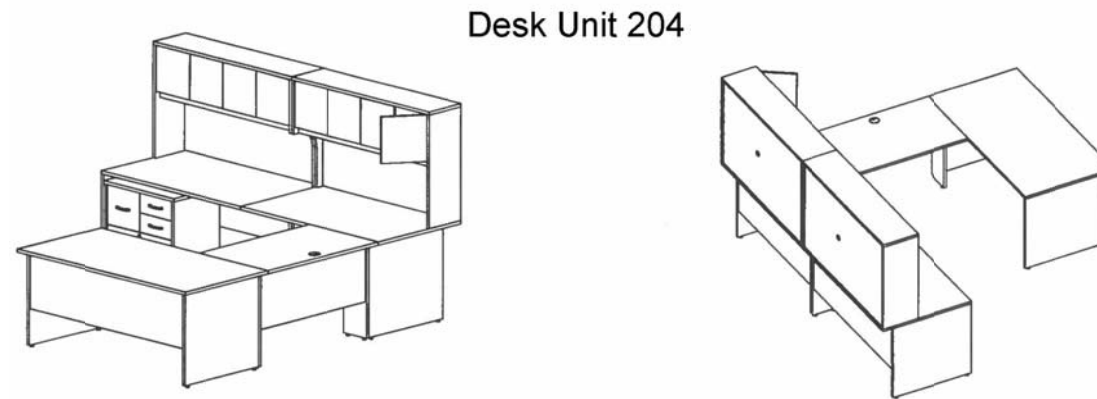

Desk Unit 204

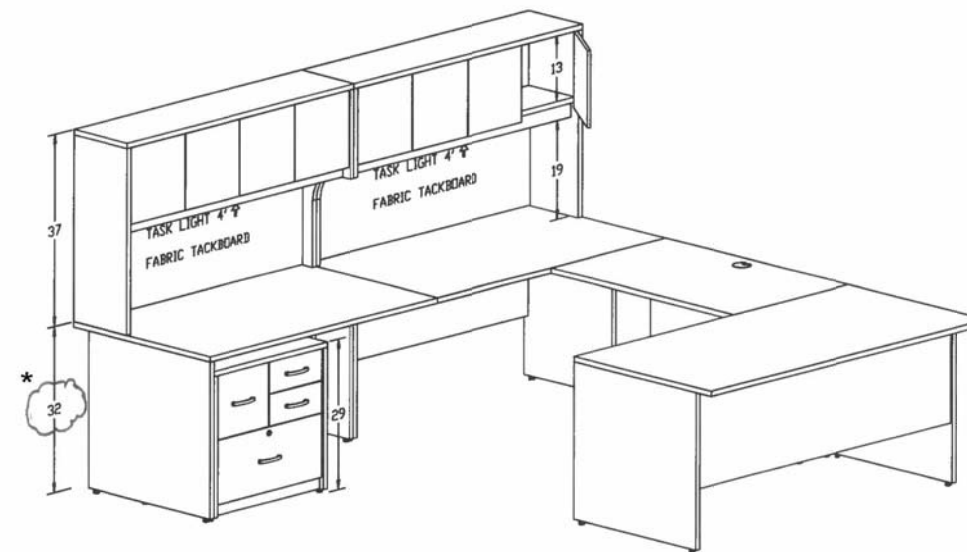

* - Note Desk Height at 32"

 THE CITY OF WINNIPEG PLANNING, PROPERTY AND DEVELOPMENT DEPARTMENT MUNICIPAL ACCOMMODATIONS DIVISION 3-65 GARRY STREET, R3C 4K4			PROJECT FORT GARRY PLACE PLAN EXAMINATION OFFICE UNIT 83-30 FORT STREET		SHEET TITLE WORK STATION LAYOUTS FOR PLAN EXAMINERS	
DRAWN BY:	DESIGNED BY:	CHECKED BY: JAD	APPROVED BY:	DATE: 2014.04.24	SCALE: N.T.S.	SHEET No: A4
				eFILE: 2013-087_11X17-Cubicles.dwg	PROJECT No: 2013-087	