


SECTION 1:20

DETAIL 1:50


METRIC NOTES

WHOLE NUMBERS IND. MILLIMETRES
DECIMALIZED EXPRESSIONS IND. METRES

NO	REVISIONS	DATE	APP
1	RECORD DRAWING	None	EEL

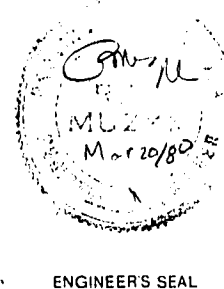

Underwood McLellan Ltd. Consulting Engineers and Planners	
DESIGNED BY: R.M.M.	DRAWN BY: A.T.
CHECKED BY:	DATE: MARCH 20, 1980
APPROVED BY:	DATE: 20/3/80

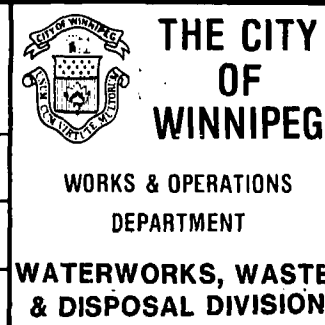

RECORD DRAWING
MICROFILMED

WILKES AVENUE RESERVOIR RECONSTRUCTION	
FOUNDATION DRAINAGE	
RELEASED FOR CONSTRUCTION	DATE: 20/03/80
SCALE: AS NOTED	DRAWING NO: WIL-6

File # RE 10313