


WILKES 1992 BLDG. ENVELOPE

WIL-68

WILKE 1992 BLDG. ENVELOPE

FILE # RE10527

File # RE

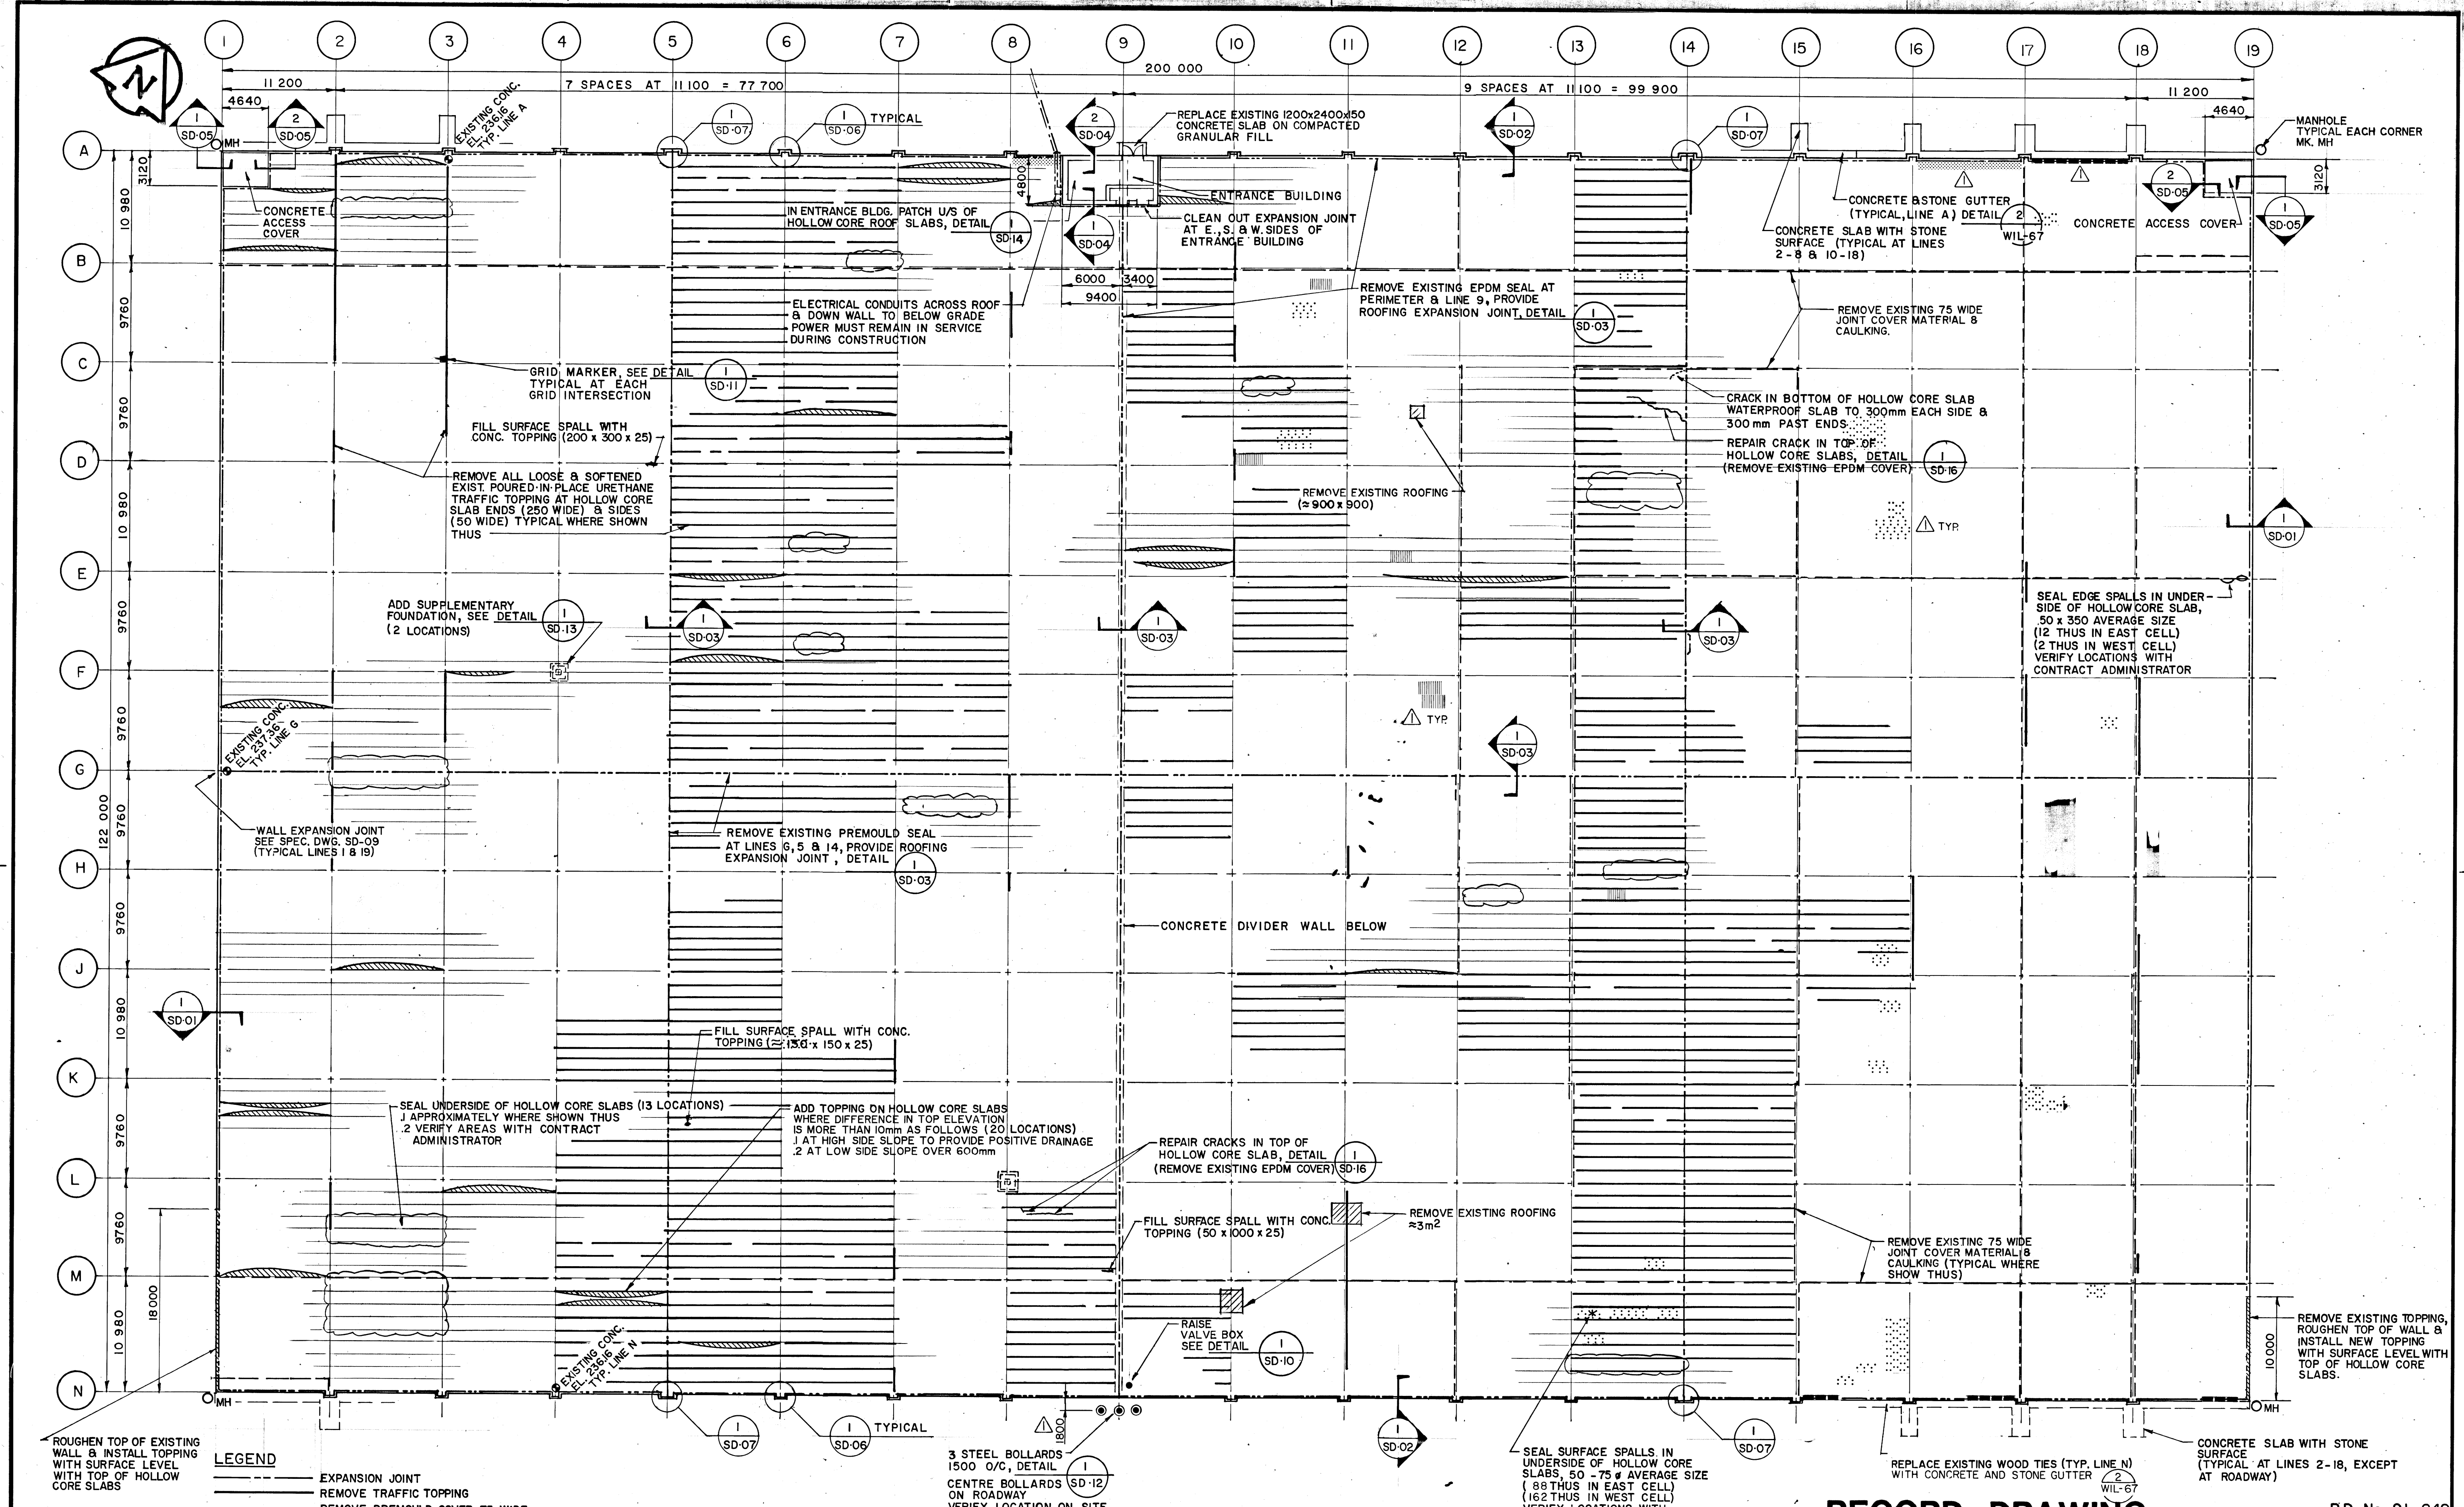

LEGEND

- EXPANSION JOINT
- REMOVE TRAFFIC TOPPING
- REMOVE PREMOULD COVER 75 WIDE
- SEAL UNDERSIDE OF HOLLOW CORE SLABS
- ADD TOPPING ON HOLLOW CORE SLABS OR PERIMETER WALLS
- REPAIR CRACKS IN TOP OF HOLLOW CORE SLABS
- REMOVE EXISTING ROOFING
- ADD SUPPLEMENTARY FOUNDATION
- SEAL SURFACE SPALLS (UNDERSIDE OF H.C. SLABS)
- SEAL EDGE SPALLS (UNDERSIDE OF H.C. SLABS)
- REMOVE AND REPLACE LOOSE GROUT & CONCRETE
- REPAIR CRACKED PANEL
- ROOF SPALL REPAIR AREAS
 - PER SD-17
 - PER SD-18

LOCATION APPROVED UNDERGROUND STRUCTURES

SUPV. U/G STRUCTURES	DATE

NOTE: LOCATION OF UNDERGROUND STRUCTURES AS SHOWN ARE BASED ON THE BEST INFORMATION AVAILABLE BUT NO GUARANTEE IS GIVEN THAT ALL EXISTING UTILITIES ARE SHOWN OR THAT THE GIVEN LOCATIONS ARE EXACT. CONFIRMATION OF EXISTENCE AND EXACT LOCATION OF ALL SERVICES MUST BE OBTAINED FROM THE INDIVIDUAL UTILITIES BEFORE PROCEEDING WITH CONSTRUCTION.

B.M. ELEV.	DATE	BY

UMA Engineering Ltd.
Engineers & Planners
1479 Buffalo Place, Winnipeg, Manitoba, Canada R3T 1L7

DESIGNED BY: J.R.C. CHECKED BY: S.B.B.
 DRAWN BY: J.R.C. APPROVED BY: *[Signature]*
 HOR. SCALE: 1:300
 VERTICAL: RELEASED FOR CONSTRUCTION: *[Signature]*
 DATE: 1991-10-25 DATE: 1991-10-25

ENGINEER'S SEAL

 CONSULTANT DRAWING NO. 41 13 0265 259 02

THE CITY OF WINNIPEG
WORKS AND OPERATIONS DIVISION
WATERWORKS, WASTE & DISPOSAL DEPARTMENT

WILKES RESERVOIR
PHASE II CONSTRUCTION
BUILDING ENVELOPE

CITY DRAWING NUMBER: SHEET 2 OF 2
 WIL-68

RECORD DRAWING P.D. No. 91-249

FILE # RE 10527