

THE CITY OF WINNIPEG
WATERWORKS, WASTE AND DISPOSAL DEPARTMENT

FILE No. _____

SUBJECT INSTALLATION OF 750 ϕ MODEL 10C DATE JAN 16 1985


ARMCO FLAP GATE IN OLIVE PUMPING STATION SHEETS No. S-424

COMPUTED BY GATE CHAMBER CHECKED BY TW

MADE IN CONNECTION WITH _____

METRIC


PLAN VIEW (n.t.s.)

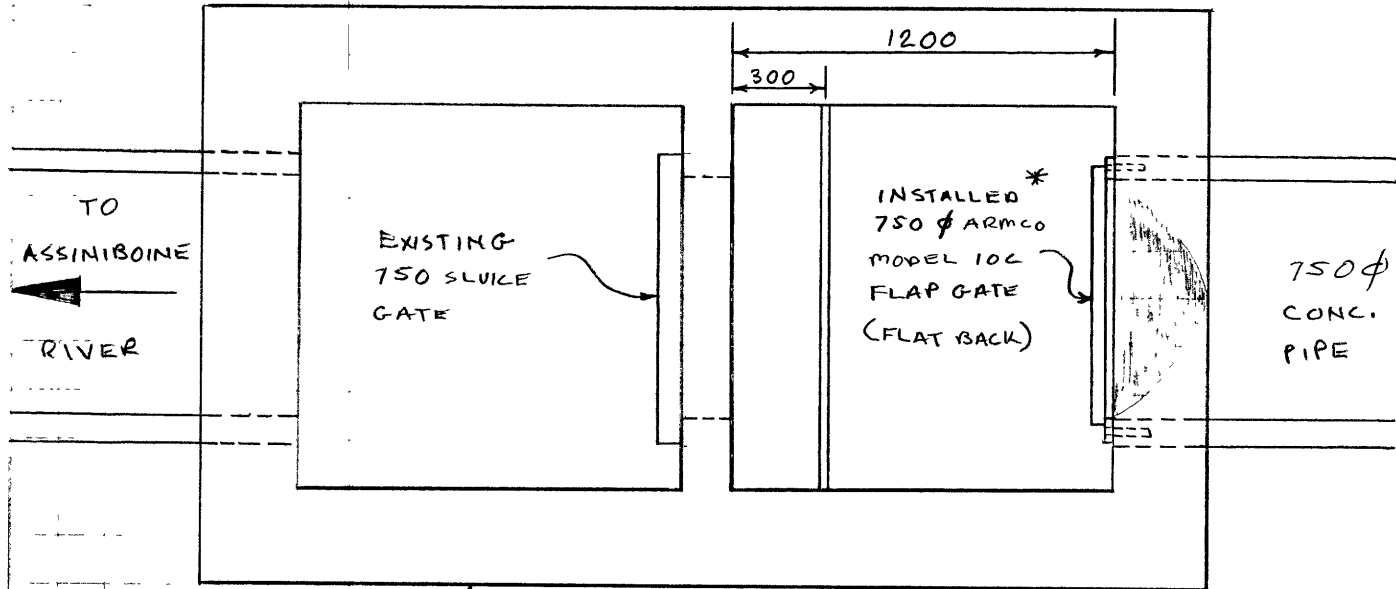

CONCRETE GATE CHAMBER

* GATE INSTALLED BY WATERWORKS, WASTE AND DISPOSAL DEPARTMENT REGIONAL OPERATIONS PERSONNEL

PROFILE (n.t.s.)

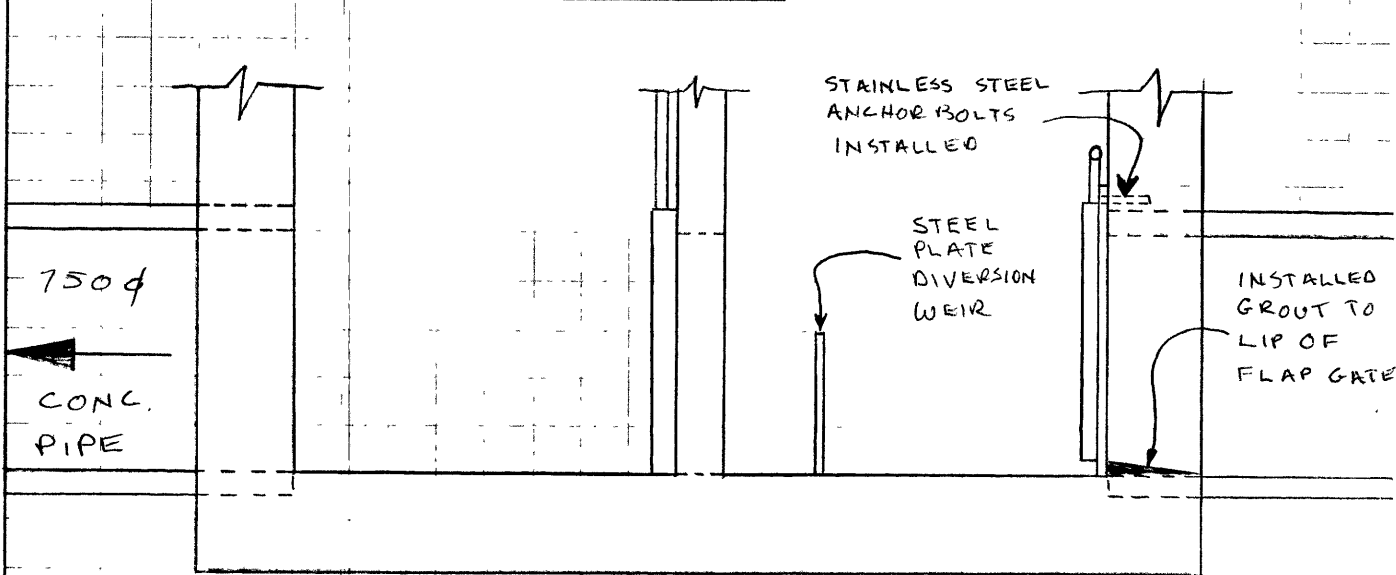

2.0 # MS 11952