



UMA FILE NAME: P83-001-01-1-5-2002_P83.dwg
 DATE: 2007/02/21
 FILE NAME: P83-001-01-1-5-2002_P83.dwg
 DESCRIPTION: Second Floor Demolition
 PROJECT No: P83-001-01
 PLOT: 07/10/11 3:25:25 PM
 ADDRESS: 989 Sargent St. Winnipeg, Manitoba

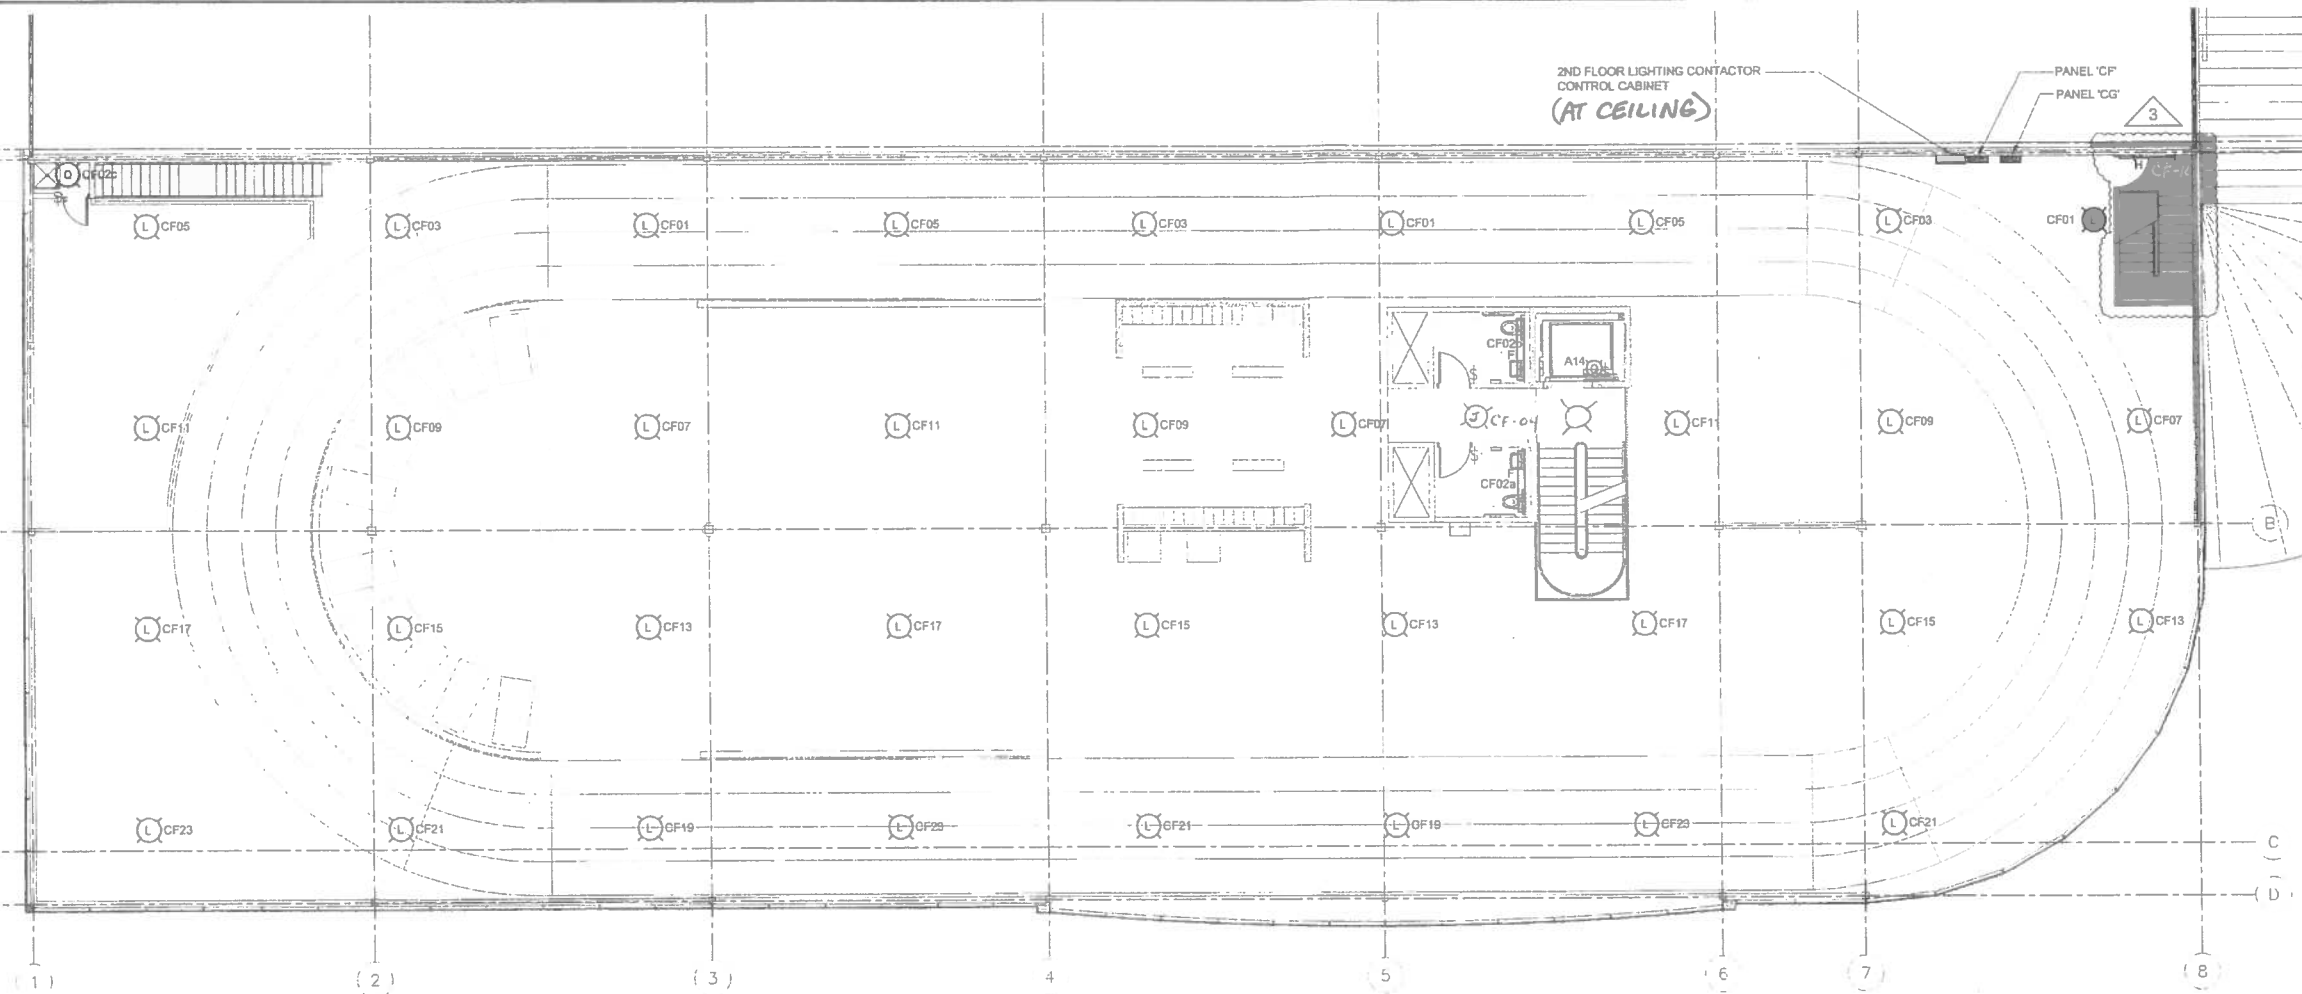

PLAN
 TRACK PLAN
 LIGHTING AND SYSTEMS
 SCALE 1:100

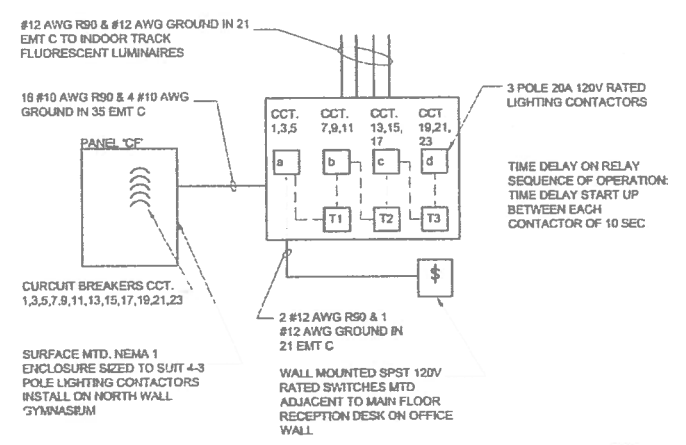

TRACK AREA LIGHTING CONTROL BLOCK DIAGRAM
 SCALE: 1:1.5

UMA | AECOM
 © 2007 UMA ENGINEERING LTD. ALL RIGHTS RESERVED.
APEGM
 Certificate of Authorization
 UMA Engineering Ltd. (MB)
 No 256 Date: Oct. 31/07
 DRN CHK DES ENG IDR
 UMA REVIEW

NO.	REVISION/DESCRIPTION	BY	DATE
3	PCN NO. 1	CL	07/10/11
2	ISSUED FOR CONSTRUCTION	CL	07/09/12
1	ISSUED FOR ADDENDUM #2	CL	07/08/21
0	ISSUED FOR TENDER	CL	07/07/23

SEALS
 PROVINCE OF MANITOBA
 Oct 31/07
 B.L. MOORE
 REGISTERED PROFESSIONAL ENGINEER

DRAWN BY: [Signature] DATE: 2007/02/21
 CHECKED BY: [Signature] USER APPROVAL
 APPROVED: [Signature]

CITY OF WINNIPEG
 PLANNING, PROPERTY & DEVELOPMENT DEPARTMENT
 CIVIC ACCOMMODATIONS DIVISION
 300 - 65 GARRY ST. R3C 4K4
 PROJECT: **GYM LIGHTING UPGRADE**
999 SARGENT AVENUE
 989 Sargent St. Winnipeg, Manitoba

CHECKED JUL 05 2013
 McCAINE ELECTRIC LTD.
 105 LOWSON CRESCENT
 WINNIPEG, MB R3P 2H8

AS BUILT

SHEET TITLE
 Electrical EXISTING
 Second Floor - Track Plan
 Lighting and Systems

SCALE: 1:100
DWG ET.0

DRAWING SHEET SIZE: A1 (841mm x 594mm) PLOT 1:1
BID OPP # 865-2015