


#	date	issued notes
2	2016.08.25	ISSUED FOR ADDENDUM #2
1	2016.08.16	ISSUED FOR ADDENDUM #1
0	2016.07.15	ISSUED FOR CONSTRUCTION

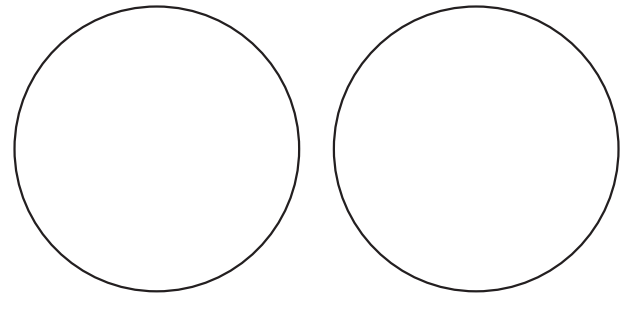

**SEVEN OAKS POOL RENOVATION & ADDITION**  
444 ADSUM DRIVE  
WINNIPEG, MB  
CANADA

client


CITY OF WINNIPEG  
4TH FLOOR - 85 KING ST.  
WINNIPEG, MB

**Roof Framing Plan**


drawn by: M.B. / AVP  
approved by: FDW

scale: As indicated  
date issued: 2016.07.12  
proj. #: W14432  
rev. #: 2

**SEVEN OAKS POOL RENOVATION & ADDITION**  
BID OPPORTUNITY NO. 645-2016

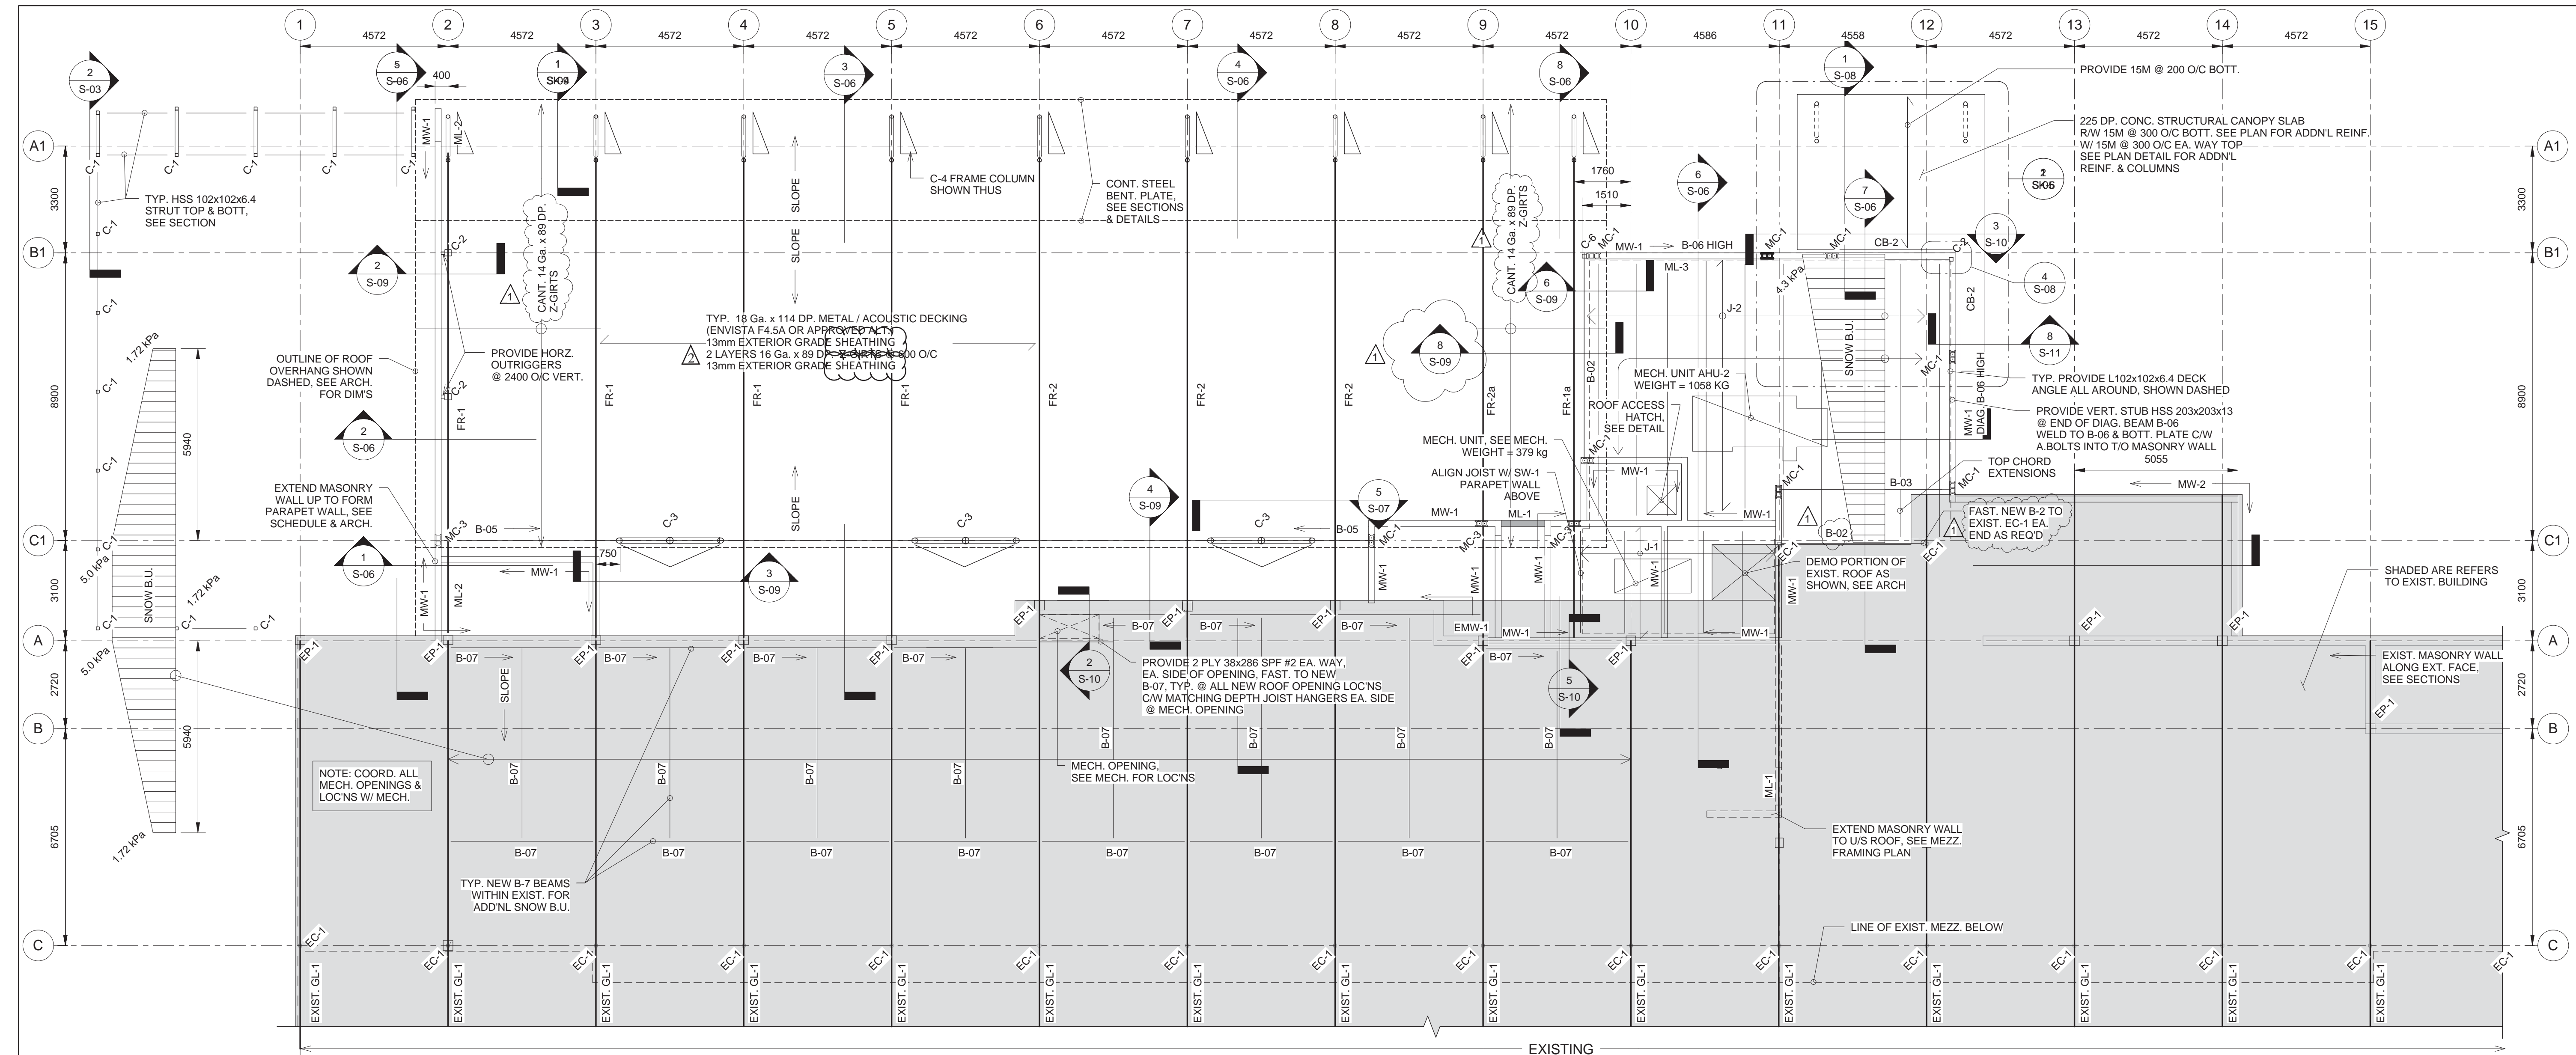


**1 New Roof Framing Plan**  
1 : 100  
DEAD LOAD: 1.0 kPa  
SNOW LOAD: 1.72 kPa + DRIFTING AS SHOWN

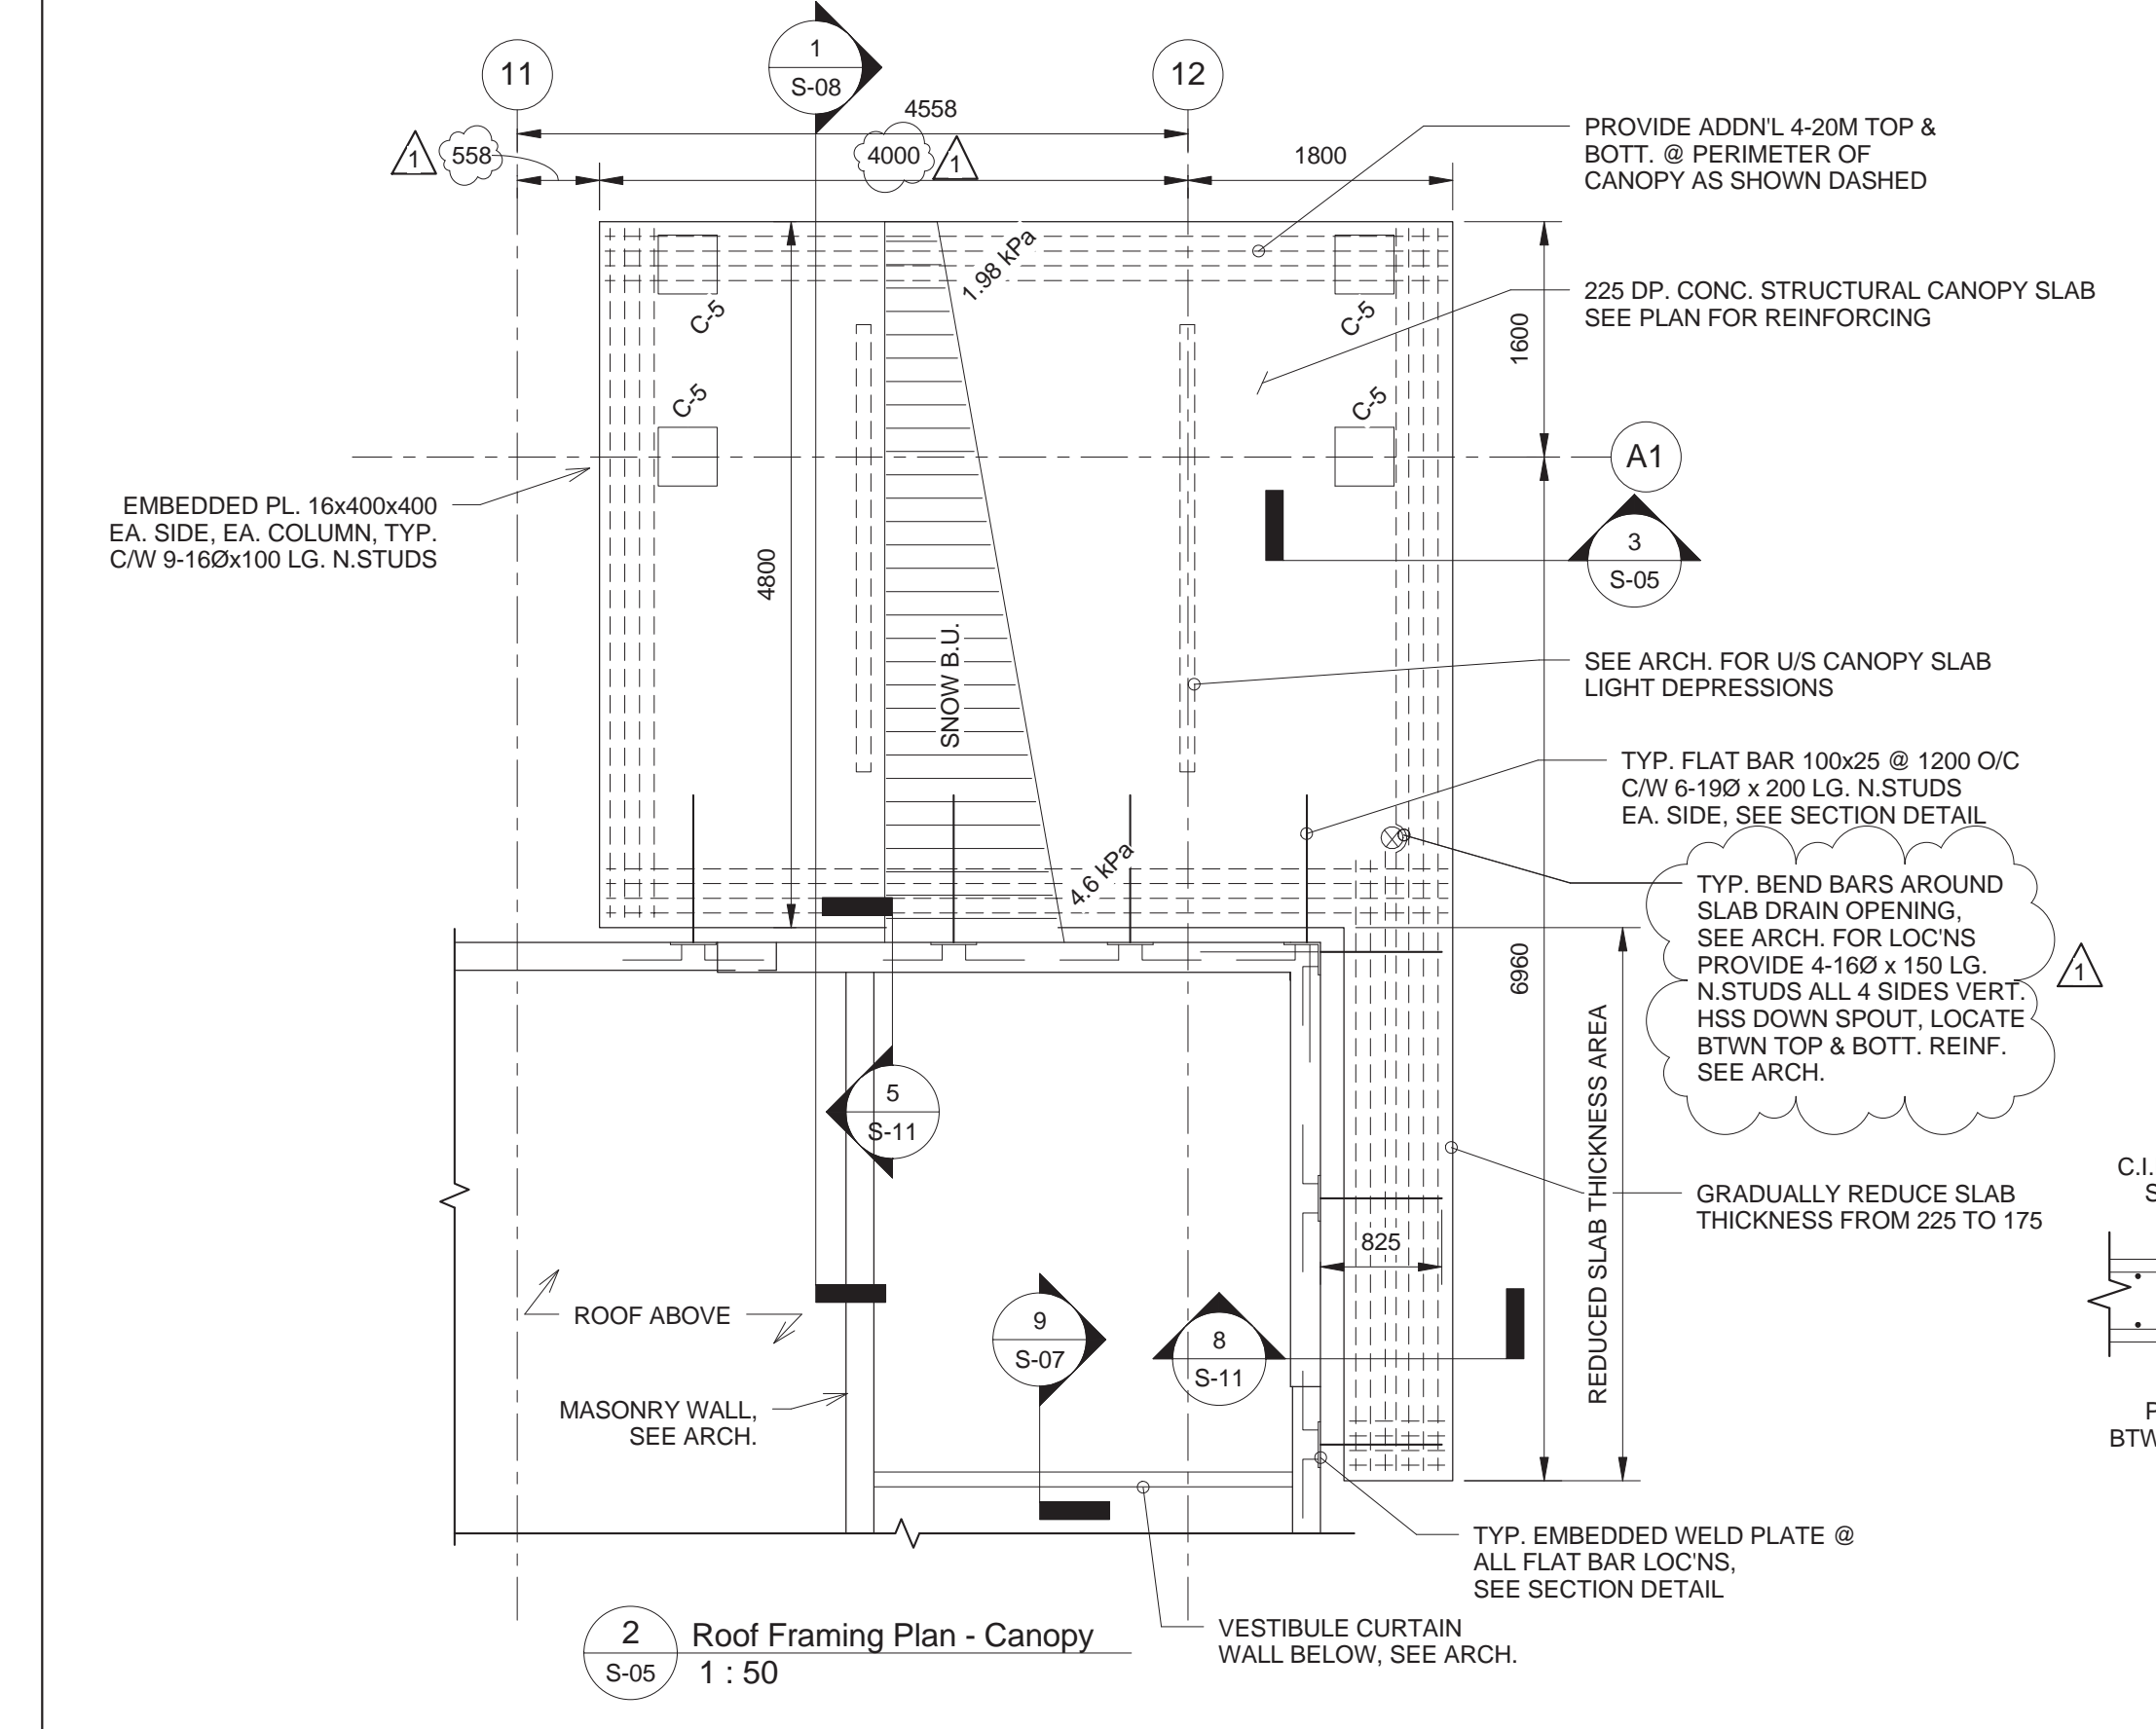

**2 Roof Framing Plan - Canopy**  
1 : 50

**3 Section**  
1 : 20

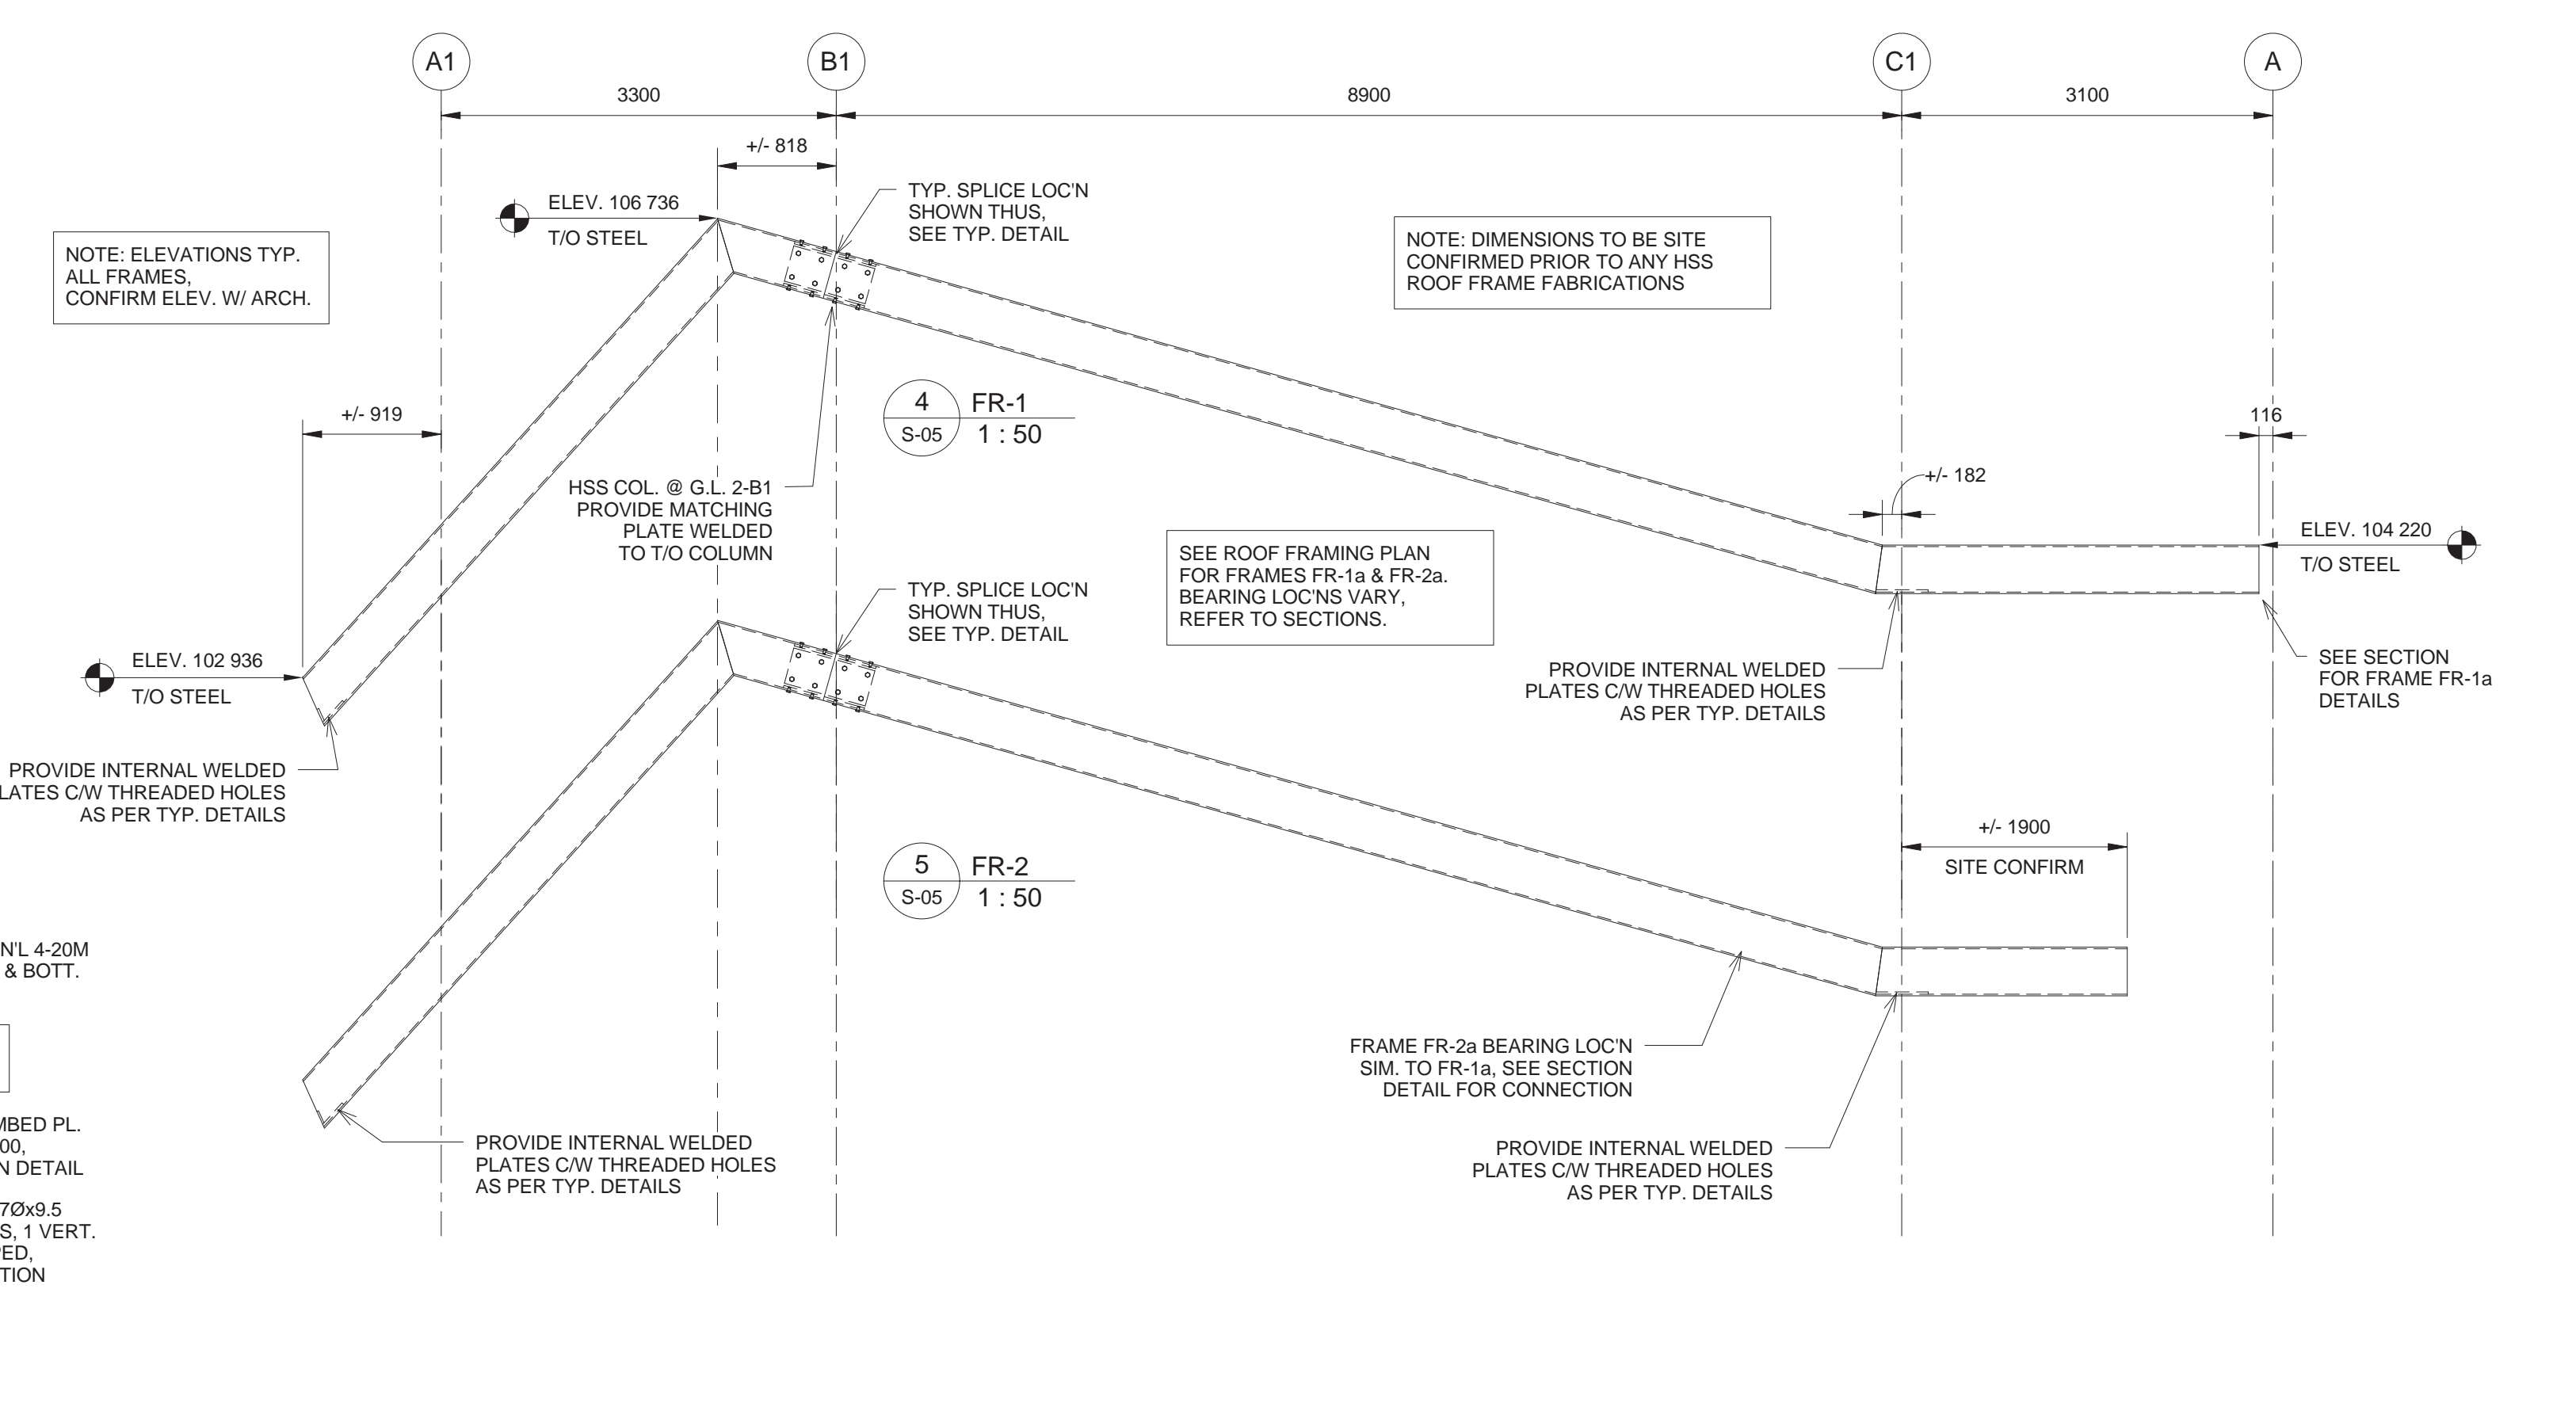

This drawing must not be scaled. The contractor shall verify all dimensions and other data on site prior to commencement of work. All discrepancies, errors, and omissions are to be reported to the architect. Drawings and specifications, as instruments of service, are the property of the architect. No reproduction may be made without the permission of the architect, and when made, must bear his name. All prints to be returned to the architect on request.