

NEW GRIT AND SCREENINGS BUILDING NO. OF STOREYS: TWO, BUILDING AREA: 489 SQ.M. BLDG.CLASSIFICATION: MEDIUM HAZARD INDUSTRIAL OCCUPANCY F2

EBF L.D. L/H ALLOWED PROPOSED FRR LISTED DESIGN COMB. AREA (SQ.M.) (M) H/L % OF OPNGS % OF OPNGS (HRS) DESCRIP. CONSTR CLADDING NON-COMB. CONSTR. 5%*NOTE 1 0%*NOTE 3 1HR WALL TYPE B 2HRS WALL TYPE A NON-COMB. YES 0 <3:1 23% 0%*NOTE 1 2HRS WALL TYPE A
NOT APPLICABLE - NO FACING WALLS 4HRS WALL TYPE B NON-COMB. NON-COMB. NOT APPLICABLE - NO FACING WALLS NOT APPLICABLE - NO FACING WALLS -- NON-COMB. 4HRS WALL TYPE A&B

EXISTING STANDBY POWER BUILDING

NO. OF STOREYS: ONE

BLDG.CLASSIFICATION: LOW HAZARD INDUSTRIAL OCCUPANCY F3 NBC TABLES 3.2.3.1.B & 3.2.3.7 L.D. L/H ALLOWED EXISTING FRR LISTED DESIGN COMB. CLADDING NON-COMB. AREA (SQ.M.) (M) H/L % OF OPNGS % OF OPNGS (HRS) DESCRIP. CONSTR. NOT APPLICABLE - NOT ADJACENT TO NEW BUILDING/S NOT APPLICABLE - NOT ADJACENT TO NEW BUILDING/S NOT APPLICABLE - NOT ADJACENT TO NEW BUILDING/S

1HR WALL TYPE A1

EXISTING SERVICE BUILDING


NO. OF STOREYS: ONE

BLDG.CLASSIFICATION: LOW HAZARD INDUSTRIAL OCCUPANCY F3 NBC TABLES 3.2.3.1.B & 3.2.3.7

WALL	FBF		L.D.	L/H	ALLOWED	EXISTING	FRR	LISTED DESIGN	COMB.	CLADDING	NON-COMB.
	AREA	(SQ.M.)	(M)	H/L	% OF OPNGS	% OF OPNGS	(HRS)	DESCRIP.	CONSTR.	•	CONSTR.
EXST SOUTH		NOT AP	PLICA	ABLE -	NOT ADJACENT	T TO NEW BUIL	DING/S				
EXST WEST		NOT AP	PLICA	ABLE -	NOT ADJACENT	T TO NEW BUIL	DING/S				
EXST EAST (EE-1)	134		3	<3:1	18%*NOTE 2	18%		WALL TYPE A1		NON-COMB	. YES
EXST NORTH (EN-1)	42		20	<3:1	100%	14%		WALL TYPE A1		NON-COMB	. YES

- WALL TYPE A: STONE VENEER CLADDING, AIR SPACE, INSULATION, VAPOUR BARRIER, ON CONCRETE/CMU WALL (SEE DWG BDTL-G001)
- WALL TYPE B: PREFORMED METAL PANEL, AIR SPACE, INSULATION, VAPOUR BARRIER, ON CONCRETE/CMU WALL (SEE DWG BDTL-G001) - WALL TYPE A1: EXISTING TYNDALL STONE, AIR SPACE, RIGID INSULATION, VAPOUR BARRIER ON CONCRETE/CMU WALL
- 1. PROPOSED PERCENTAGE OF OPENING IS 0 PROVIDED THAT LOUVER OPENING TO PLENUM HAVING 1HR FRR AND PROTECTED WITH
- 2. FACING NEW PROTECTED OPENING IN A FIRE RATED WALL.
- 3. PROPOSED PERCENTAGE OF OPENING IS 0 PROVIDED THAT LOUVER IS PROTECTED WITH FIRE RATED DAMPER.

8% *NOTE 2

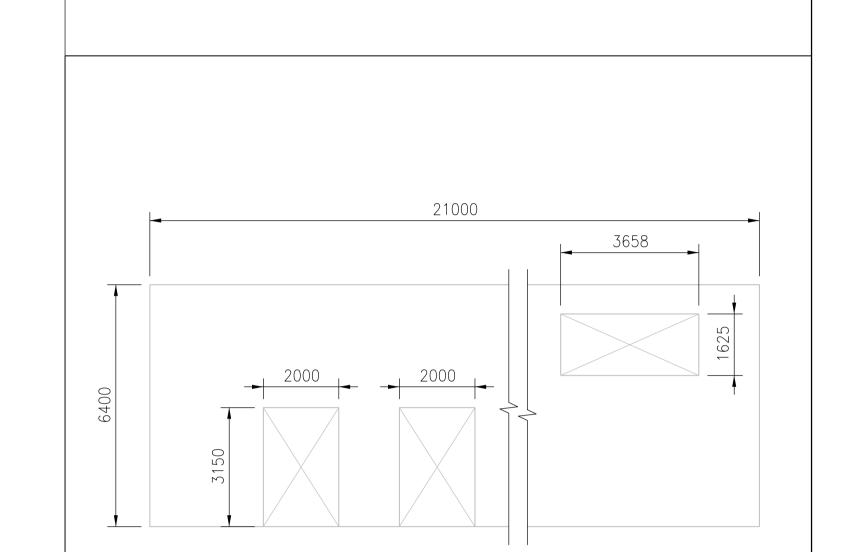

EXST ROAD

AIR TANK

EXST OPEN TO

FIRE HYDRANT

IMAGINARY LINE

(LIMITING DISTANCE)

EBF AREA: 134 sq.m. SERVICE BUILDING -EAST FACADE (EE-1)

<u>LEGEND</u>

NBC TABLES

-- NON-COMB.

3.2.3.1.C & 3.2.3.7

EXISTING FACILITY


NEW FACILITY/

FUTURE FACILITY

ENTRANCE / EXIT


MAIN ENTRANCE

EXTENSION

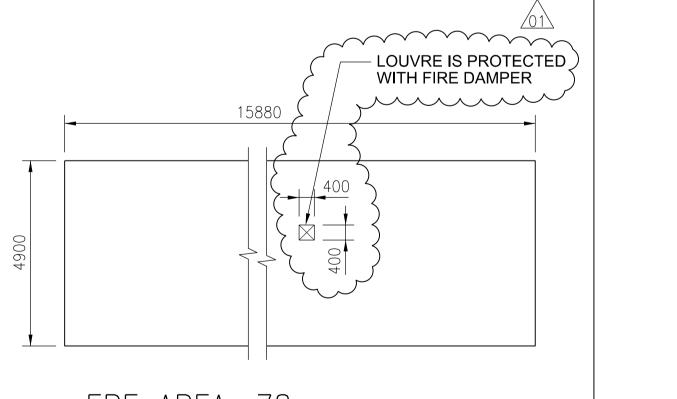

EBF AREA: 78 sq.m.
GRIT & SCREENING BUILDING - SOUTH FACADE (S-2)

EBF AREA: 42 sq.m. SERVICE BUILDING — NORTH FACADE (EN-1)

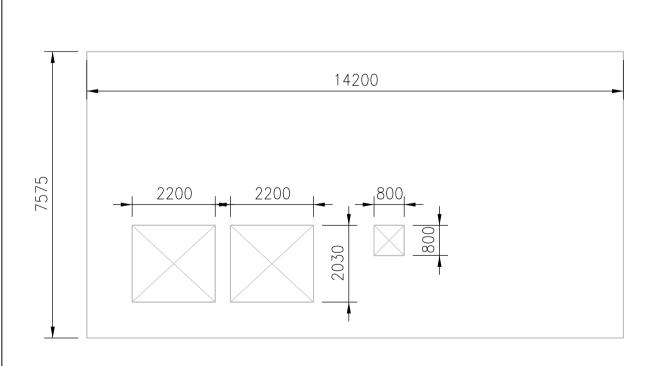

EBF AREA: 108 sq.m. STANDBY POWER BUILDING - NORTH FACADE (EN-2)

	EBF AREA: 109 sq.m.
	GRIT & SCREENING
\overline{z}	BUILDING - SOUTH FACADE (S-1)
	1:100

EBF AREA: 10sq.m.

GRIT & SCREENING

BUILDING - WEST

FACADE (W-1)

ENGINEER'S SEAL CH2MHILL CANADA Architects Inc. SNC·LAVALIN DESIGNED BY: B. KOLIS-HUPA R. ZAKKO APPROVED BY: DRAWN BY: **APEGIN** R. BATHAN H.T. FREIHAMMER SSUED FOR CONSTRUCTION SCALE: AS SHOWN **Certificate of Authorization** J. SHUMKA 2017/07/14 R.B. J.C. DATE: 2017/04/05 CH2M HILL Canada Ltd. D1 ISSUED FOR ADDENDUM 5 - 976-2016 DATE: 2017/04/05 J.C. CONSULTANT NO.: 474248 00 ISSUED FOR CONSTRUCTION - 976-2016 No. 1441 2017/04/05 J.L.

THE CITY OF WINNIPEG Winnipeg WATER AND WASTE DEPARTMENT

> SOUTH END WATER POLLUTION CONTROL CENTRE SEWPCC UPGRADING/EXPANSION PROJECT BUILDING

GRIT AND SCREENINGS BUILDING SITE PLAN AND SPATIAL SEPARATION CALCULATION

1-0102-BAAA-G002

PLOT DATE: 2017\07\14

FILE NAME: