

INSTRUMENT LOOP DIAGRAM


LOOP NO. - H330

M C C

FIELD PROCESS AREA


FIELD DEVICE PANEL

D.C.S.

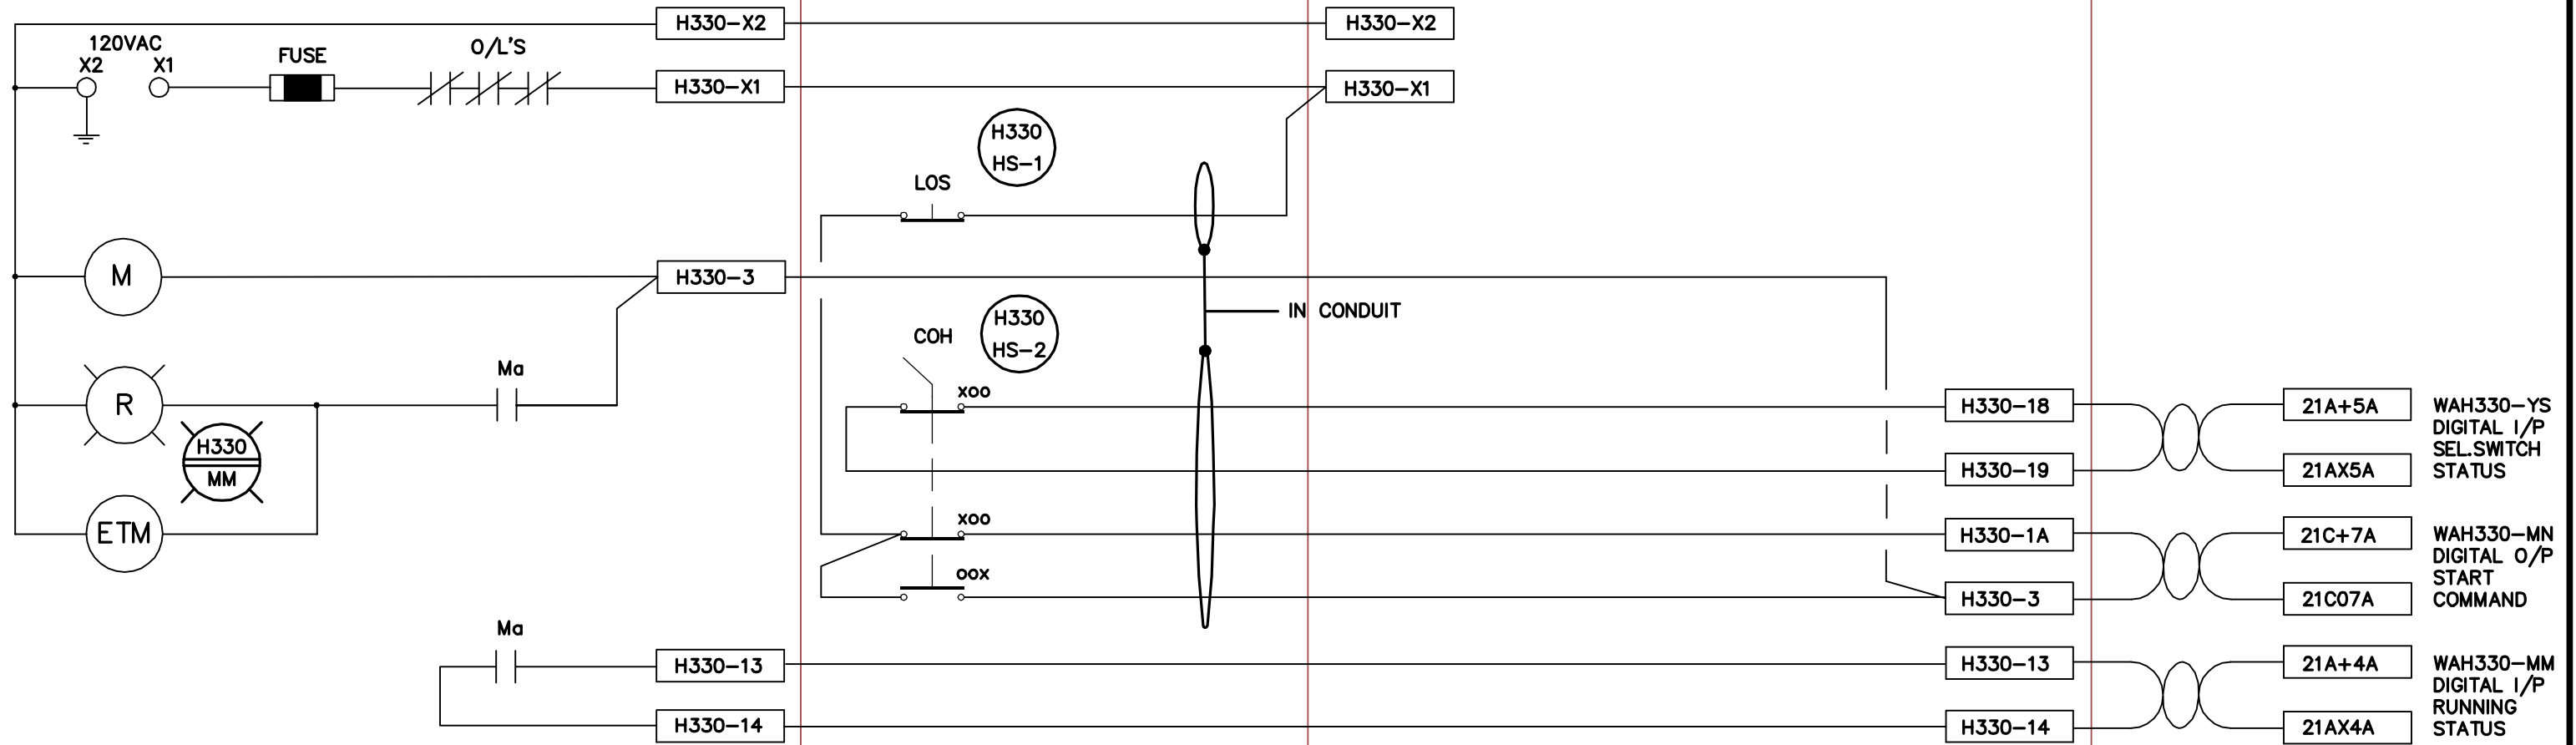

ILD-TYP9
421-H330

BAILEY TERMINAL NUMBERING

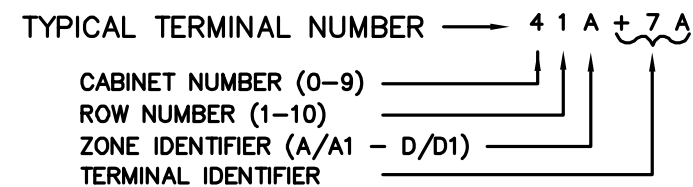

Reid
Crowther

OCT./93	AS BUILT	
DATE	REVISION	APP.



THE CITY OF WINNIPEG
WORKS AND OPERATIONS DIVISION
WATERWORKS, WASTE AND DISPOSAL DEPT.
WEST END WATER POLLUTION CONTROL CENTRE

HEADWORKS - DEWATERING
SCREW CONVEYOR #1 WAH330

SCALE N.T.S.
DATE MAY 1991
DES JVH DWN GGB
CKD BL APP _____

DRAWING NO.

WEP-421