


INSTRUMENT LOOP DIAGRAM

LOOP NO. - H344

FIELD


FIELD DEVICE PANEL

D.C.S.

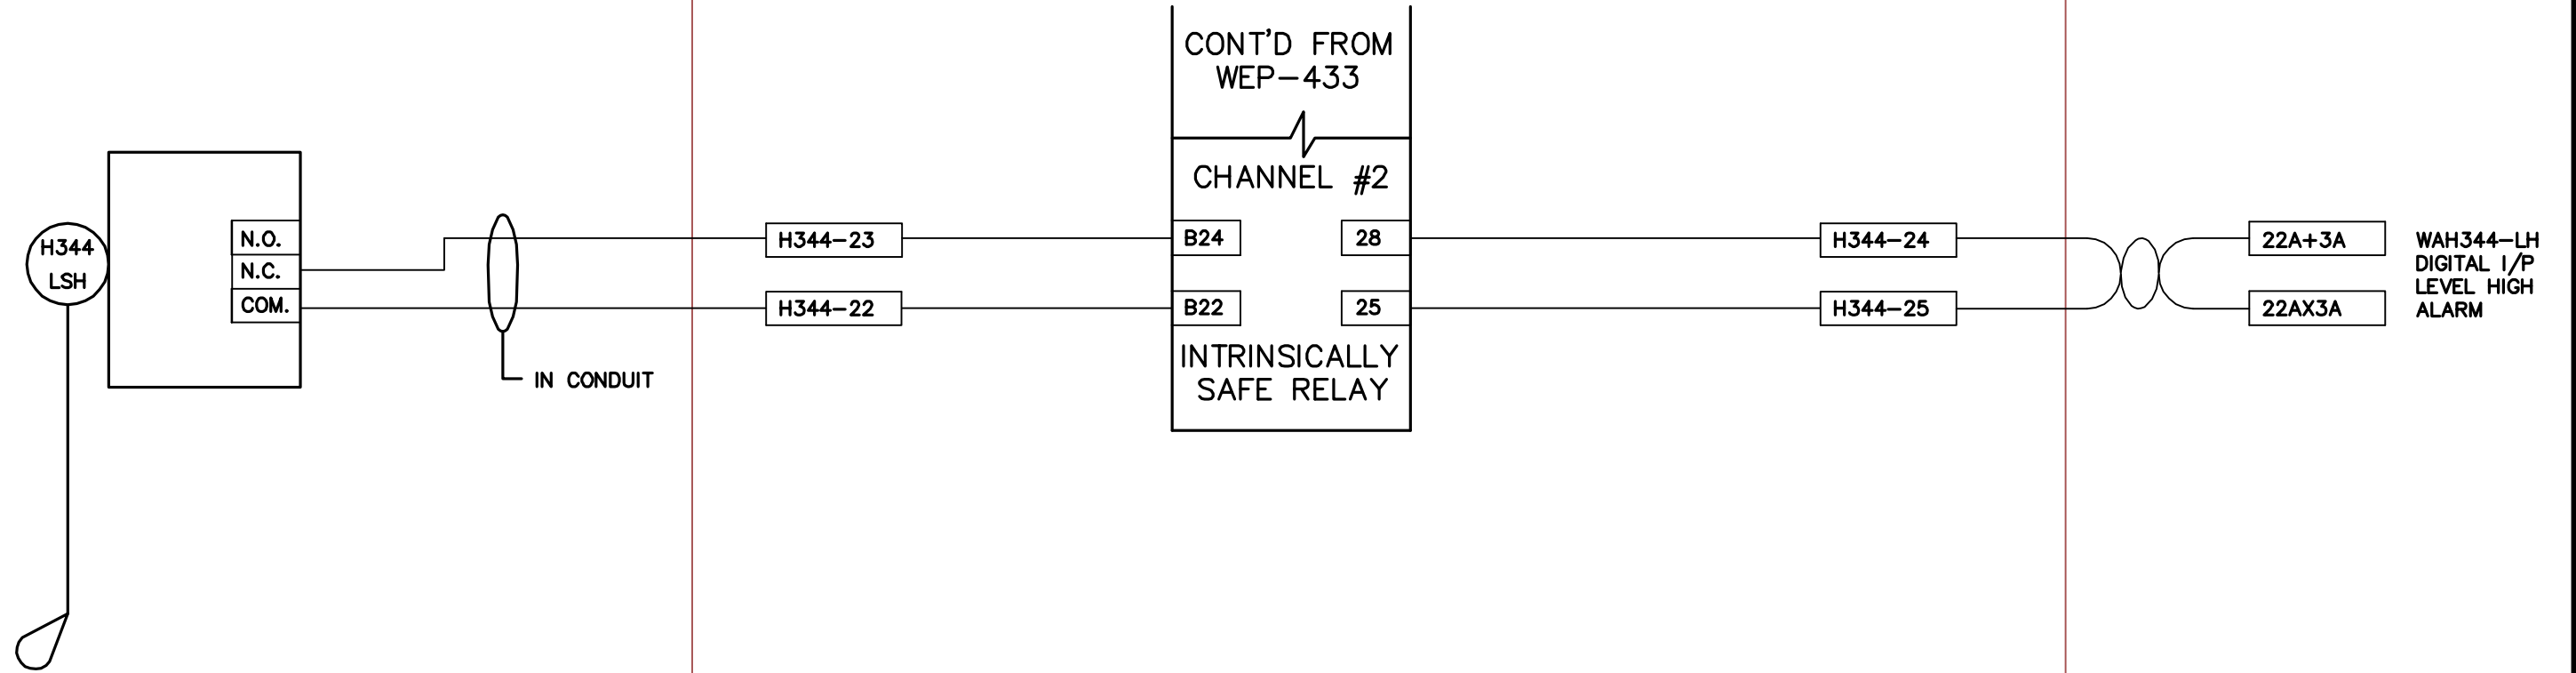

ILD-TYP18
425-H344

BAILEY TERMINAL NUMBERING

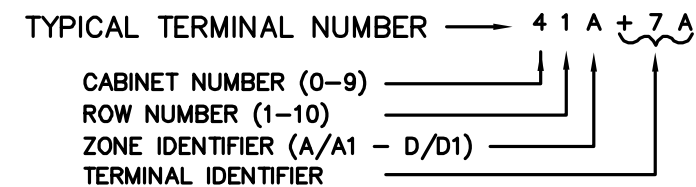

Reid
Crowther

OCT./93	AS BUILT	
DATE	REVISION	APP.



THE CITY OF WINNIPEG
WORKS AND OPERATIONS DIVISION
WATERWORKS, WASTE AND DISPOSAL DEPT.
WEST END WATER POLLUTION CONTROL CENTRE

HEADWORKS - DEWATERING CONVEYOR #2
LEVEL SWITCH WAH344

SCALE N.T.S.
DATE MAY 1991
DES JVH DWN GGB
CKD BL APP _____

DRAWING NO.

WEP-425