



PART PLAN ABOVE EL 0.075

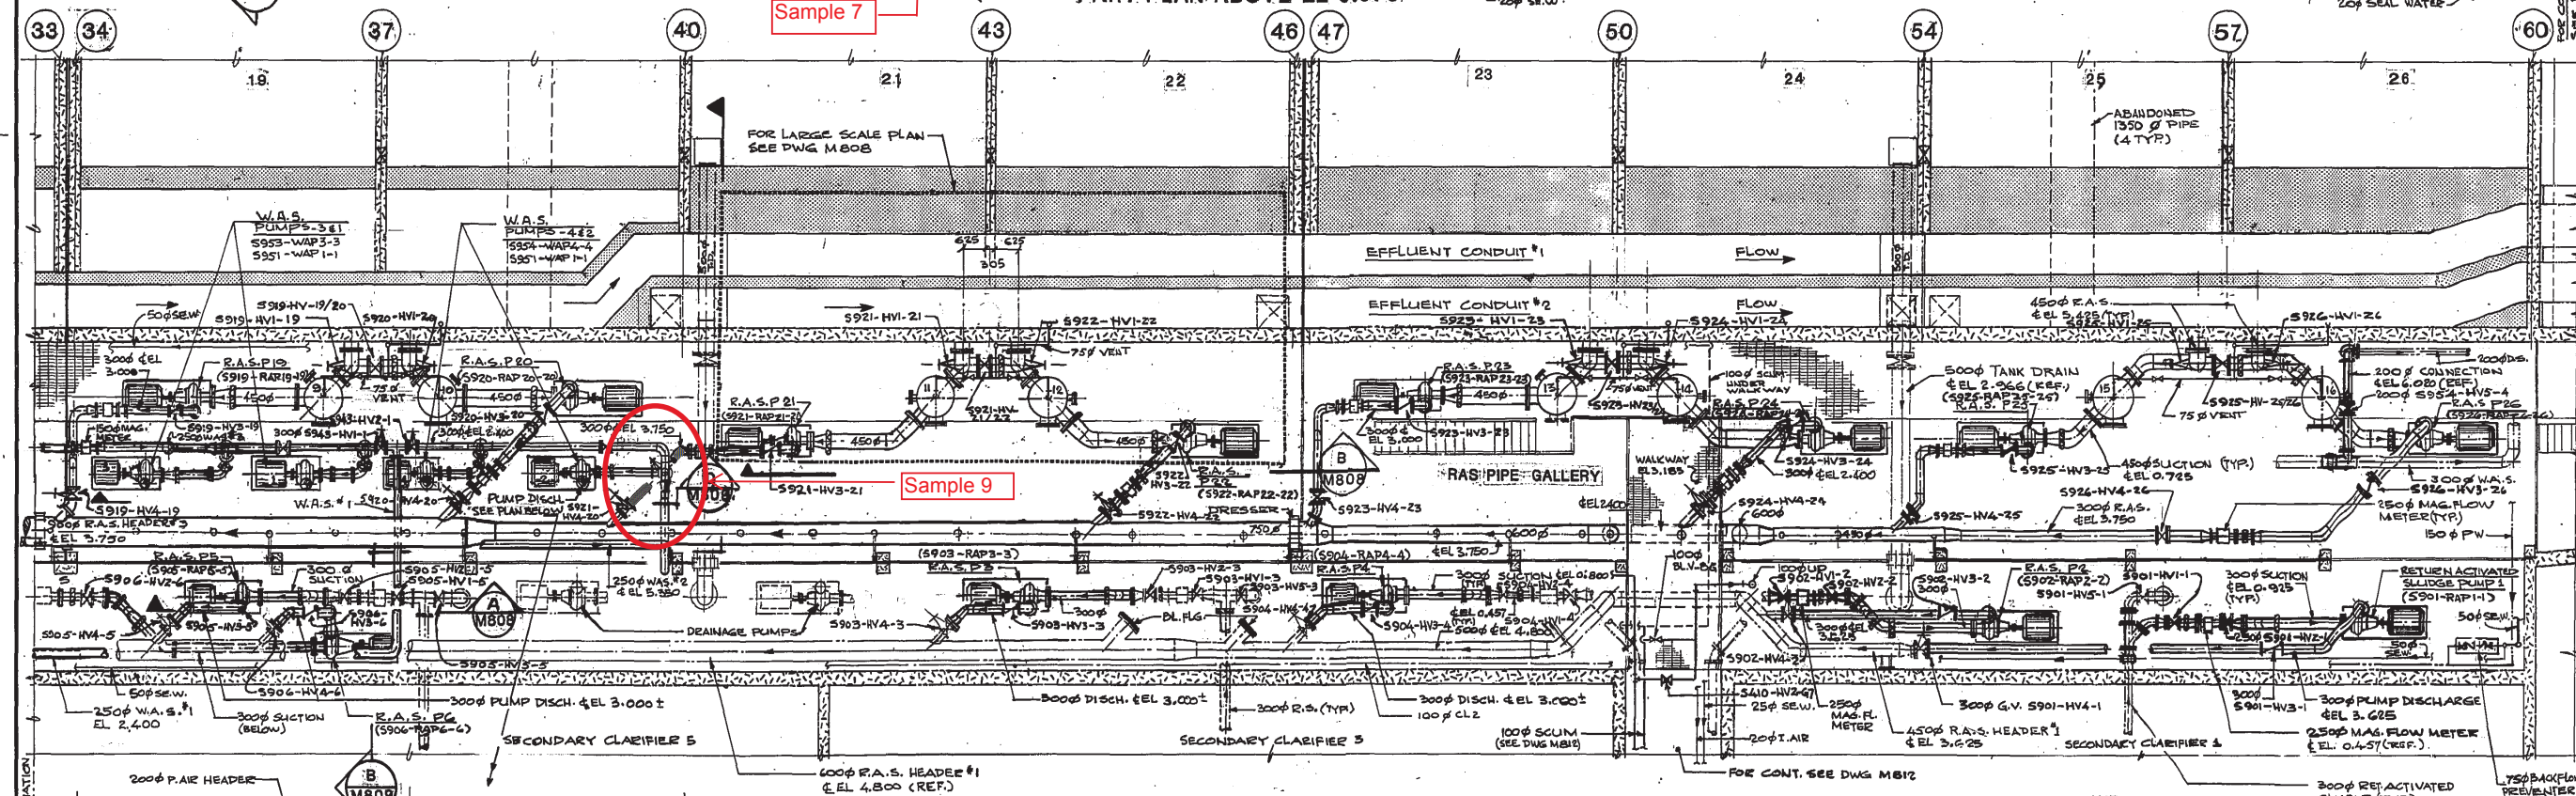

PART PLAN ABOVE EL 0.075

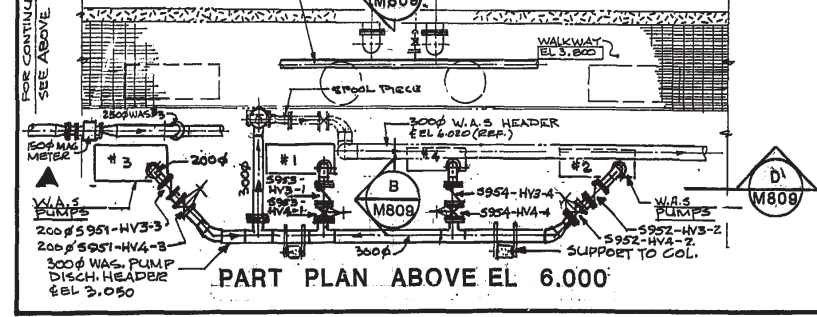


PART PLAN ABOVE EL 6.000


AS - BUILT		
DATE	FB. NO.	PAGE
MAR. 88		

METRIC		
WHOLE NUMBERS INDICATE MILLIMETRES		
DECIMALIZED NUMBERS INDICATE METRES		

4	AS CONSTRUCTED	MAR 88	H.S.
3	ISSUED FOR TENDER	SEPT 85	G.M.
2	—	MAR 85	H.S.
1	FINAL REVIEW	27/11/84	P.B.
NO.	REVISIONS	DATE	APP.

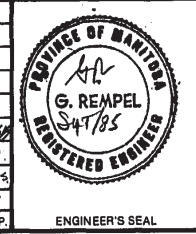

W.L. WARDROP & ASSOCIATES LTD. MacLAREN ENGINEERS INC.	
DESIGNED BY: V.M./R.D.J.	DRAWN BY: H.S.
CHECKED BY: S.P.	DATE: SEPT/1985
APPROVED BY: <i>[Signature]</i>	DATE: Sept 85

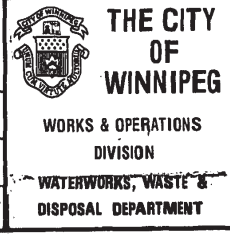

NORTH END WATER POLLUTION CONTROL CENTRE SECONDARY TREATMENT EXPANSION SECONDARY CLARIFIERS-MECHANICAL RAS PIPE GALLERY PLAN ABOVE EL 0.075	
RELEASED FOR CONSTRUCTION:	DATE:
<i>[Signature]</i>	1985 09 12
SCALE:	DRAWING NO.:
1:100	NEP 14 13