




SITE PLAN
1:75

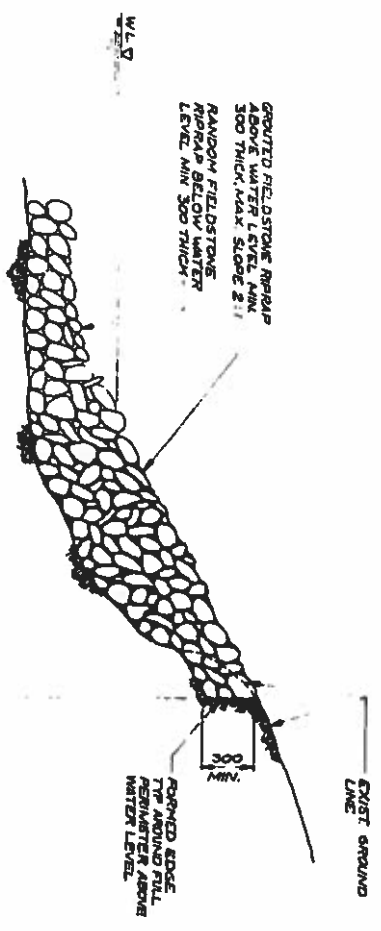

SECTION
1:20

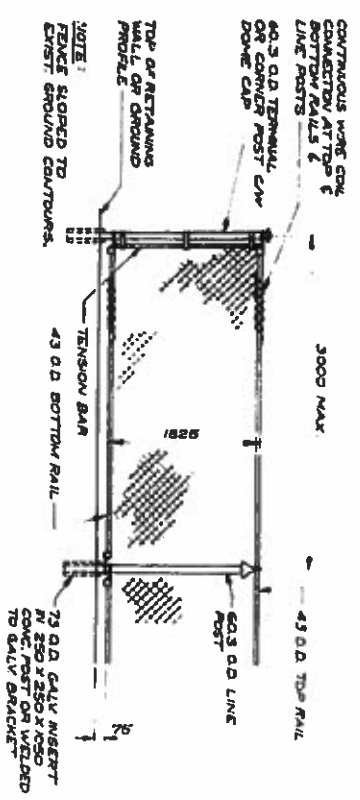

EXISTING CHAINLINK FENCE DETAIL
N.T.S.

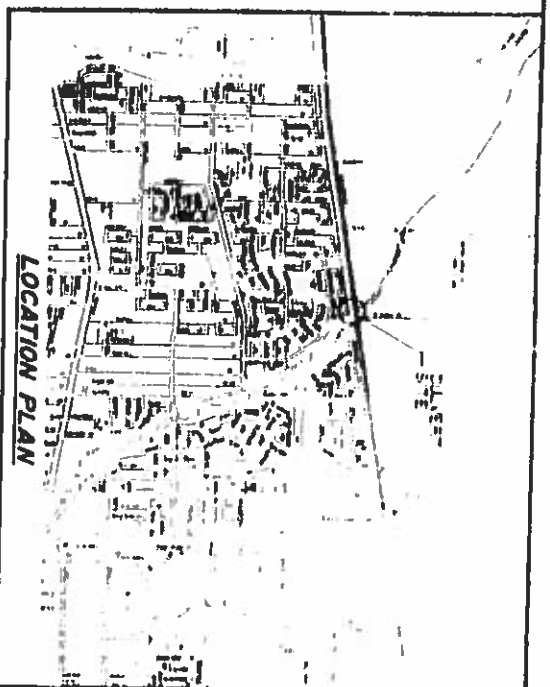

LOCATION PLAN

THE CITY OF WINNIPEG WORKS AND OPERATIONS DIVISION STREETS AND TRANSPORTATION DEPARTMENT 1991 BRIDGE MAINTENANCE MISCELLANEOUS REHABILITATION WORKS PAGE 1		SASKATCHEWAN AVE. CULVERT AT STURGEON CREEK RIPRAP & CHAINLINK FENCING REPAIR WORKS B-5891	

RECORD DRAWING