



REF. OF DRAWING No. M.C.P. - 23

DETAILS PLAN ABOVE ELEVATION 749.0  
MECHANICAL

Microfilm 1968

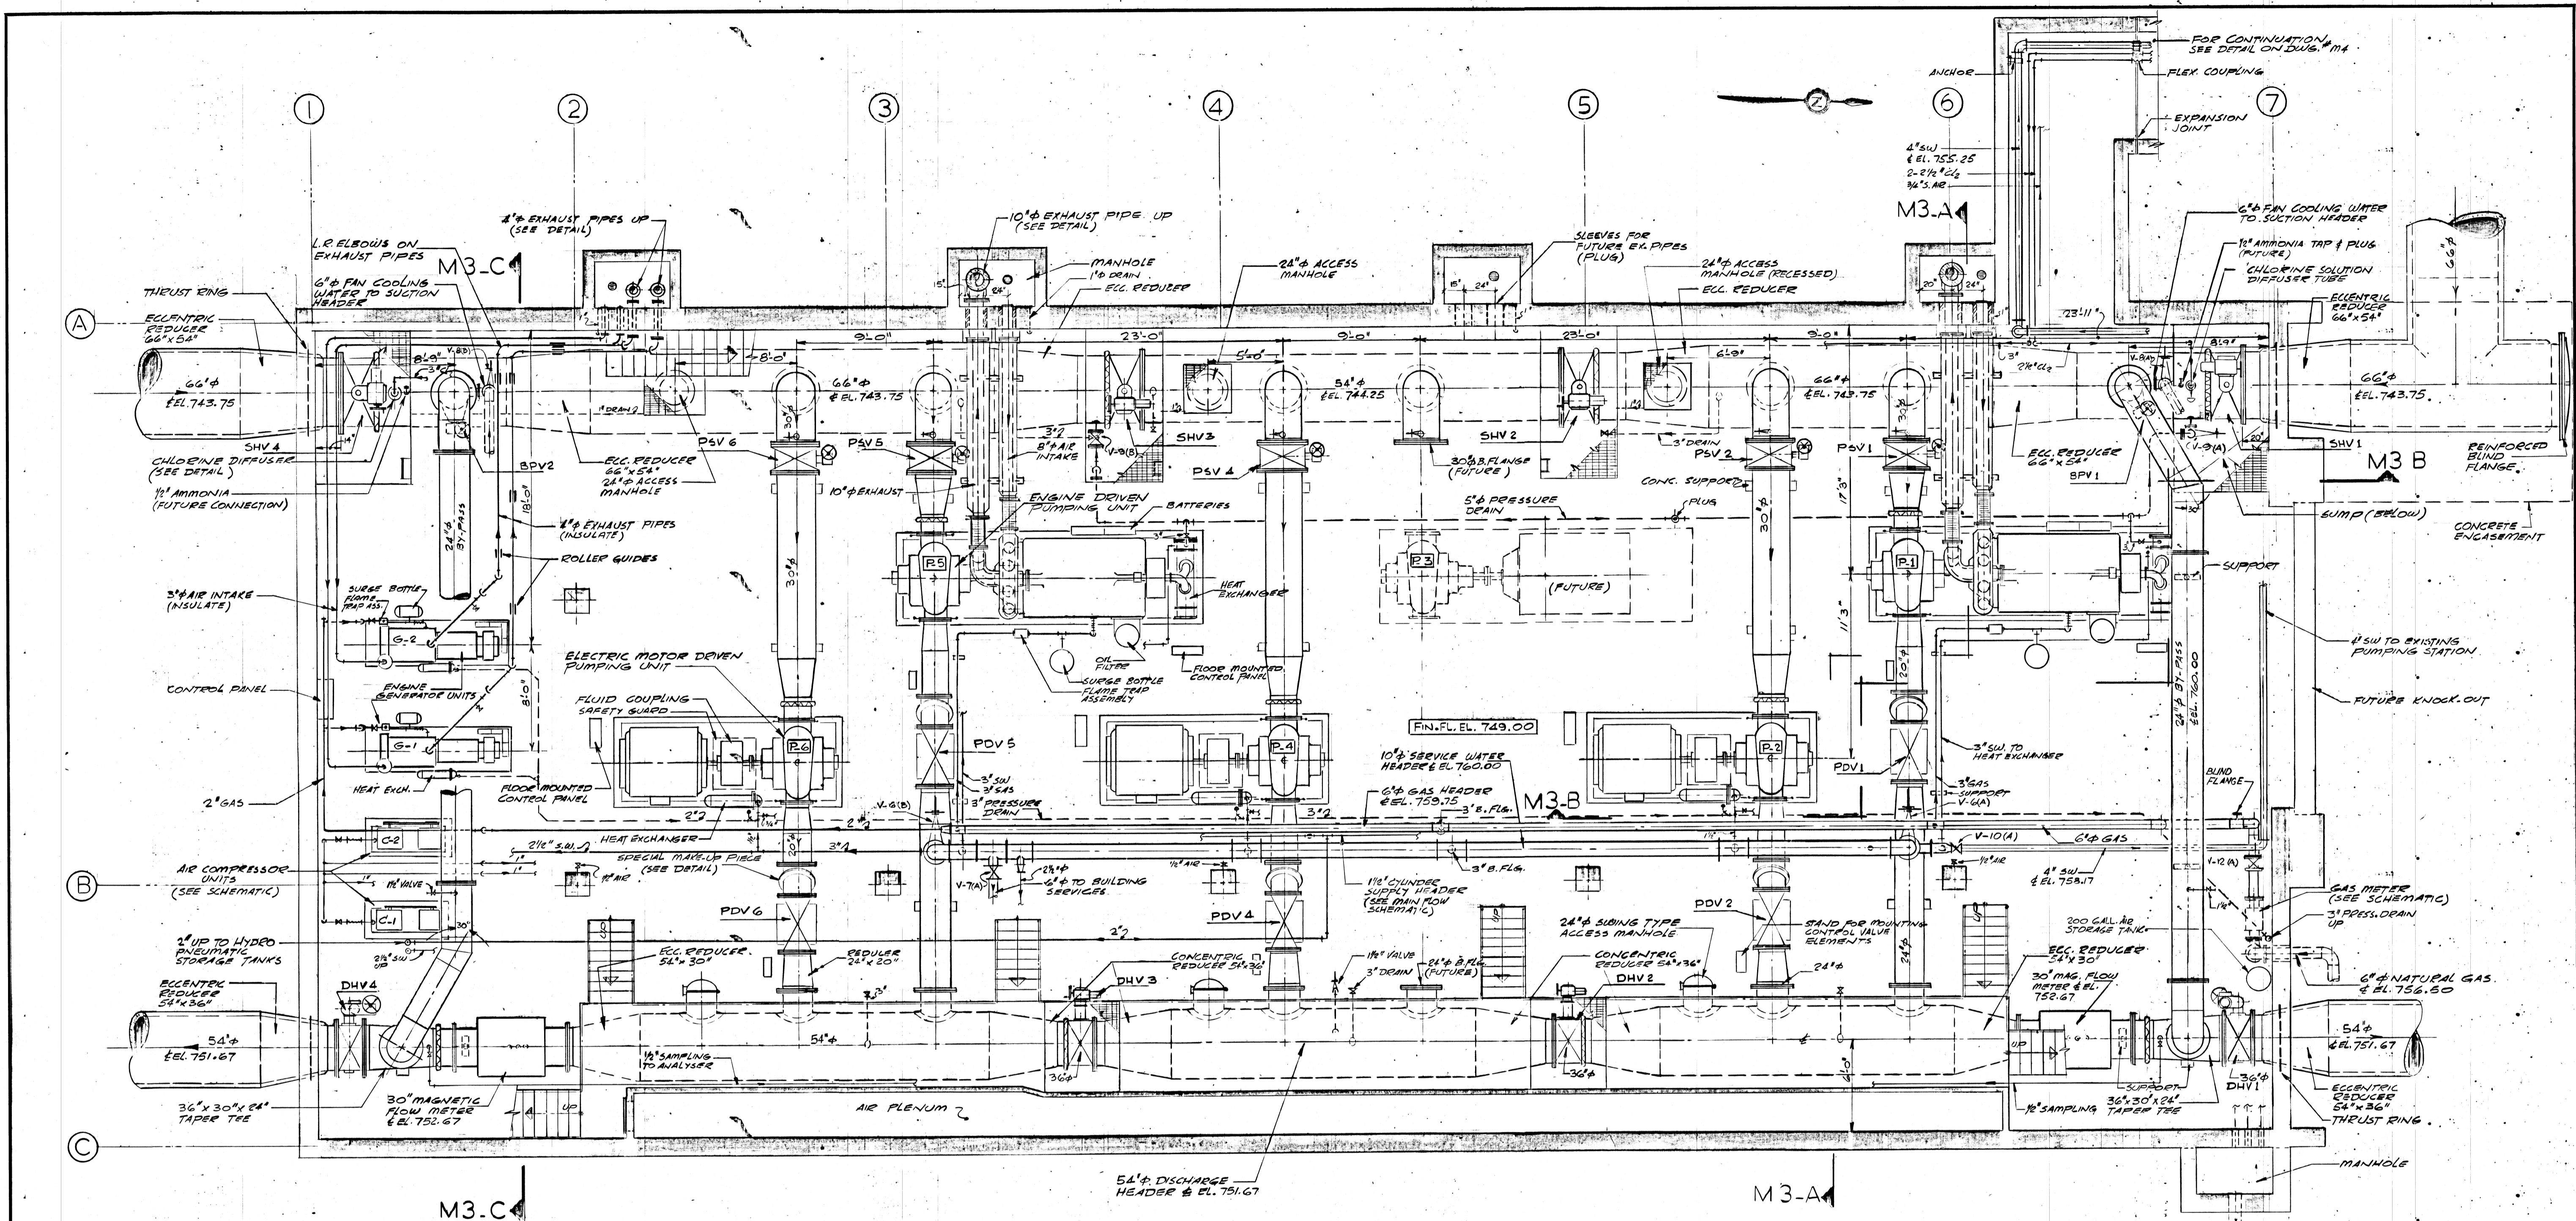

PLAN ABOVE EL. 749.00  
SCALE: 3/16" = 1'-0"

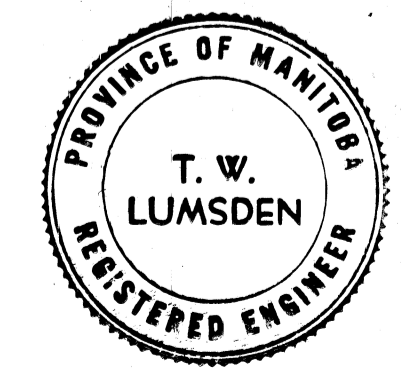

REVISIONS			THE METROPOLITAN CORPORATION OF GREATER WINNIPEG WATERWORKS AND WASTE DISPOSAL DIVISION	
DATE	No.	DETAIL		
11/10/67	15	AS CONSTRUCTED	<b>McPHILLIPS STREET PUMPING STATION</b> <b>CONTRACT "A"</b> <b>MECHANICAL-PLAN ABOVE ELEVATION 749.0</b>	
			APPROVED	
			<i>[Signature]</i>	ENGINEER OF DESIGN
			<i>[Signature]</i>	DEPUTY DIRECTOR AND CHIEF ENGINEER
			JAMES F. MACLAREN LIMITED CONSULTING ENGINEERS TORONTO LONDON	DIRECTOR
			DATE AUGUST 5/1968	SCALE 3/16" = 1'-0"
			DWG. No. M1 of 8	M.C.P.-23