

**-GENERAL PLAN-**  
SCALE 3/128"=1'-0"

*Note - G.C. should confirm all dimensions of concrete structure*

**WEST END WATER POLLUTION CONTROL CENTRE**  
**REID CROWTHER & PARTNERS LIMITED**  
 CONSULTING ENGINEERS AND PLANNERS

NO EXCEPTIONS TAKEN
PROCEED PER COMMENTS & RESUBMIT
<input checked="" type="checkbox"/> AMEND PER COMMENTS & RESUBMIT
REJECTED


Project No. 60910 Date July 26/92 By GJM

Reviewed only as to general conformity with the design concept. The Contract Administrator does not warrant or represent that the information contained on this drawing is either accurate or complete. Sole responsibility for correct design, details and dimensions shall remain with the party submitting the drawing.

Reviewed  
 Revise & resubmit  
 Reviewed as modified  
 Not reviewed

This review by Gaboury Associates Architects Inc. is for the sole purpose of ascertaining conformance with the general design concept. This review shall not mean that Gaboury Associates Architects Inc. approves the detail design shown in the shop drawings, responsibility for which shall remain with the Contractor submitting same, and such review shall not relieve the Contractor of his responsibility for errors or omissions in the shop drawings or of his responsibility for meeting all requirements of the Contract documents. The Contractor is responsible for dimensions to be confirmed and corrected at the job site for information that pertains solely to fabrication, installation and for co-ordination of the work of all substrates.

GABOURY ASSOCIATES ARCHITECTS INC.  
 July 26/92  
 Date  
 M. J. G. G.

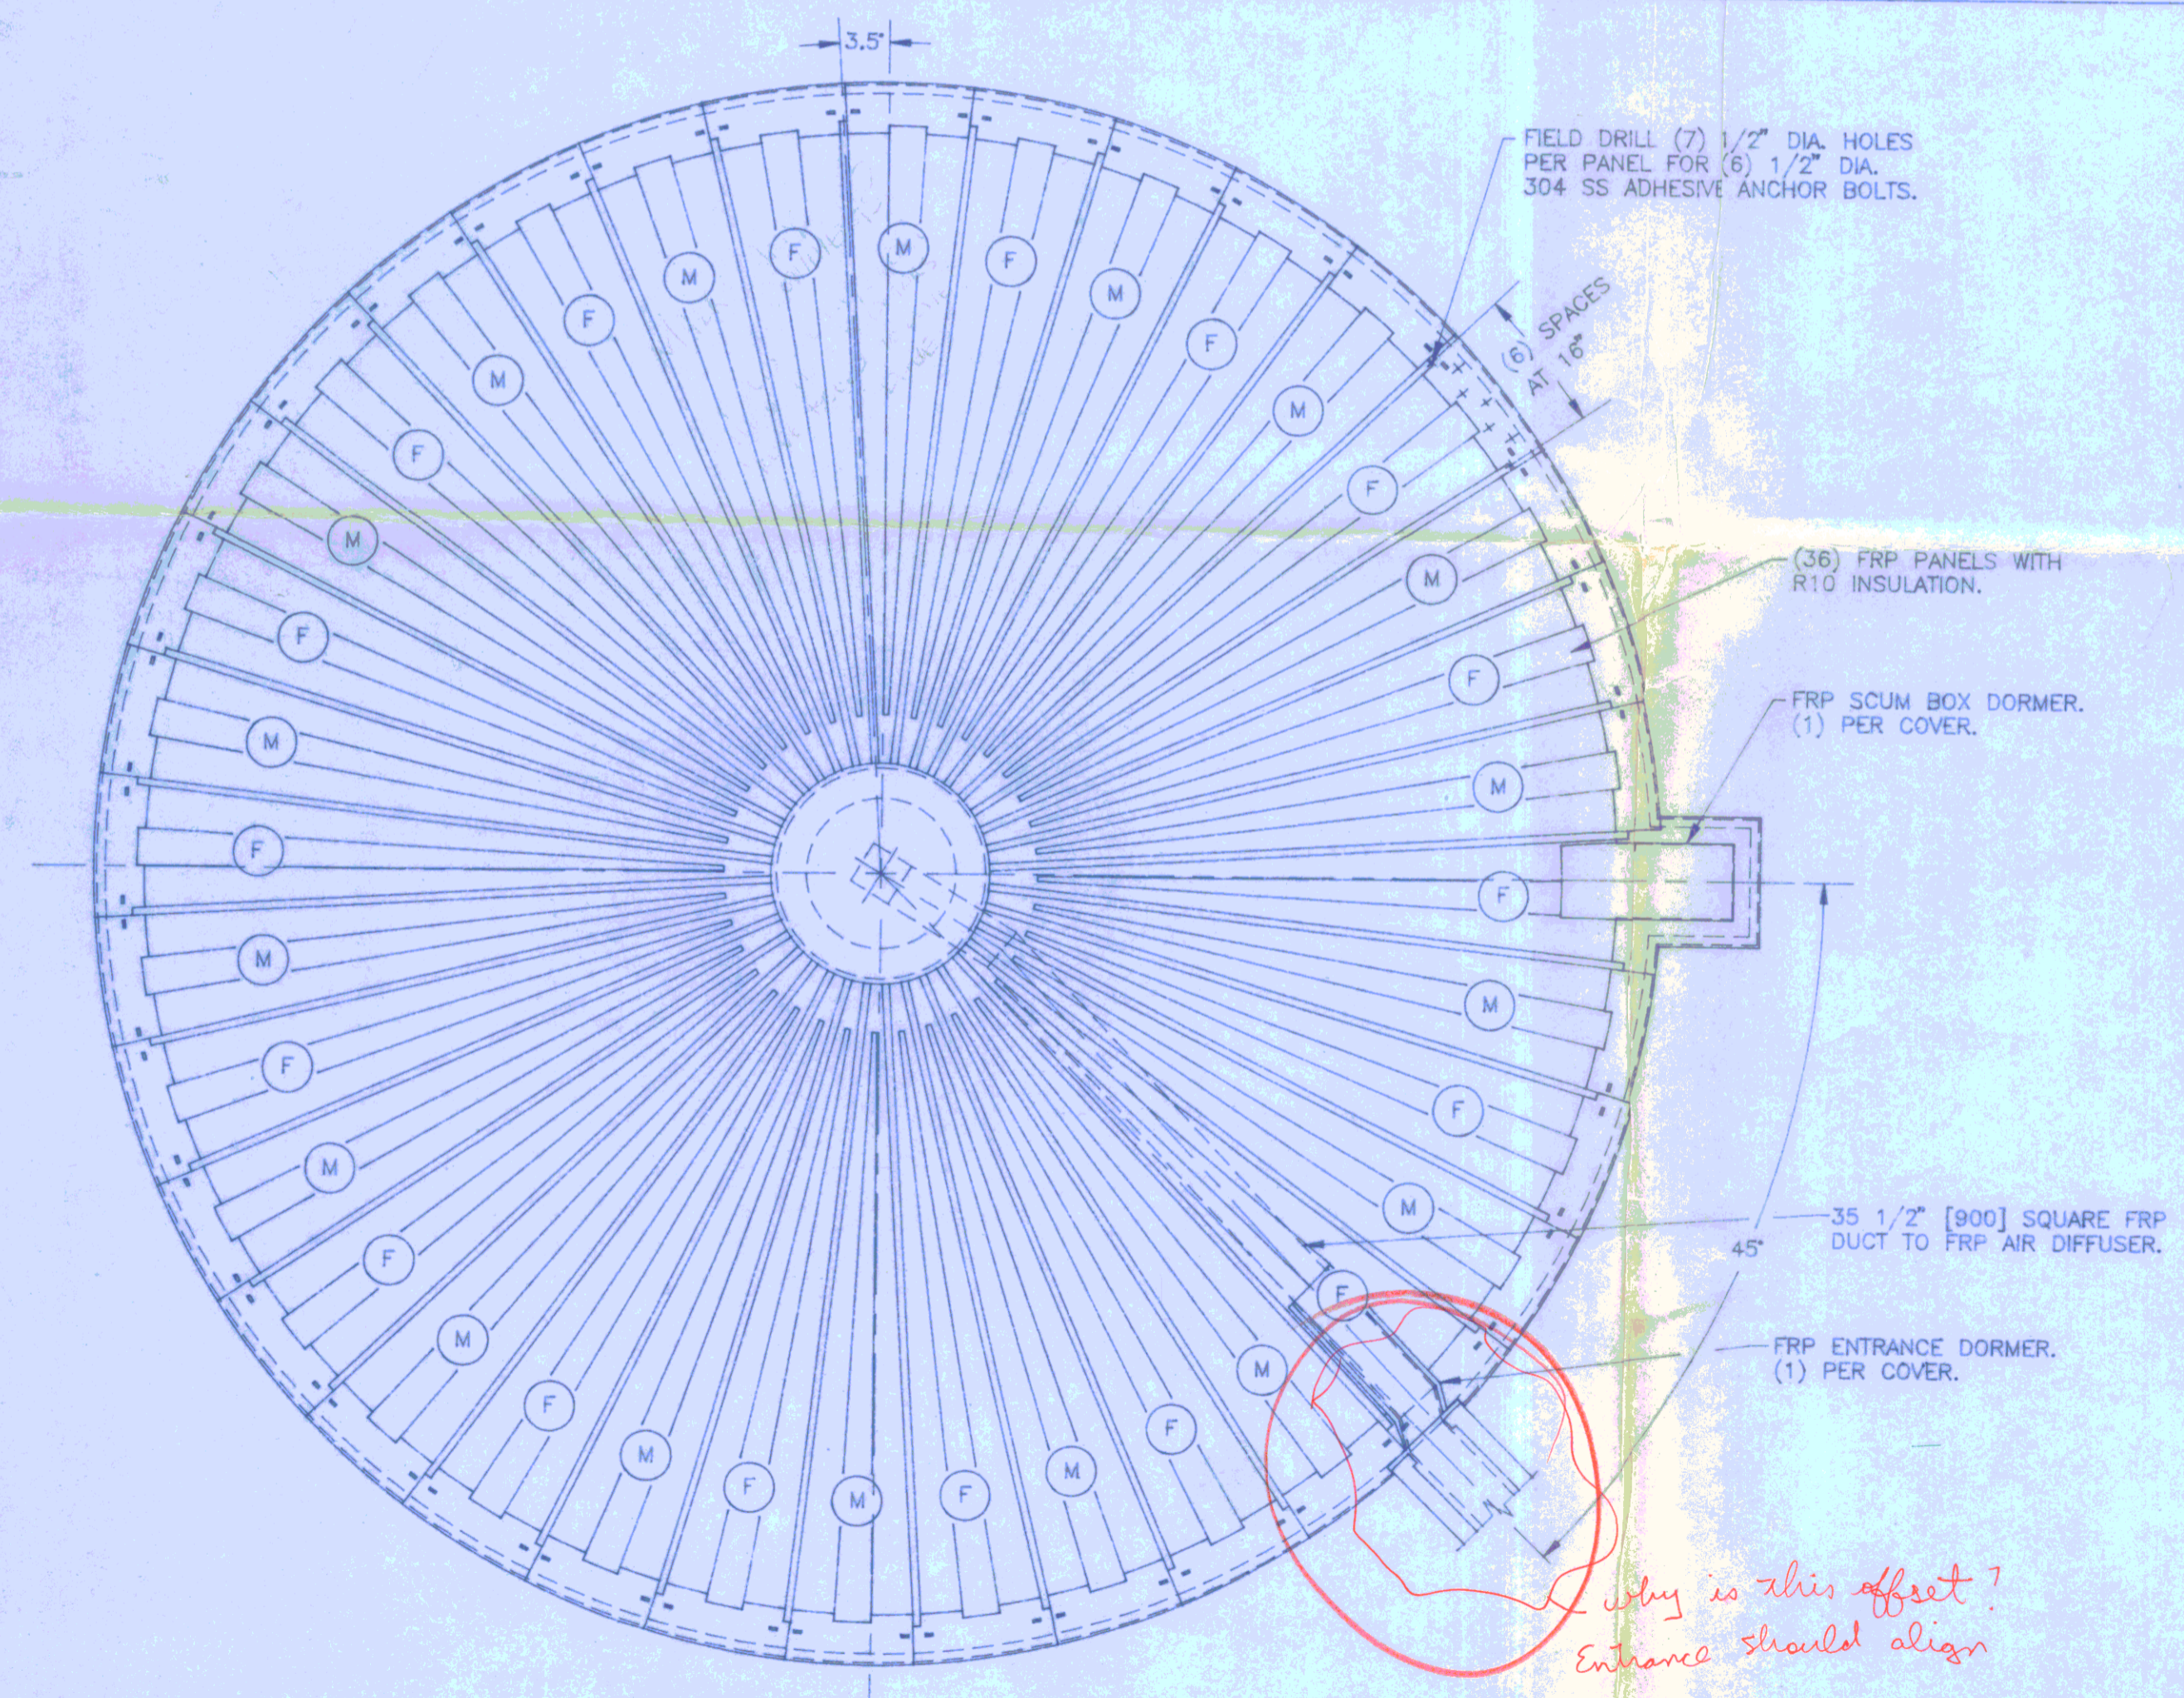

- NOTES:**
- DIMENSIONS IN [BRACKETS] ARE IN MILLIMETRES.
  - ALL FIBERGLASS THICKNESSES ARE NOMINAL
  - RESIN: GENERAL PURPOSE U.V. STABILIZED RESIN. INTERIOR SURFACES TO BE COATED WITH A CLASS 'A', TYPE 1, U.L. CLASSIFIED FIRE PROTECTIVE COATING WITH A FLAME SPREAD RATING OF LESS THAN 25, AND A SMOKE DENSITY OF LESS THAN 50.
  - COLOUR: AS SPECIFIED BY CUSTOMER. - IVORY/CHAMPAGNE 13-9108-11
  - LIVE LOAD: 35 PSF
  - WIND LOAD: 10 PSF
  - DEAD LOAD: 3 PSF
  - CANBAR RESERVES THE RIGHT TO MODIFY ANY NON-CRITICAL DIMENSIONS TO CONFORM TO THE AVAILABILITY OF MOULDS AT THE TIME OF FABRICATION.
  - TANK WALL TO CONTAIN ALL REACTIONS EXERTED BY THE COVER UNDER THE SPECIFIED LOADS.
  - SEE DRAWINGS CBF-0227 AND CBF-0228 FOR DOME COVER DETAILS.
  - SEE DRAWING CBF-0229 FOR VORTEX COVER DETAILS.

*why is this offset?  
Entrance should align*

SHOP DRAWINGS REVIEWED BY  
 FOR KRAFT CONSTRUCTION  
 DATE JUN 10 1992

**RECEIVED**  
 JUN 15 1992  
 R. C. & P. LTD.

**-SECONDARY CLARIFIER No.2 PLAN-**  
 SCALE 3/32"=1'-0"

FOR DORMER AND DUCTING ORIENTATION OF OTHER (3) COVERS SEE ABOVE GENERAL PLAN

THIS DOCUMENT IS THE PROPERTY OF CANBAR INC. AND SHALL NOT BE REPRODUCED, COPIED OR MADE AVAILABLE TO OTHERS WITHOUT PRIOR WRITTEN CONSENT OF CANBAR INC.

NO.	DATE	REVISION	BY
<b>CANBAR INC.</b> - WATERLOO ONTARIO CANADA -			
DIVISION PLASTICS AND COMPOSITES		SCALE SHOWN	DATE APR 28/92
TITLE (4) 98'-5" DIA. FRP DOME STYLE COVERS		DRN BY SPB	CH'D BY
CUSTOMER THE CITY OF WINNIPEG - WEST END W.P.C.C.		DRWG NO. CBF-0226	01