


5	YY.MM.DD	-
4	YY.MM.DD	-
3	YY.MM.DD	-
2	YY.MM.DD	-
1	13. 01. 18	ISSUED FOR CONSTRUCTION
No.	DATE	REVISION / ISSUANCE

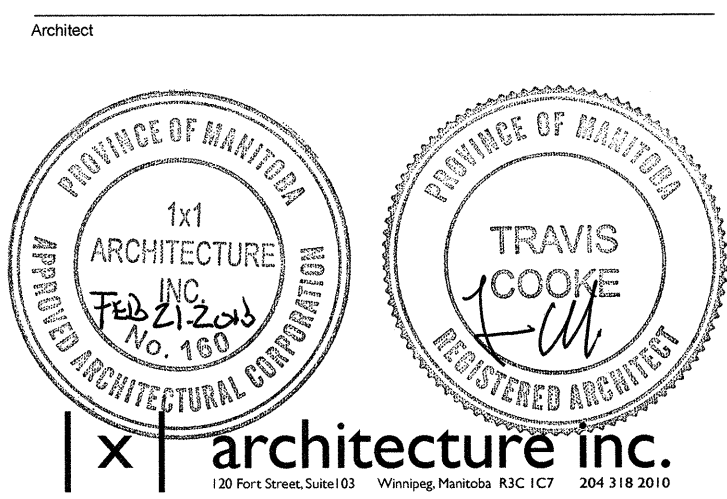

Project: BID OPPORTUNITY 931 - 2012

Seven Oaks Pool
Front Entrance Upgrades
444 ADSUM DRIVE

Sheet Title: **WALL SECTIONS AND DETAILS**

Project No. 1125

Date: FEBRUARY 21, 2013

A1.5