




PLAN AT FOOTING
SCALE 1:50

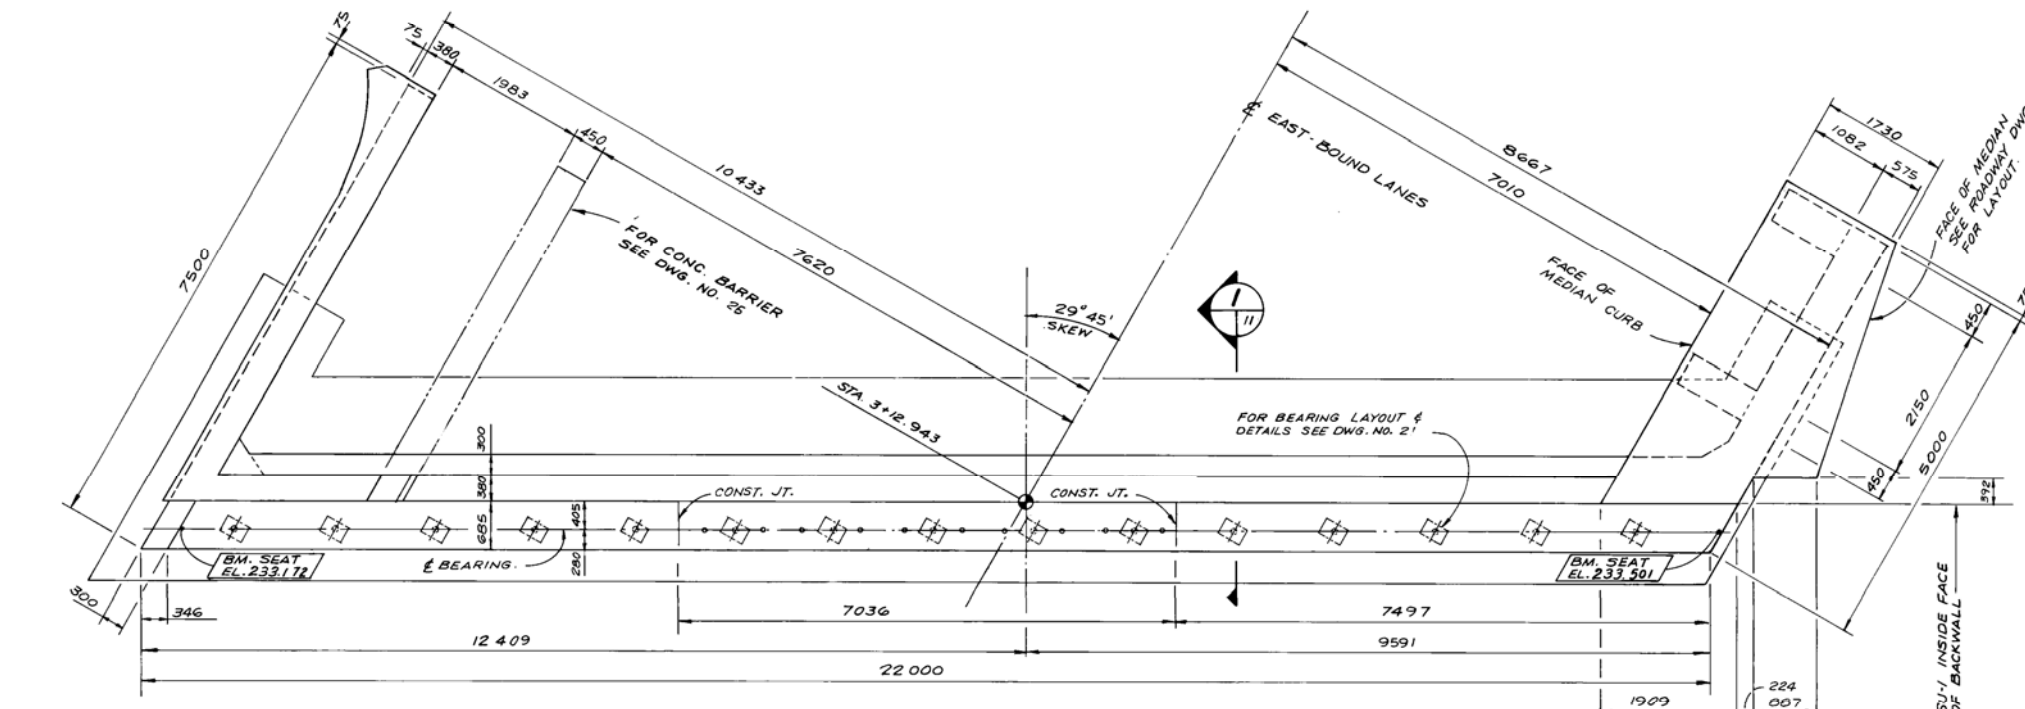

PLAN AT TOP
SCALE 1:50

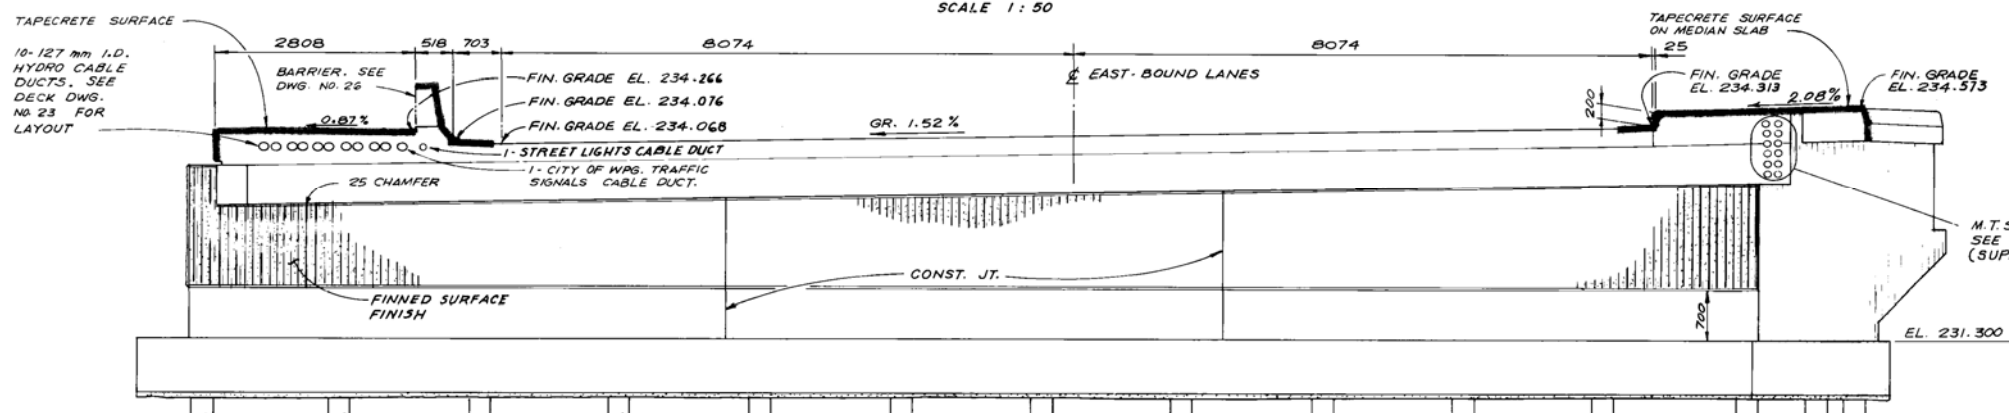

FRONT ELEVATION
SCALE 1:50

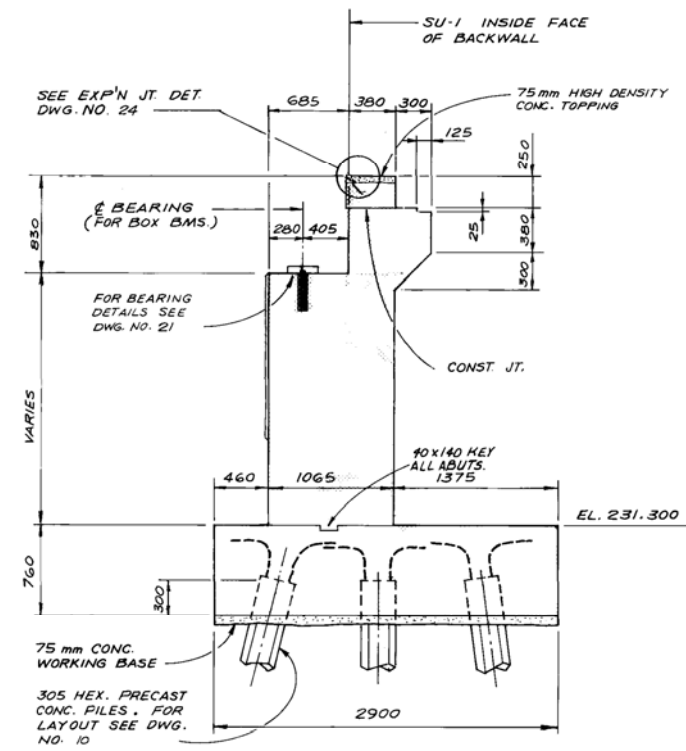

SECTION I
SCALE 1:30

AS BUILT
APPROVED BY: *[Signature]*

- GENERAL NOTES**
1. ALL EXPOSED EDGES SHALL BE CHAMFERED 19mm EXCEPT WHERE SHOWN OTHERWISE.
 2. CONCRETE CLEAR COVER TO REINFORCING STEEL SHALL BE: 75 mm FOR FOOTING, 50 mm FOR ALL OTHERS.
 3. 13 mm FLEXCELL SHALL BE PLACED ON VERTICAL FACES OF CURB JOINTS.

B-5397

23/9/60 CID 23/9/60 NBU	Consulting Engineers & Planners N.B.U. W.P.S. L.D.M. 80-08-25	THE CITY OF WINNIPEG WORKS & OPERATIONS STREETS & TRANSPORTATION	STURGEON CREEK BRIDGE ON PORTAGE AVENUE SOUTH STRUCTURE WEST ABUTMENT SU-1 CONCRETE
			AUTHORIZED BY: <i>[Signature]</i> DATE: 24-10-61 ACCEPTED BY: <i>[Signature]</i> DATE: 24-10-61 AS NOTED B178-80-11