




SOUTH STRUCTURE DECK PLAN

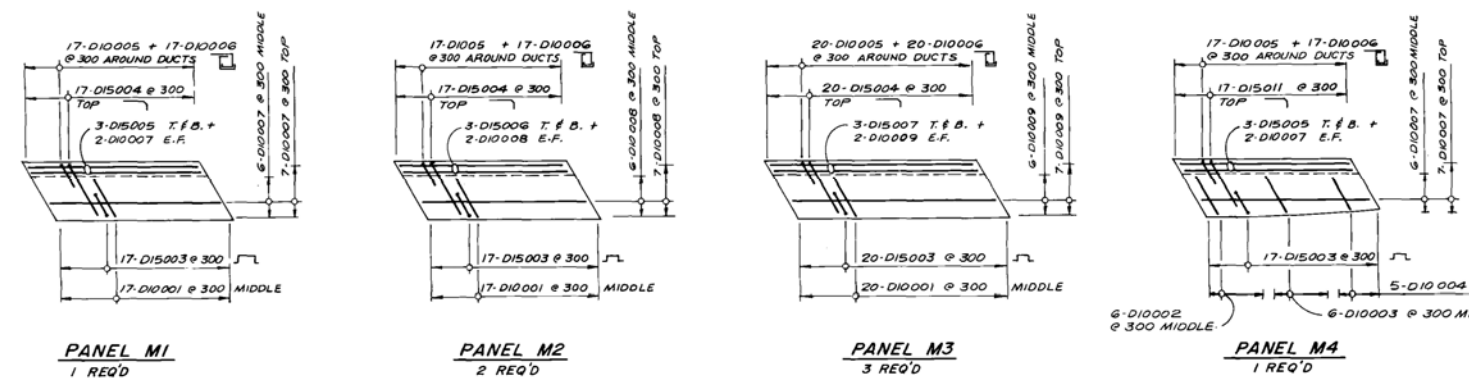

MEDIAN REINFORCING

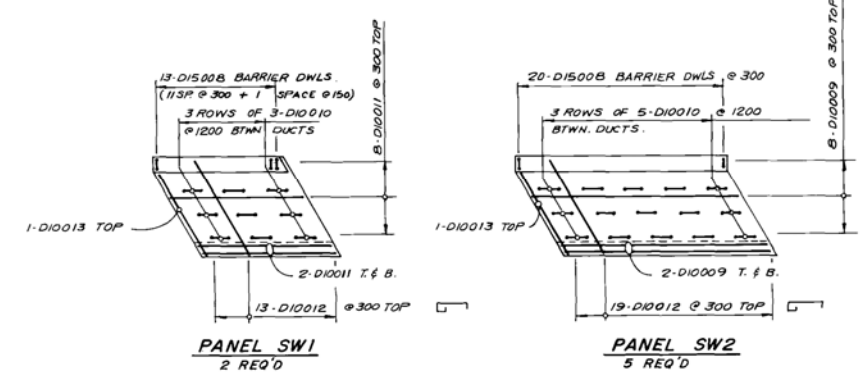

SIDEWALK REINFORCING

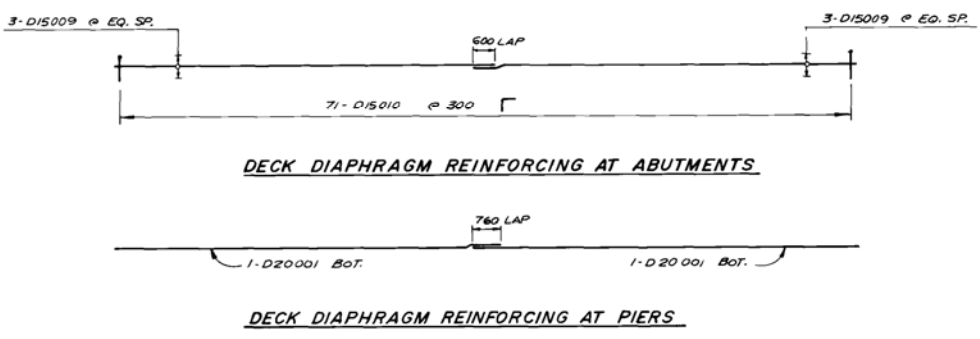

NOTE
ALL REBAR IN DECK, SIDEWALK & MEDIAN SHALL BE EPOXY COATED.

AS BUILT
DATE: 2/10/10

B-5408

NO.	REV.	DATE	BY

Consulting Engineers & Planners
DILLON

DESIGNED BY: F.A.K. CHECKED BY: W.P.S.
L.D.M. 80-08-25

DATE: 2/10/10

THE CITY OF WINNIPEG
WORKS & OPERATIONS
STREETS & TRANSPORTATION

STURGEON CREEK BRIDGE ON PORTAGE AVENUE
SOUTH STRUCTURE DECK PLAN CONCRETE & REINFORCEMENT

AUTHORIZED BY: [Signature] DATE: 1/10/10
ACCEPTED BY: [Signature] DATE: 2/10/10

1:100
B178-80-22